
WWTP PRIMARY DIGESTER IMPROVEMENTS


CITY OF ELK RIVER

ELK RIVER, MINNESOTA **APRIL 2004**

VICINITY MAP

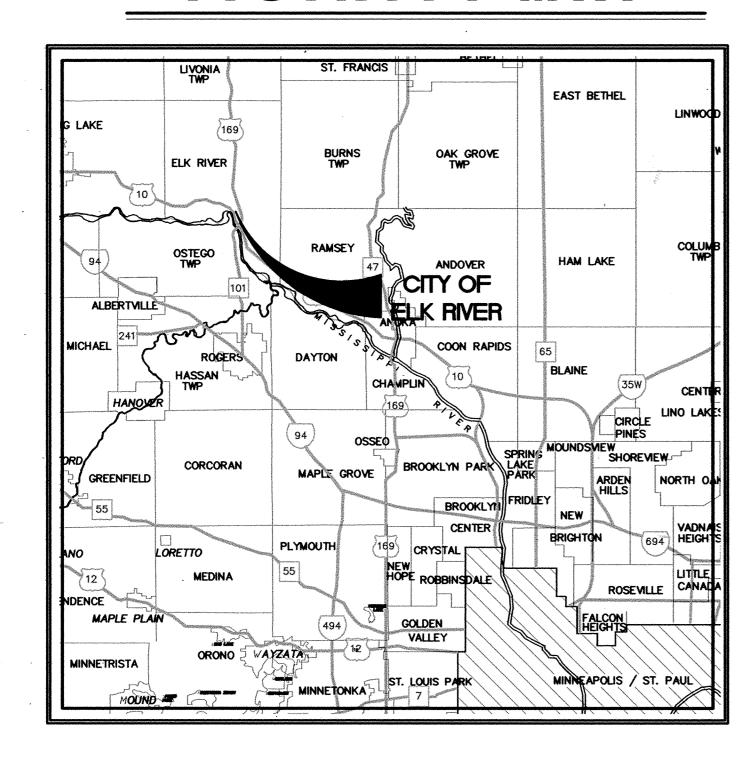

LOCATION MAP

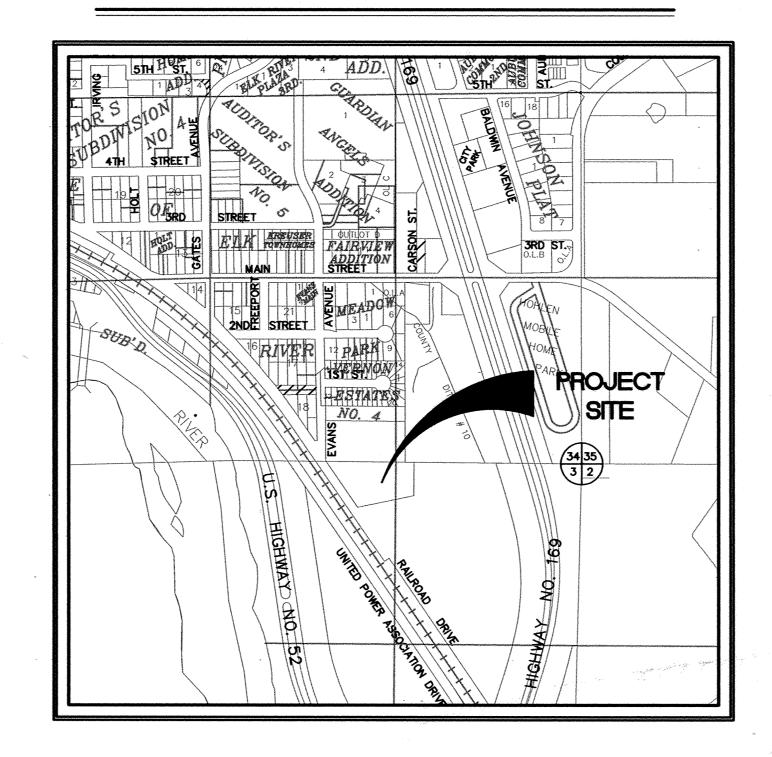

SHEET INDEX

G-1 COVER, INDEX, LOCATION MAP

PRIMARY DIGESTER/DIGESTER BUILDING PLAN, SECTION, AND DETAILS

PRIMARY DIGESTER/DIGESTER BUILDING ROOF PLAN

SITE PLAN

PRIMARY DIGESTER/DIGESTER BUILDING COVER/UPPER LEVEL PLAN

PRIMARY DIGESTER/DIGESTER BUILDING LOWER LEVEL PLAN

ONE-LINE DIAGRAM AND MCC-3A ELEVATION

DETAILS

RECORD DRAWING

CONSTRUCTION AS BASED UPON BEST RECORDED INFORMATION AT THE TIME OF COMPLETION OF WORK SET FORTH ON THE DRAWING.

HOWARD R. GREEN COMPANY SHALL NOT BE RESPONSIBLE FOR ANY ERRORS OR OMISSIONS THAT MAY HAVE BEEN INCORPORATED AS A RESULT OF ERRONEOUS INFORMATION PROVIDED BY OTHERS.



DATE: MAY 2005



STATE OF MINNESOTA. JAMES R RASMUSSEN, P.E. REG.NO. 42052

I HEREBY CERTIFY THAT THIS PLAN, SPECIFICATION, OR REPORT WAS PREPARED BY ME OR UNDER MY DIRECT

SUPERVISION AND THAT I AM A DULY LICENSED PROFESSIONAL ENGINEER UNDER THE LAWS OF THE

Howard R. Green Company