

**RECORD DRAWING**


THIS DRAWING HAS BEEN REVISED TO REPRESENT THE RECORDS OF CONSTRUCTION AS BASED UPON BEST RECORDED INFORMATION AT THE TIME OF COMPLETION OF WORK SET FORTH ON THE DRAWING.

HOWARD R. GREEN COMPANY SHALL NOT BE RESPONSIBLE FOR ANY ERRORS OR OMISSIONS THAT MAY HAVE BEEN INCORPORATED AS A RESULT OF ERRONEOUS INFORMATION PROVIDED BY OTHERS.



DATE: MAY 2005

- NOTE:**
- CONTRACTOR SHALL TOUR SITE TO DETERMINE LOCATION FOR COVER ASSEMBLY AND COVER INSTALLATION EQUIPMENT.
  - OVERHEAD ELECTRIC IS LOCATED NORTH OF THE DIGESTERS.
  - COORDINATE LOCATION OF FIELD OFFICE WITH OWNER.
  - COORDINATE ON-SITE STORAGE AREA WITH OWNER.
  - COORDINATE CONTRACTOR PARKING AREA WITH OWNER.
  - COORDINATE TEMPORARY UTILITY LOCATIONS WITH OWNER.
  - CONTRACTOR SHALL RESTORE AND GRADE ALL DISTURBED AREAS AFTER CONSTRUCTION. OWNER TO PROVIDE SEEDING.

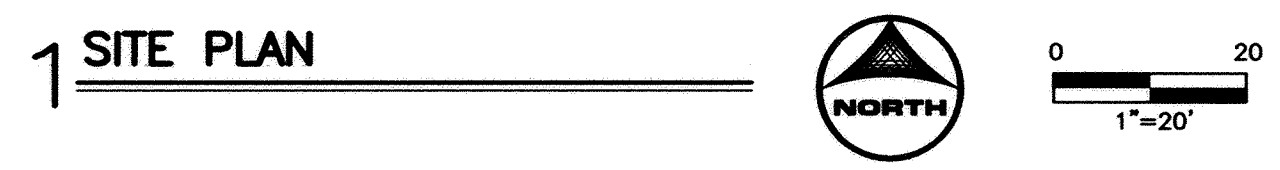

**1 SITE PLAN**

Project: XCS-SITE.DWG

DESIGNED BY: DRH	DRAWN BY: CRR
APPROVED BY: JRR	JOB NUMBER: 822550J
CAD DATE: June 29, 2006 2:41:30 p.m.	
CAD FILE: 822550J\As-Built\Drawgs\PA-P-4.DWG (JMESSE)	

I HEREBY CERTIFY THAT THIS PLAN, SPECIFICATION, OR REPORT WAS PREPARED BY ME OR UNDER MY DIRECT SUPERVISION AND THAT I AM A DULY LICENSED PROFESSIONAL ENGINEER UNDER THE LAWS OF THE STATE OF MINNESOTA.

SIGNATURE: \_\_\_\_\_ DATE: \_\_\_\_\_

PRINTED NAME: JAMES R. RASMUSSEN LIC. NO. 42052

NO.	DATE	BY	REVISION DESCRIPTION
1	05/24/05	DRH	RECORD DRAWINGS



**WWTP PRIMARY DIGESTER IMPROVEMENTS**  
**CITY OF ELK RIVER**  
 ELK RIVER, MINNESOTA 2004

PROCESS  
**SITE PLAN**

SHEET NO.  
**P-4**