

RECORD DRAWING

THIS DRAWING HAS BEEN REVISED TO REPRESENT THE RECORDS OF CONSTRUCTION AS BASED UPON BEST RECORDED INFORMATION AT THE TIME OF COMPLETION OF WORK SET FORTH ON THE DRAWING.

HOWARD R. GREEN COMPANY SHALL NOT BE RESPONSIBLE FOR ANY ERRORS OR OMISSIONS THAT MAY HAVE BEEN INCORPORATED AS A RESULT OF ERRONEOUS INFORMATION PROVIDED BY OTHERS.



DATE: MAY 2005

SITE PLAN

SCALE: 1"=20'

GENERAL NOTES:

- A. DUCTBANK ROUTING IS APPROXIMATE. COORDINATE WITH EXISTING UNDERGROUND UTILITIES. REFER TO PROJECT NO. 230-151, SHEET E2, DATED OCTOBER 1995.

ELECTRICAL NOTES:

- ① CONCRETE ENCASED DUCTBANK CONSISTING OF:
ONE - 3" C. FOR FEED TO MCC-A (DIGESTER BLDG.)
ONE - 2" C. FOR FUTURE FEED TO MCC-2 (PRETREATMENT BLDG.)
ONE - 2" C. FOR FUTURE DATA HIGHWAY.
- ② PRECAST POLYMER CONCRETE PULL BOX - QUAZITE PG SERIES BY STRONGWELL CORP. SEE DETAIL 3/E-5.
- ③ CONCRETE ENCASED DUCTBANK CONSISTING OF:
ONE - 3" C. FOR FEED TO MCC-3A (DIGESTER BLDG.)
ONE - 2" C. FOR FUTURE DATA HIGHWAY.


W:\pds\KCS-SITE.DWG

DESIGNED BY: RJT/WLM DRAWN BY: WLM
APPROVED BY: RJT JOB NUMBER 822550J
CAD DATE: August 30, 2005 8:39:25 a.m.
CAD FILE: 822550J\As-Built\Drawings\E-E-3.DWG (DHORNER)

I HEREBY CERTIFY THAT THIS PLAN, SPECIFICATION, OR REPORT WAS PREPARED BY ME OR UNDER MY DIRECT SUPERVISION AND THAT I AM A DULY LICENSED PROFESSIONAL ENGINEER UNDER THE LAWS OF THE STATE OF MINNESOTA.

SIGNATURE: _____ DATE: _____
PRINTED NAME: ROBERT J. THAYER LIC. NO. 16272

NO.	DATE	BY	REVISION DESCRIPTION
1	05/24/05	DRH	RECORD DRAWINGS

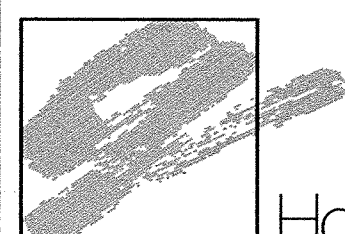

Howard R. Green Company

WWTP PRIMARY DIGESTER IMPROVEMENTS
CITY OF ELK RIVER
ELK RIVER, MINNESOTA 2004

ELECTRICAL
SITE PLAN

SHEET NO.

E-3