



NOTES:

1. TRANSFORMERS UP TO & INCLUDING 75KVA SHALL BE WALL MOUNTED.
2. TRANSFORMERS ABOVE 75KVA SHALL BE FLOOR MOUNTED.

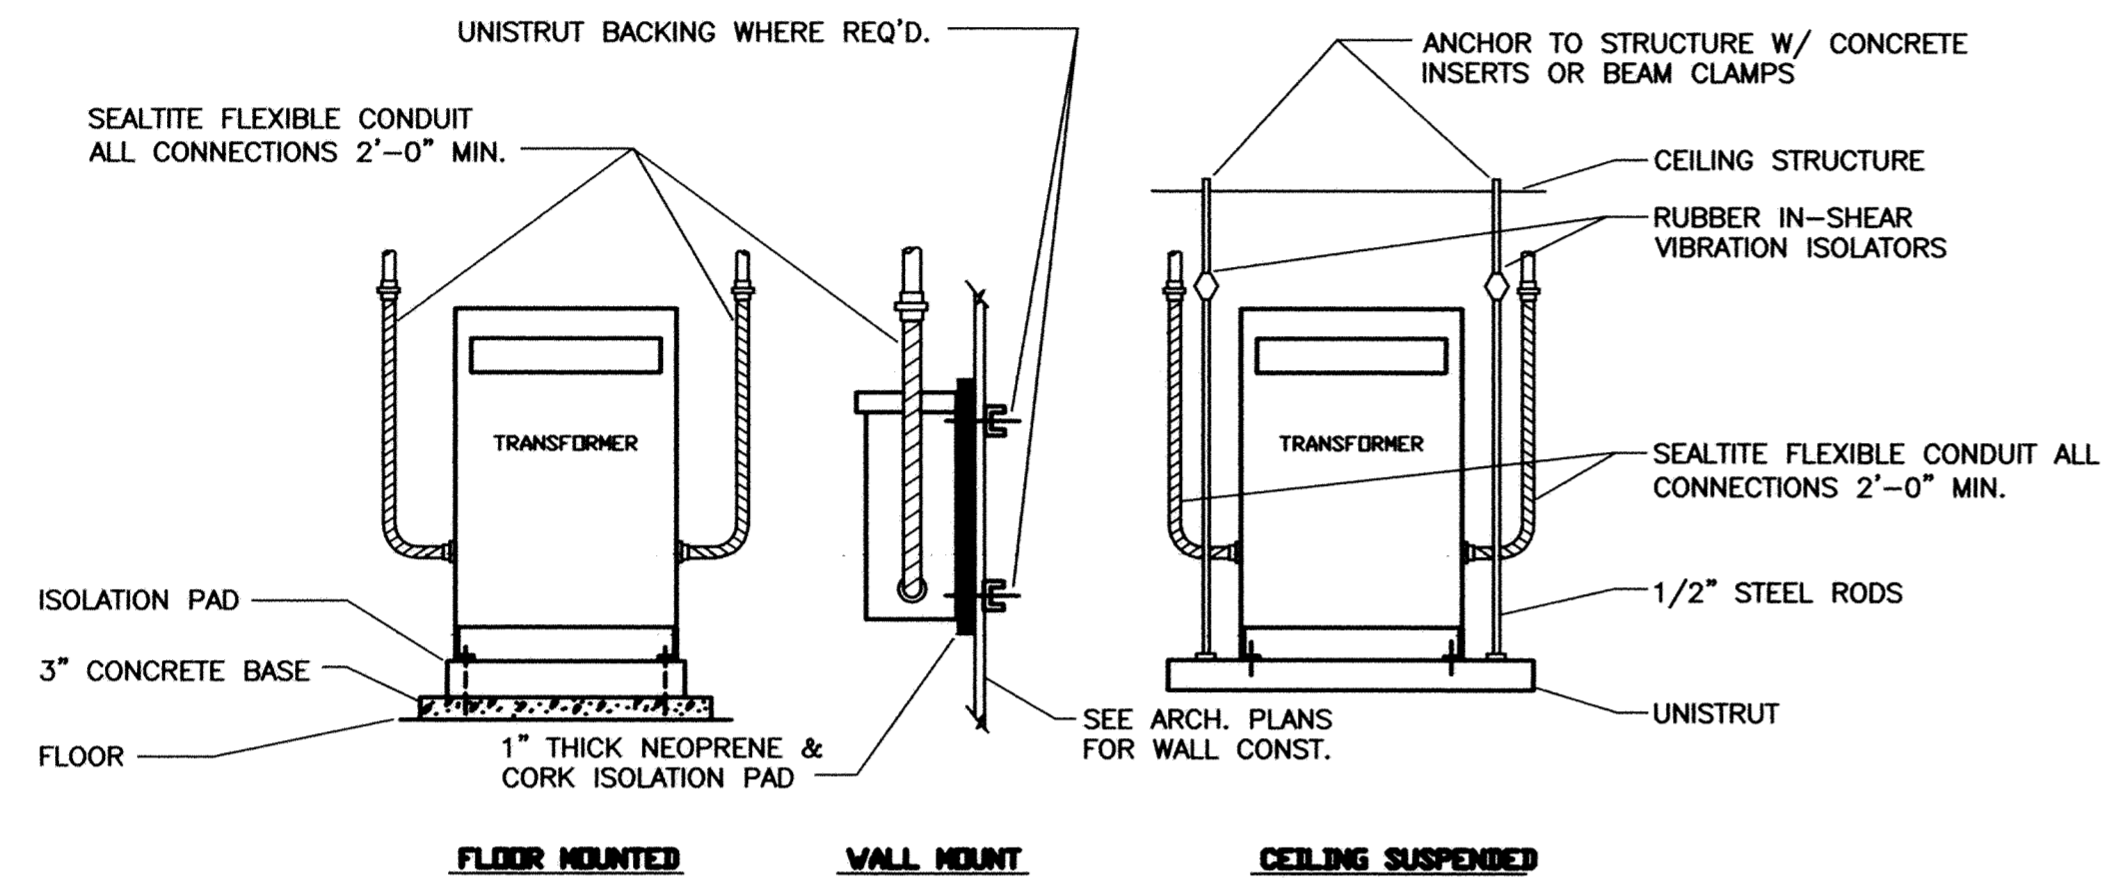


1 DRY TYPE TRANSFORMER MOUNTING & CONNECTION DETAIL

SCALE: NONE

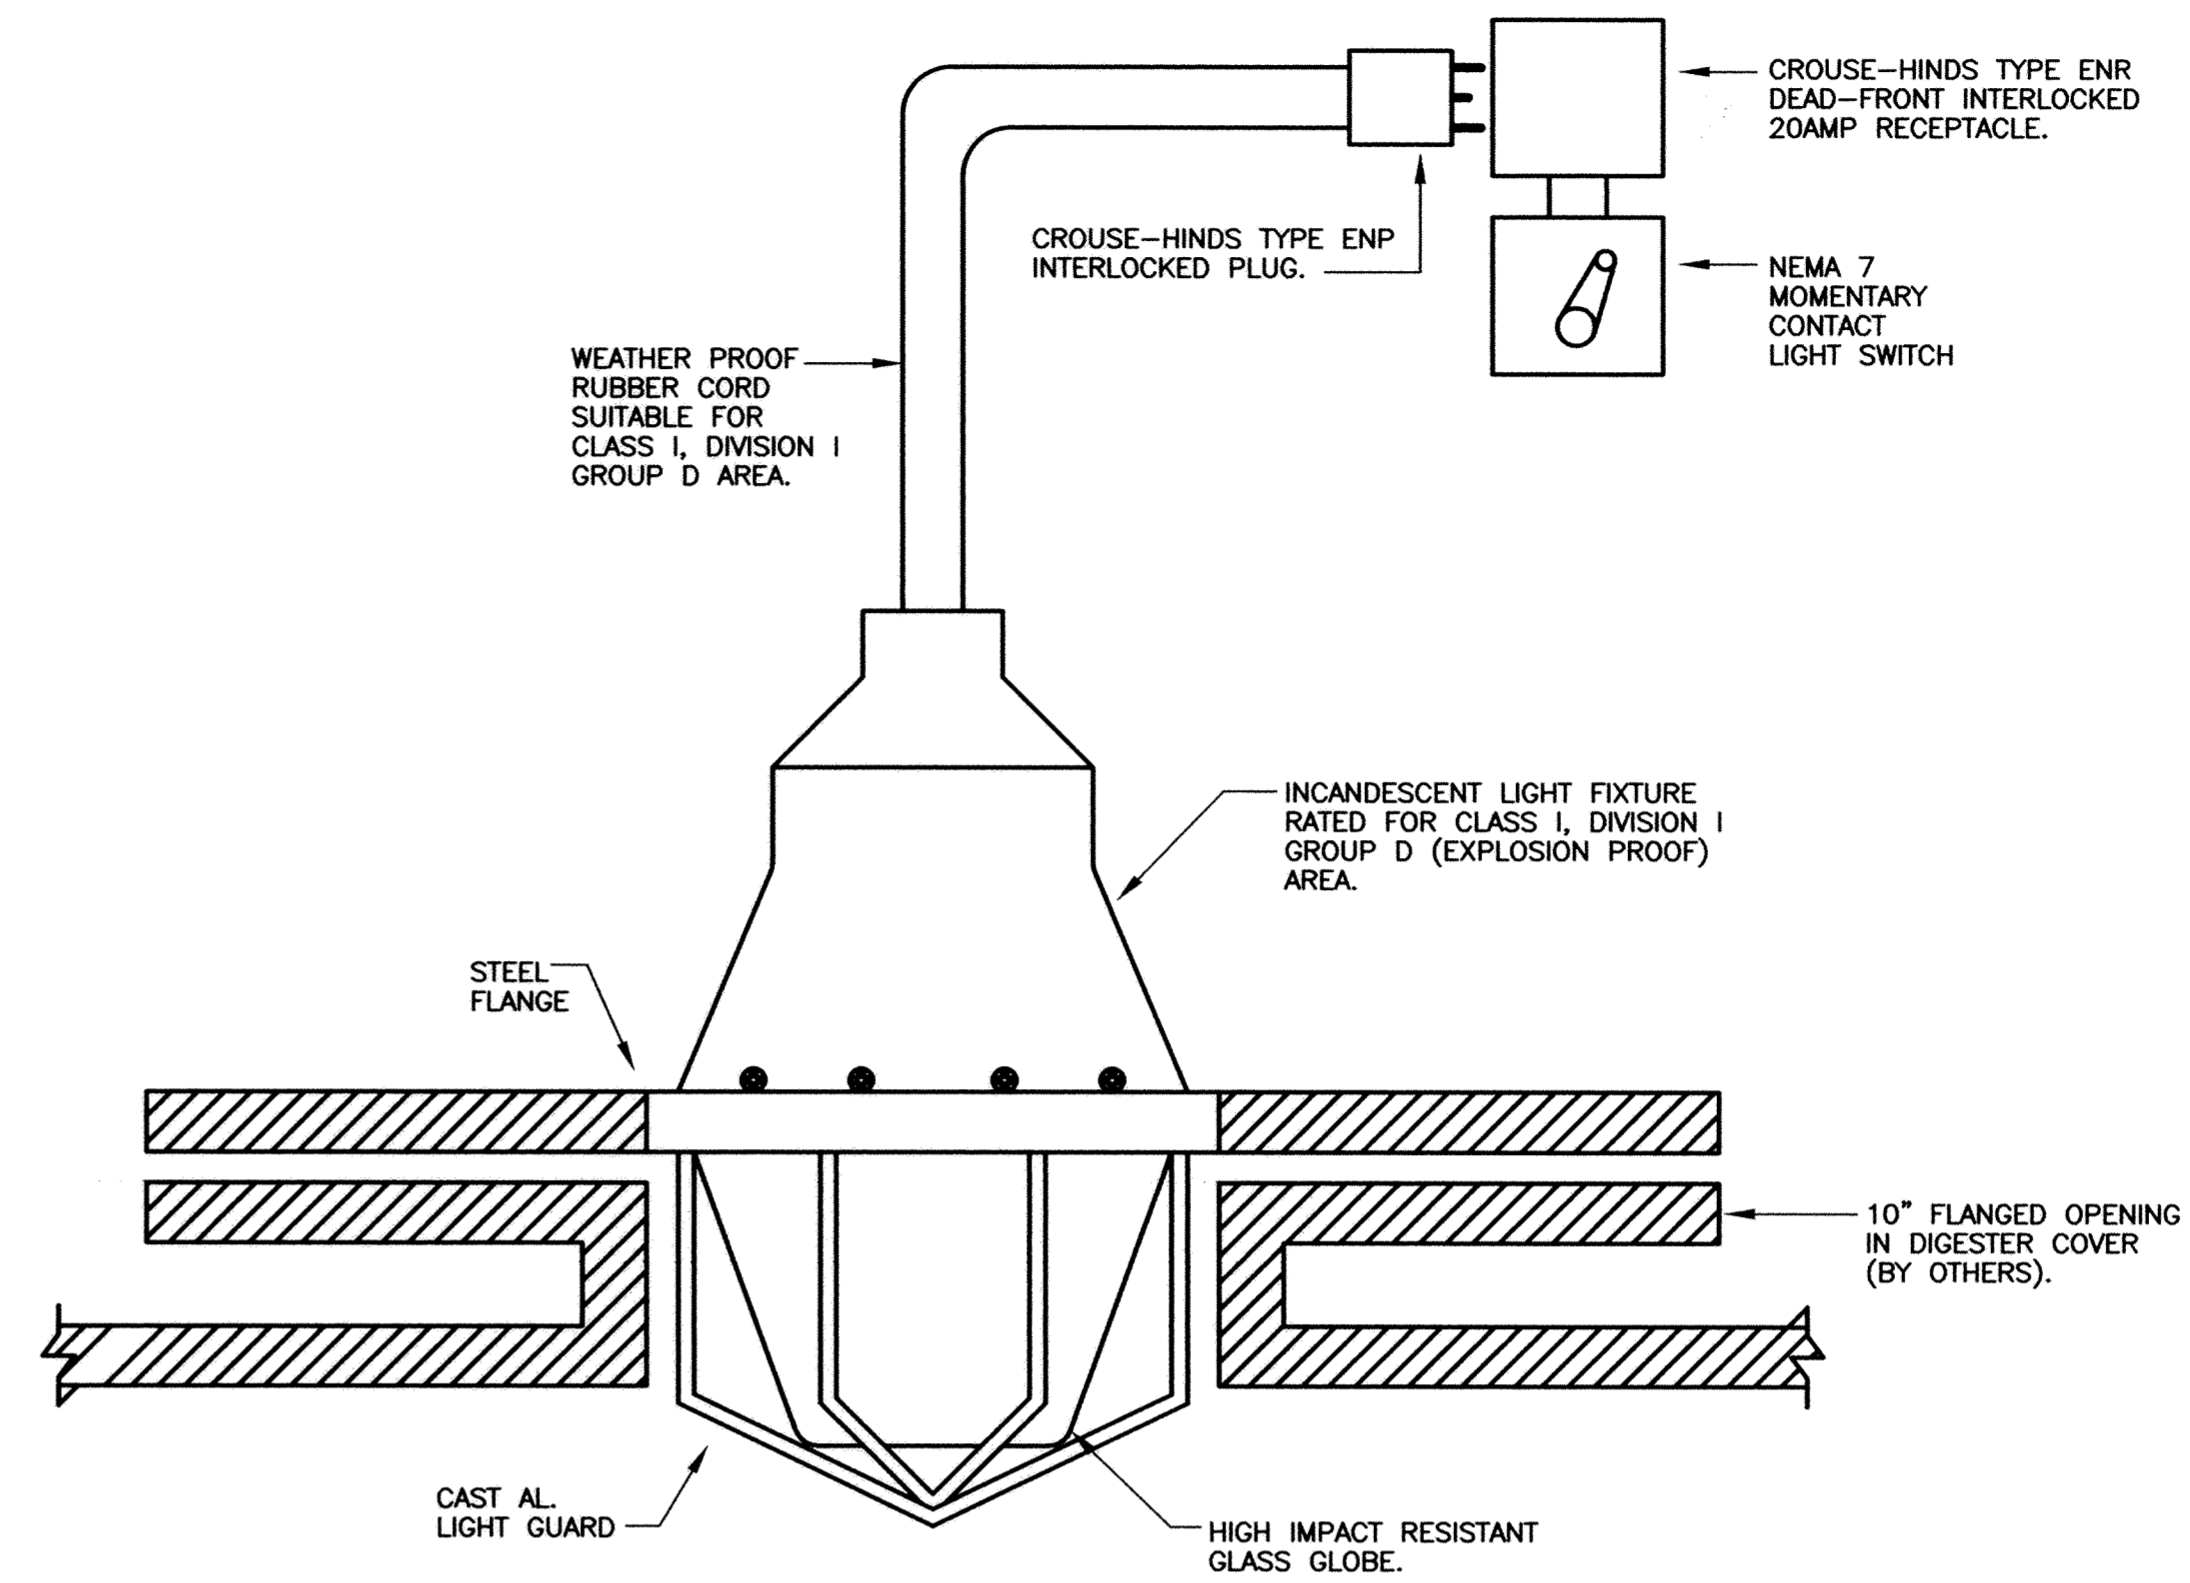

2 LIGHT FIXTURE DETAIL

SCALE: NONE

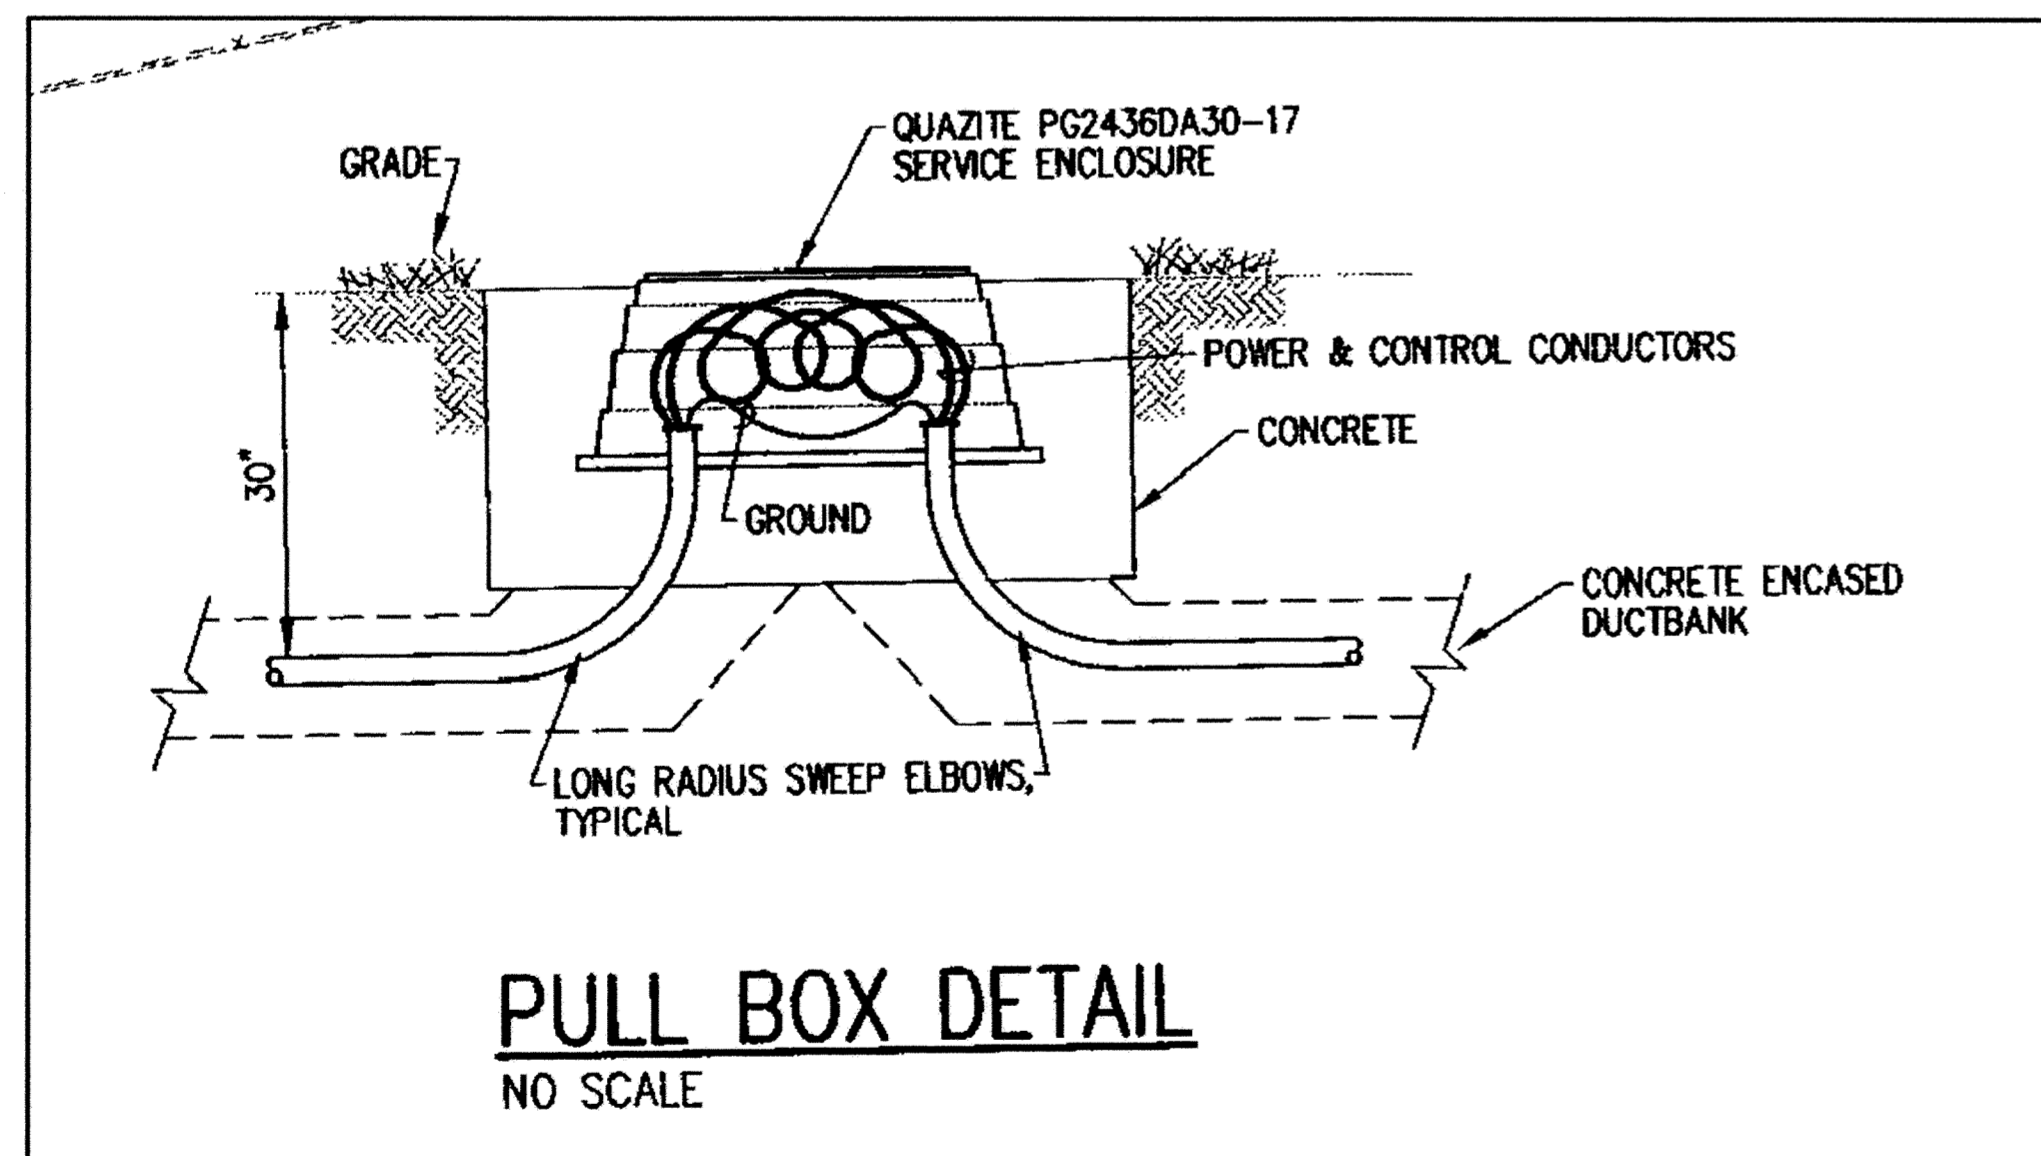

PULL BOX DETAIL

NO SCALE

3 UNDERGROUND PULLBOX DETAIL

SCALE: NONE

RECORD DRAWING

THIS DRAWING HAS BEEN REVISED TO REPRESENT THE RECORDS OF CONSTRUCTION AS BASED UPON BEST RECORDED INFORMATION AT THE TIME OF COMPLETION OF WORK SET FORTH ON THE DRAWING.

HOWARD R. GREEN COMPANY SHALL NOT BE RESPONSIBLE FOR ANY ERRORS OR OMISSIONS THAT MAY HAVE BEEN INCORPORATED AS A RESULT OF ERRONEOUS INFORMATION PROVIDED BY OTHERS.


 Howard R. Green Company

DATE: MAY 2005

DESIGNED BY: RJT/WLM DRAWN BY: WLM
 APPROVED BY: RJT JOB NUMBER 822550J
 CAD DATE: August 30, 2005 8:40:12 a.m.
 CAD FILE: 822550J\As-Built\Drawgs\E-E-5.DWG (DHORNER)

I HEREBY CERTIFY THAT THIS PLAN, SPECIFICATION, OR REPORT WAS PREPARED BY ME OR UNDER MY DIRECT SUPERVISION AND THAT I AM A DULY LICENSED PROFESSIONAL ENGINEER UNDER THE LAWS OF THE STATE OF MINNESOTA.
 SIGNATURE _____ DATE _____
 PRINTED NAME ROBERT J. THAYER LIC. NO. 16272

NO.	DATE	BY	REVISION DESCRIPTION
1	05/24/05	DRH	RECORD DRAWINGS

 Howard R. Green Company

WWTP PRIMARY DIGESTER IMPROVEMENTS
 CITY OF ELK RIVER
 ELK RIVER, MINNESOTA 2004

ELECTRICAL
 DETAILS

SHEET NO.

E-5