

**RECORD DRAWING**

THIS DRAWING HAS BEEN REVISED TO REPRESENT THE RECORDS OF CONSTRUCTION AS BASED UPON BEST RECORDED INFORMATION AT THE TIME OF COMPLETION OF WORK SET FORTH ON THE DRAWING.

HOWARD R. GREEN COMPANY SHALL NOT BE RESPONSIBLE FOR ANY ERRORS OR OMISSIONS THAT MAY HAVE BEEN INCORPORATED AS A RESULT OF ERRONEOUS INFORMATION PROVIDED BY OTHERS.

DATE: MAY 2005


Howard R. Green Company

DESIGNED BY: RJT/WLM    DRAWN BY: WLM  
 APPROVED BY: RJT    JOB NUMBER: 822550J  
 CAD DATE: June 29, 2006 3:39:51 p.m.  
 CAD FILE: 822550J\As-Built\Dwgs\E\E-7.DWG (JMESS)

I HEREBY CERTIFY THAT THIS PLAN, SPECIFICATION, OR REPORT WAS PREPARED BY ME OR UNDER MY DIRECT SUPERVISION AND THAT I AM A DULY LICENSED PROFESSIONAL ENGINEER UNDER THE LAWS OF THE STATE OF MINNESOTA.

SIGNATURE: \_\_\_\_\_ DATE: \_\_\_\_\_  
 PRINTED NAME: ROBERT J. THAYER    LIC. NO.: 16272

NO.	DATE	BY	REVISION DESCRIPTION
1	05/24/05	DRH	RECORD DRAWINGS

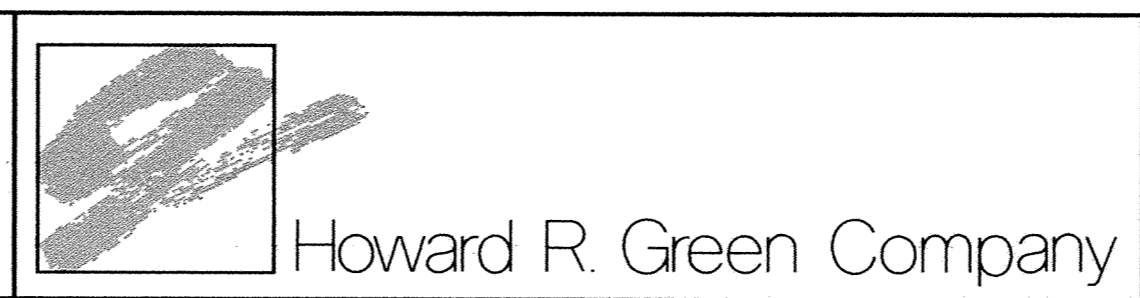

**WWTP PRIMARY DIGESTER IMPROVEMENTS**  
 CITY OF ELK RIVER  
 ELK RIVER, MINNESOTA 2004

ELECTRICAL  
 DETAILS

SHEET NO.  
**E-7**