


SANITARY SEWER AND WATERMAIN **IMPROVEMENTS**

XENIA AVENUE SIXTH LANE SIMONET DRIVE

I HEREBY CERTIFY THAT THIS PLAN, SPECIFICATION, OR REPORT WAS PREPARED BY ME OR UNDER MY DIRECT SUPERVISION AND I AM A DULY REGISTERED PROFESSIONAL ENGINEER UNDER THE LAWS OF THE STATE OF MINNESOTA.

Terry J. Maure

DATE 3/5/86 MINNESOTA REGISTRATION NO. 153/6

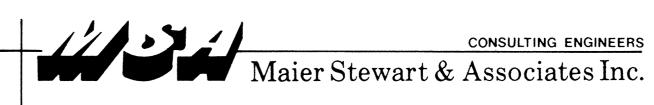

480 CEDAR STREET

(612)227-9475

ST. PAUL, MINNESOTA 55101



RECORD PLAN OCT 1986

137