
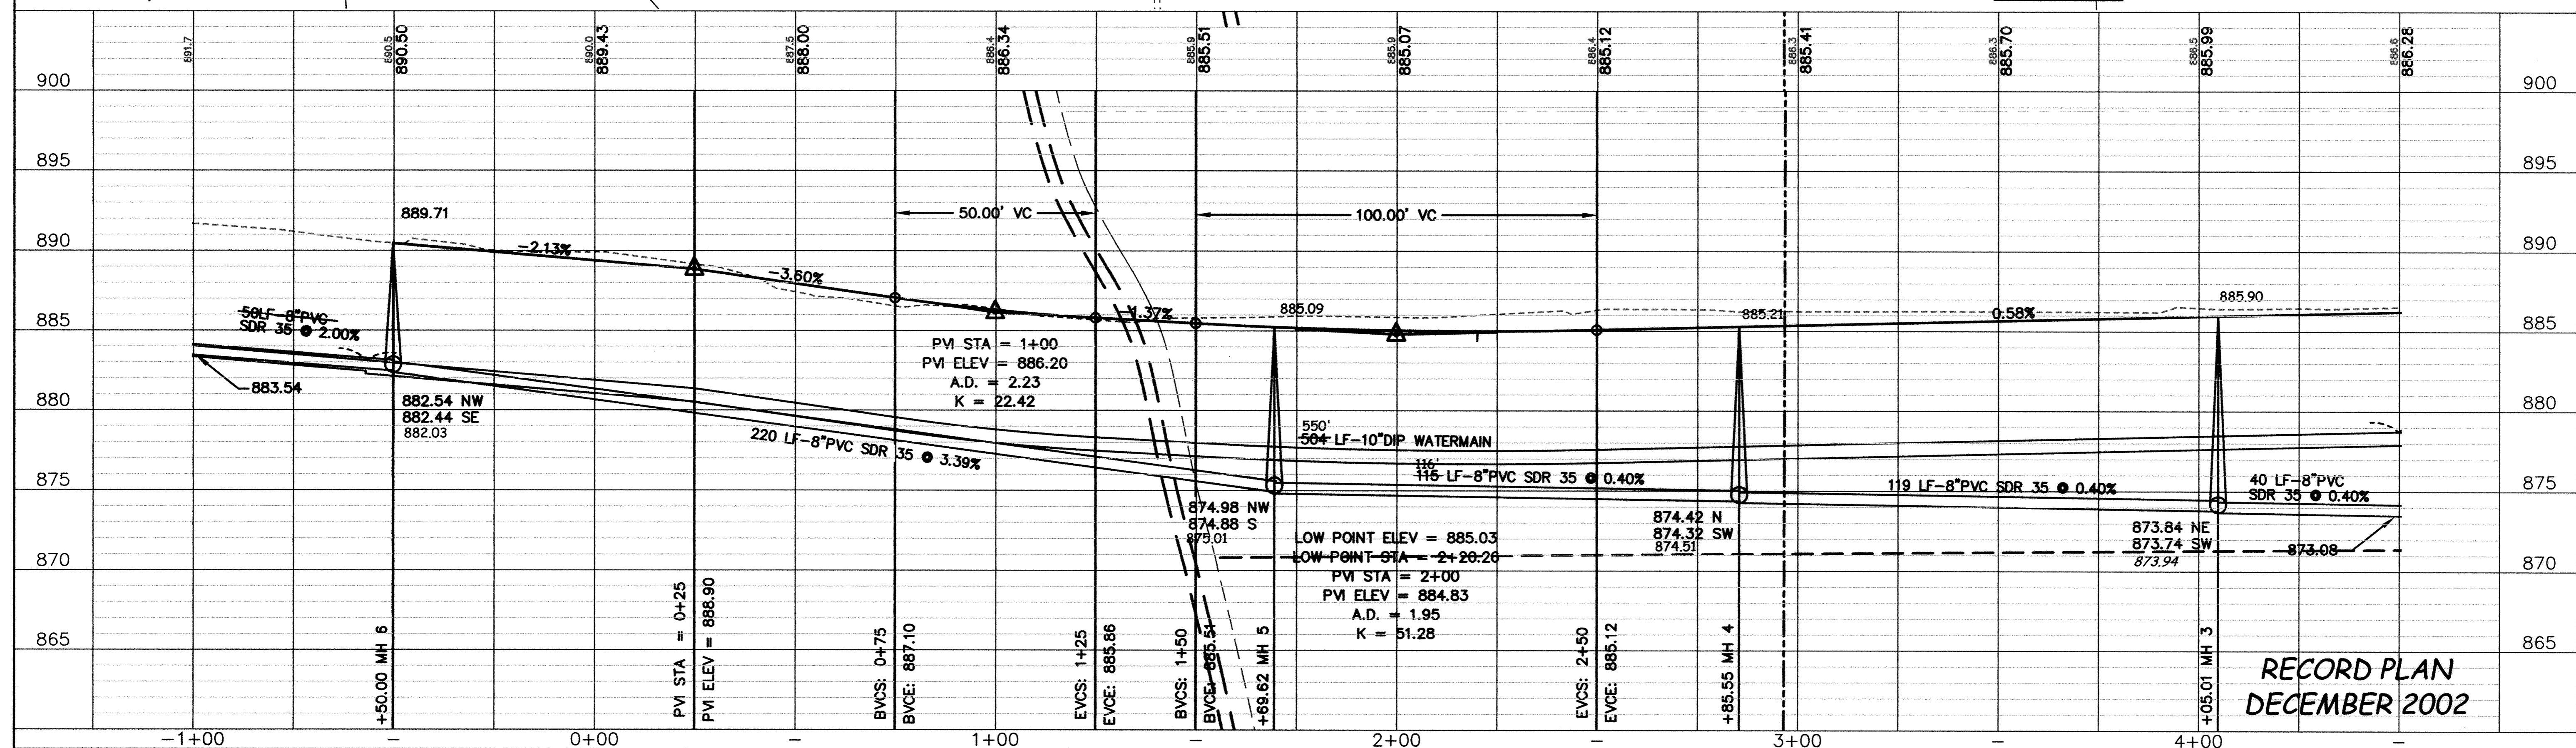
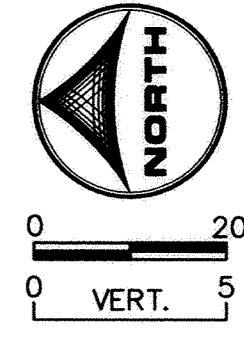


# ZANE AVENUE

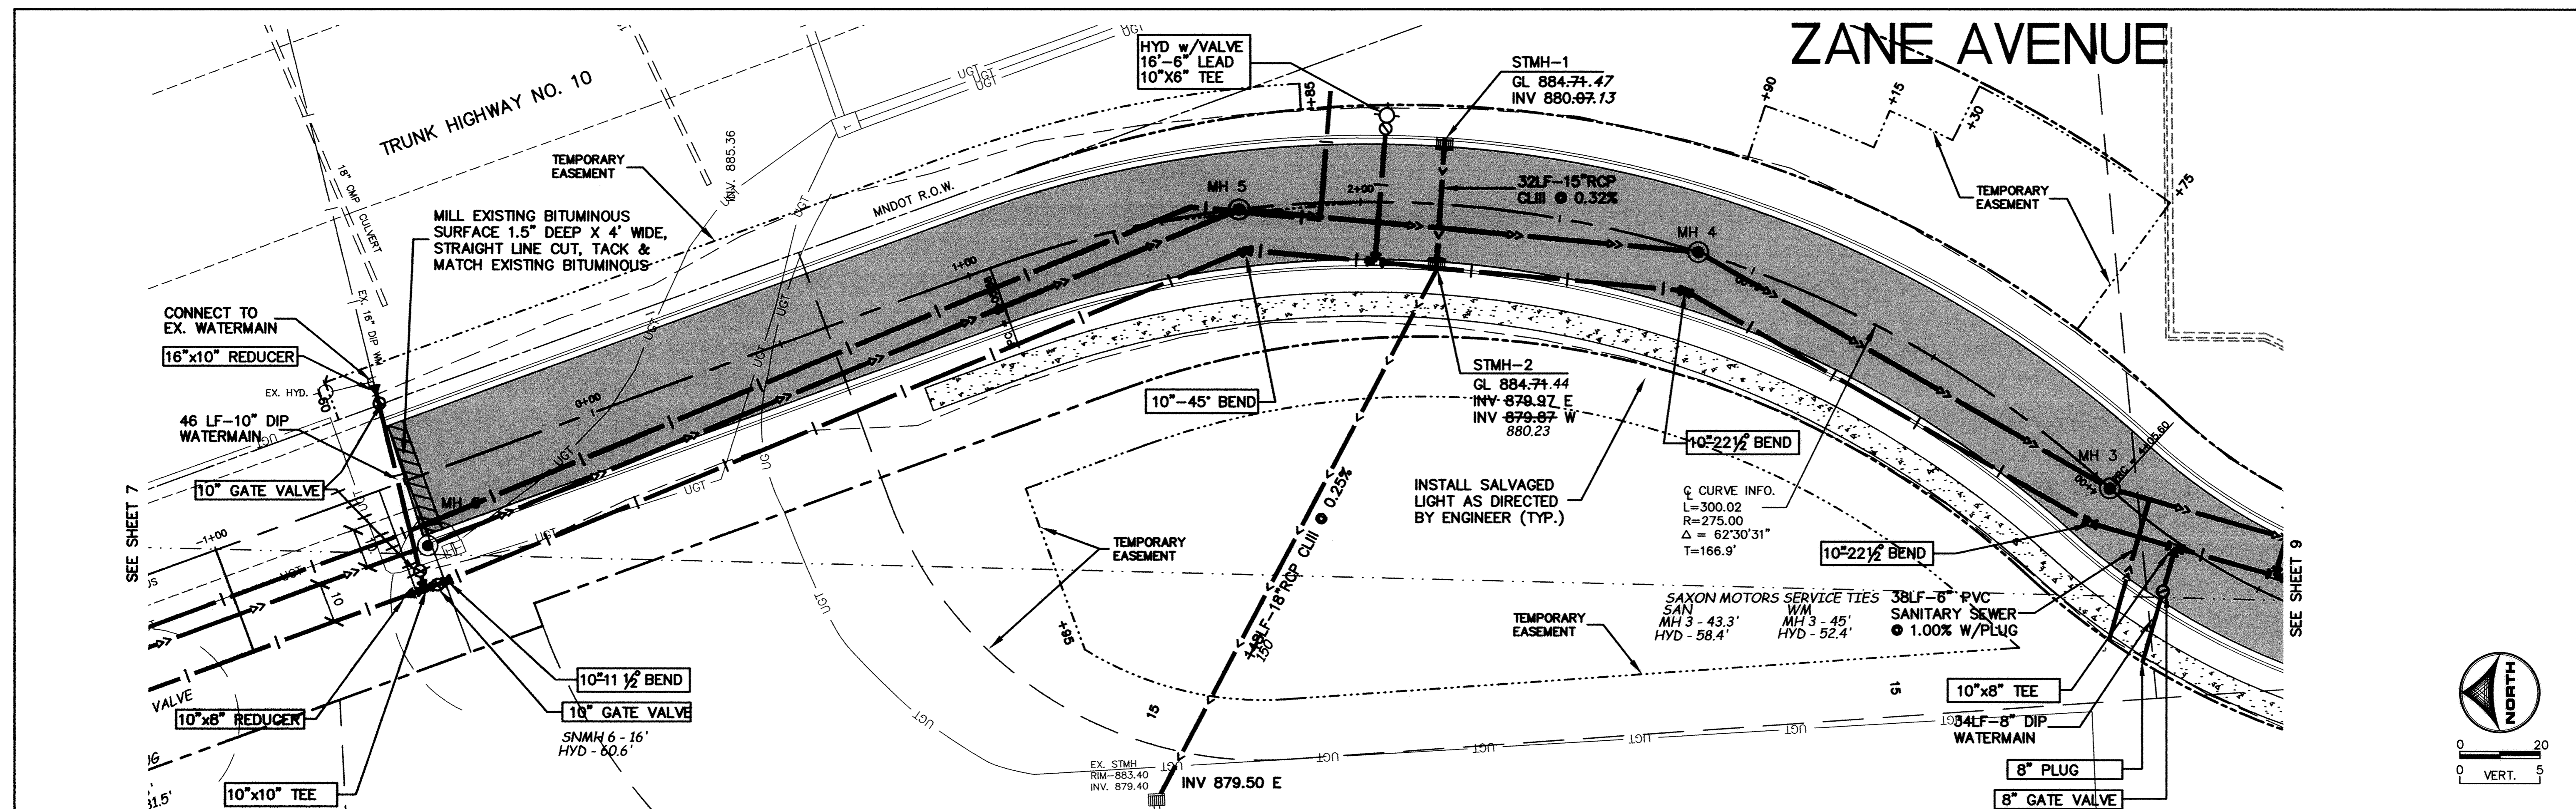

RECORD PLAN  
DECEMBER 2002

DESIGNED BY: KT/EY      DRAWN BY: EY  
 APPROVED BY: \_\_\_\_\_      JOB NUMBER: 815640J  
 CAD DATE: January 09, 2003 10:20:24 a.m.  
 CAD FILE: 815640\dwg\815640B.DWG (JLALLEN)

I HEREBY CERTIFY THAT THIS PLAN, SPECIFICATION, OR REPORT WAS PREPARED BY ME OR UNDER MY DIRECT SUPERVISION AND THAT I AM A DULY LICENSED PROFESSIONAL ENGINEER UNDER THE LAWS OF THE STATE OF MINNESOTA.

SIGNATURE: \_\_\_\_\_      DATE: \_\_\_\_\_  
 PRINTED NAME: TERRY J. MAURER      LIC. NO.: 15316

NO.	DATE	BY	REVISION DESCRIPTION
1	6/20/02	JRC	Watermain Revisions

1326 ENERGY PARK DRIVE  
 ST. PAUL, MINNESOTA 55108  
 (612) 644-4389

**Howard R Green Company**  
 CONSULTING ENGINEERS

ZANE AVENUE IMPROVEMENTS  
 CITY OF ELK RIVER

S.P. 7101-56  
 ZANE AVENUE  
 STA. -1+00 TO STA. 4+50

SHEET NO.  
**8**