
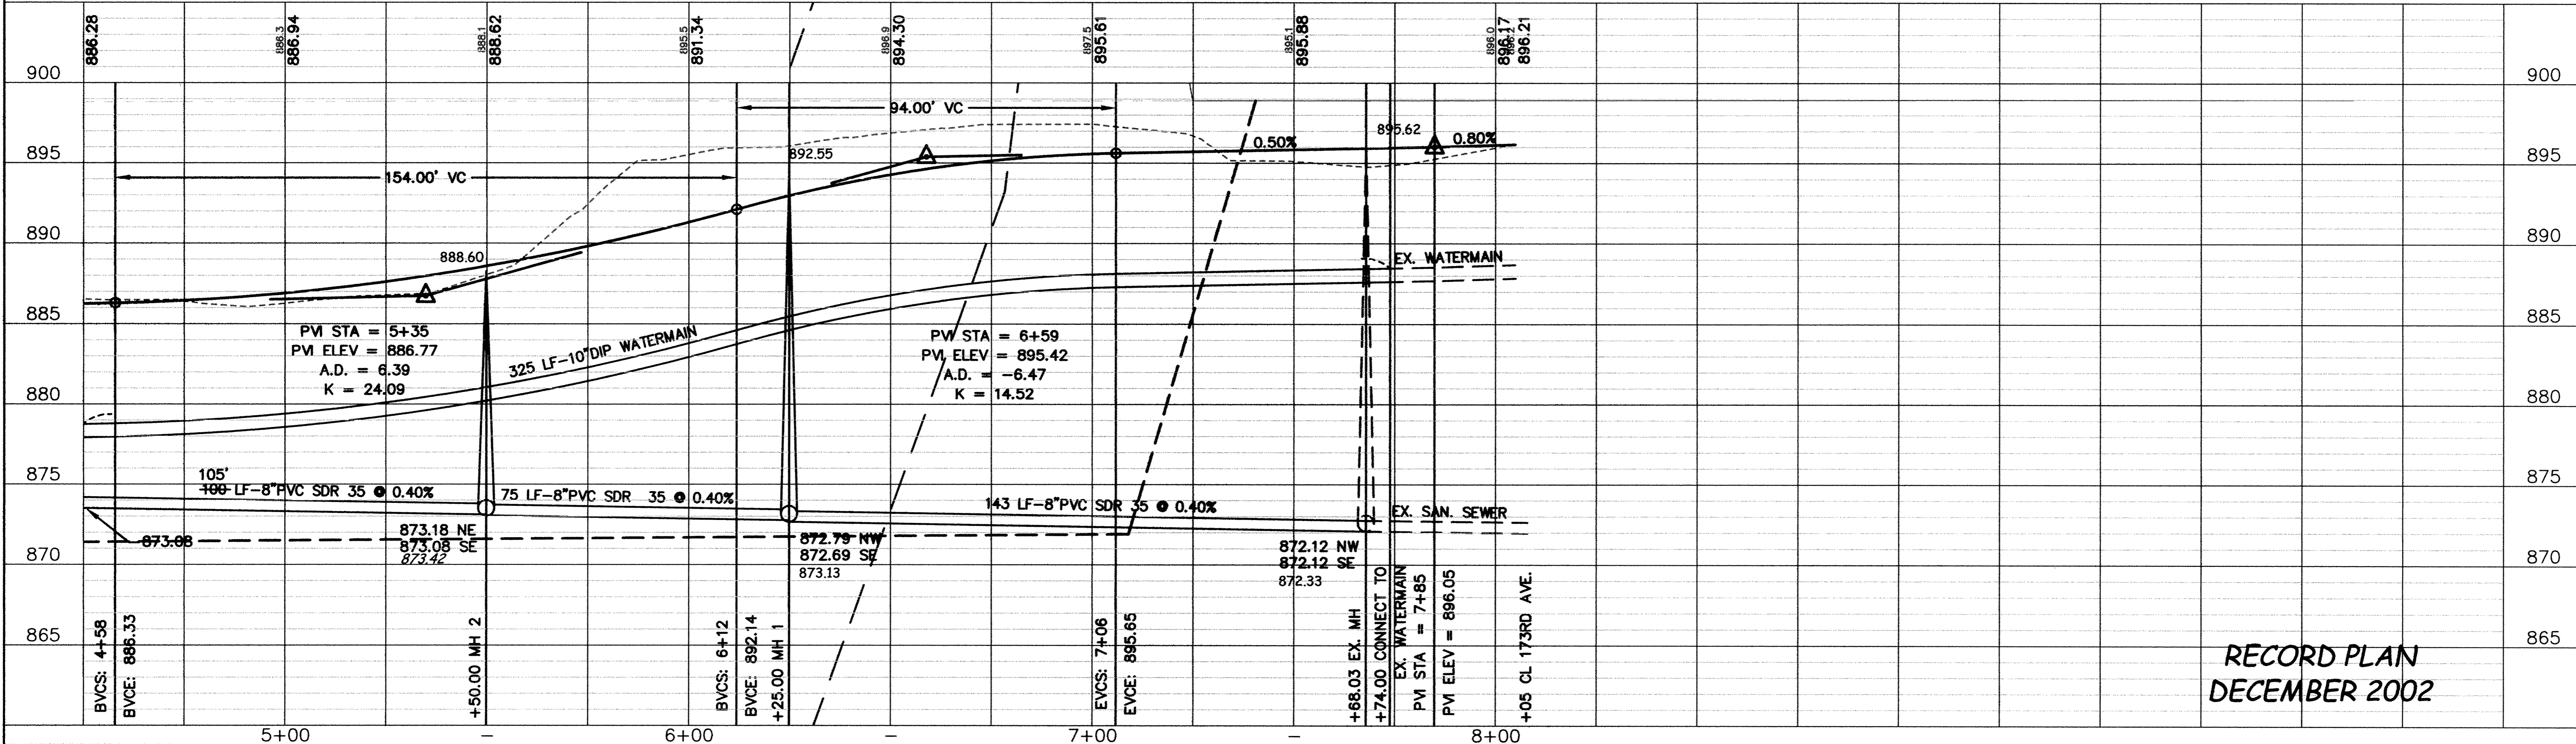
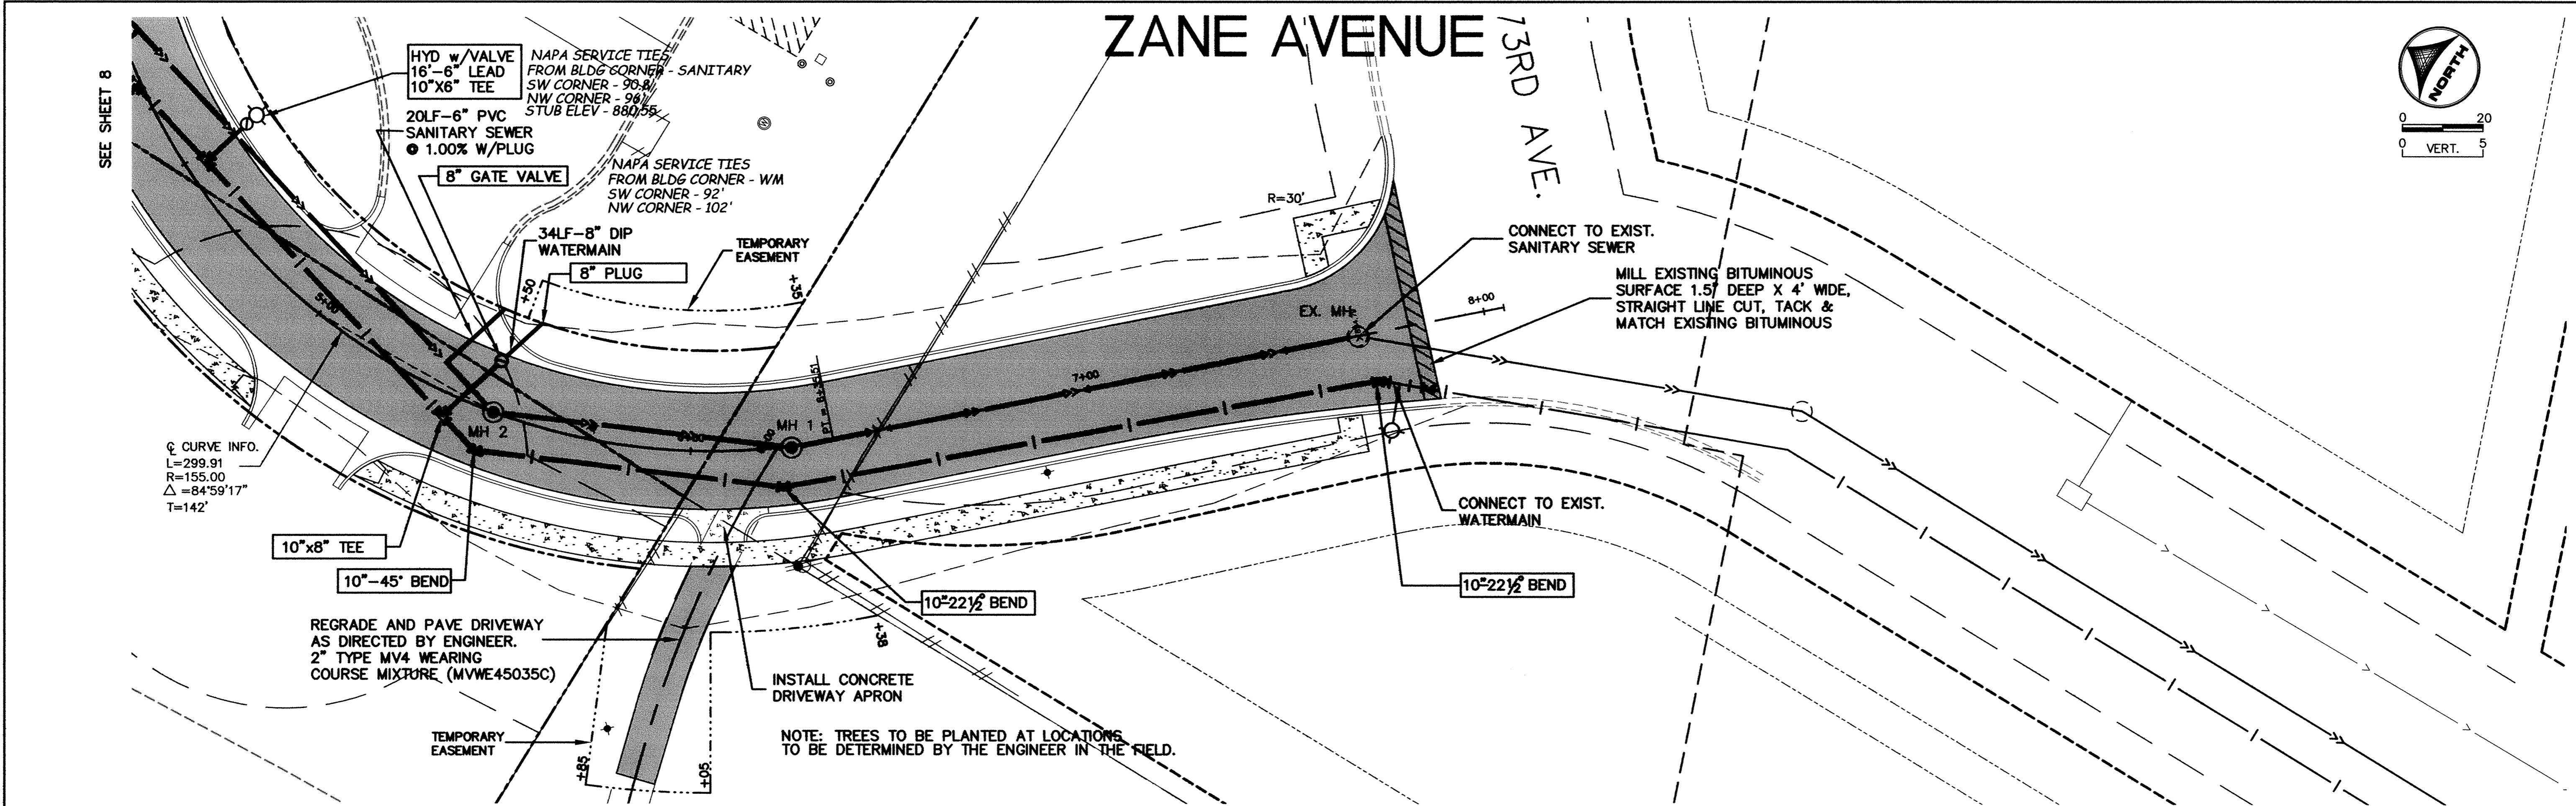


SARCO PRODUCTS • NEW HOPE, MINNESOTA
REQUESTED BY PART NUMBER 8552
PREPARED BY PART NUMBER 1111

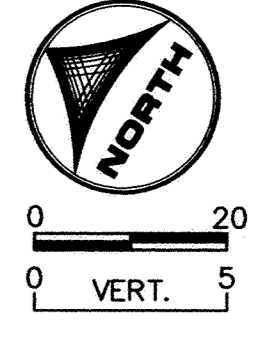

RECORD PLAN
DECEMBER 2002

DESIGNED BY: KT/EY DRAWN BY: EY
APPROVED BY: JOB NUMBER 815640J
CAD DATE: January 09, 2003 10:20:24 a.m.
CAD FILE: 815640\dwg\815640B.DWG (JLALLEN)

I HEREBY CERTIFY THAT THIS PLAN, SPECIFICATION, OR REPORT WAS PREPARED BY ME OR UNDER MY DIRECT SUPERVISION AND THAT I AM A DULY LICENSED PROFESSIONAL ENGINEER UNDER THE LAWS OF THE STATE OF MINNESOTA.
SIGNATURE: TERRY J. MAURER DATE:
PRINTED NAME: TERRY J. MAURER LIC. NO. 15316

NO.	DATE	BY	REVISION DESCRIPTION
1	6/20/02	JRC	Watermain Revisions

1326 ENERGY PARK DRIVE
ST. PAUL, MINNESOTA 55108
(612) 644-4389
Howard R Green Company
CONSULTING ENGINEERS

ZANE AVENUE IMPROVEMENTS
CITY OF ELK RIVER

S.P. 7101-56
ZANE AVENUE
STA. 4+50 TO STA. 8+50

SHEET NO.
9