



# ZANE AVENUE

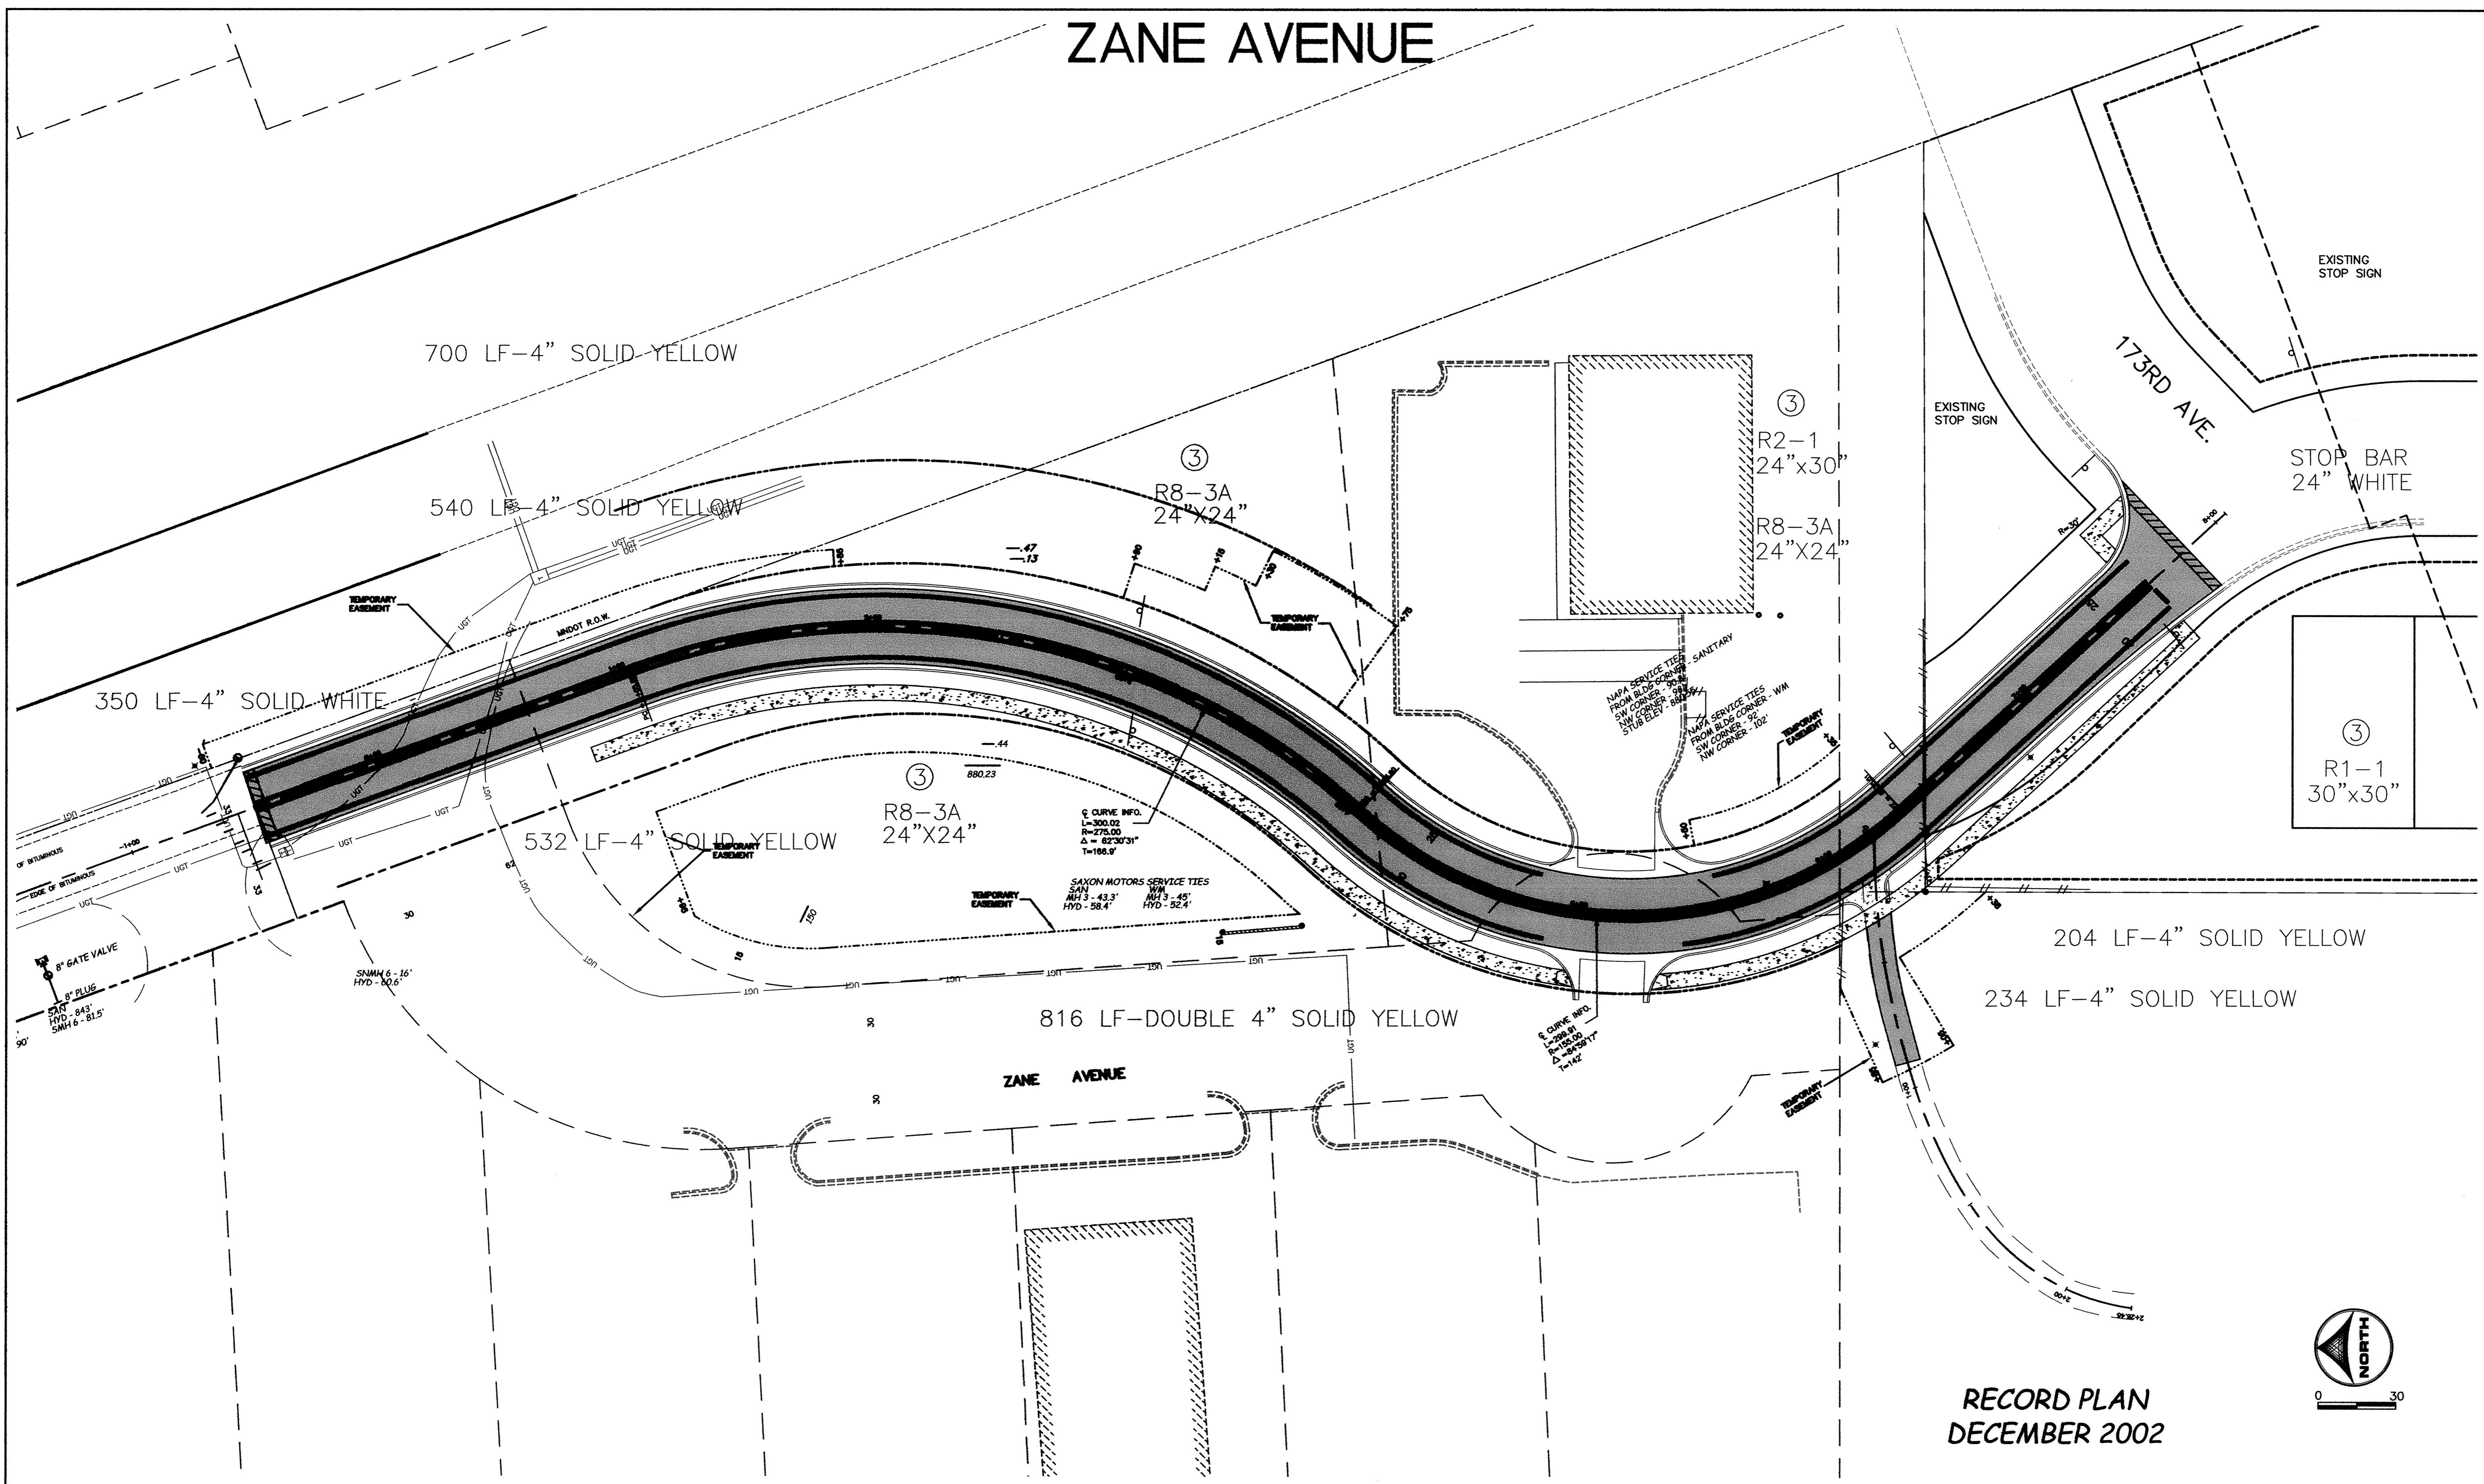

RECORD PLAN  
DECEMBER 2002

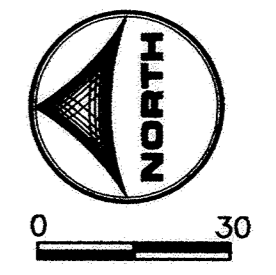


DESIGNED BY: KT/EY    DRAWN BY: EY  
 APPROVED BY:            JOB NUMBER 815640J  
 CAD DATE: January 09, 2003 10:20:24 a.m.  
 CAD FILE: 815640j.dwg\815640B.DWG (JLALLEN)

I HEREBY CERTIFY THAT THIS PLAN, SPECIFICATION, OR REPORT WAS PREPARED BY ME OR UNDER MY DIRECT SUPERVISION AND THAT I AM A DULY LICENSED PROFESSIONAL ENGINEER UNDER THE LAWS OF THE STATE OF MINNESOTA.

SIGNATURE: \_\_\_\_\_ DATE: \_\_\_\_\_  
 PRINTED NAME: TERRY J. MAURER    LIC. NO. 15316

NO.	DATE	BY	REVISION DESCRIPTION

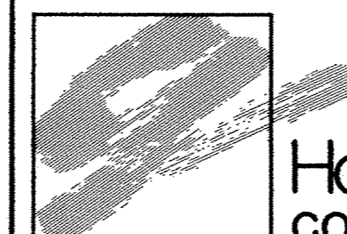

**Howard R. Green Company**  
CONSULTING ENGINEERS

1326 ENERGY PARK DRIVE  
ST. PAUL, MINNESOTA 55108  
(612) 644-4389

**ZANE AVENUE IMPROVEMENTS**  
CITY OF ELK RIVER

**ZANE AVENUE**  
SIGNING AND STRIPING

S.P. 7101-56

SHEET NO.  
**13**

DRAWING NUMBER  
ZANEA.02

DRAWING NUMBER  
14

DRAWING NUMBER  
14

DRAWING NUMBER  
14

SARCO PRODUCTS • NEW HOPE, MINNESOTA  
REORDER BY PART NUMBER 6552