





THIS RECORD DRAWING HAS BEEN PREPARED, IN PART, BASED UPON INFORMATION FURNISHED BY OTHERS. WHILE THIS INFORMATION IS BELIEVED TO BE RELIABLE, BOLTON & MENK, INC. CANNOT ASSURE ITS ACCURACY, AND THUS IS NOT RESPONSIBLE FOR THE ACCURACY OF THIS RECORD DRAWING OR FOR ANY ERRORS OR OMISSIONS WHICH MAY HAVE BEEN INCORPORATED INTO IT AS A RESULT. THOSE RELYING ON THIS DOCUMENT ARE ADVISED TO OBTAIN INDEPENDENT VERIFICATION OF ITS ACCURACY BEFORE APPLYING IT FOR ANY PURPOSE.
DATE: 02/14/2022 COMPLETED BY: TJH

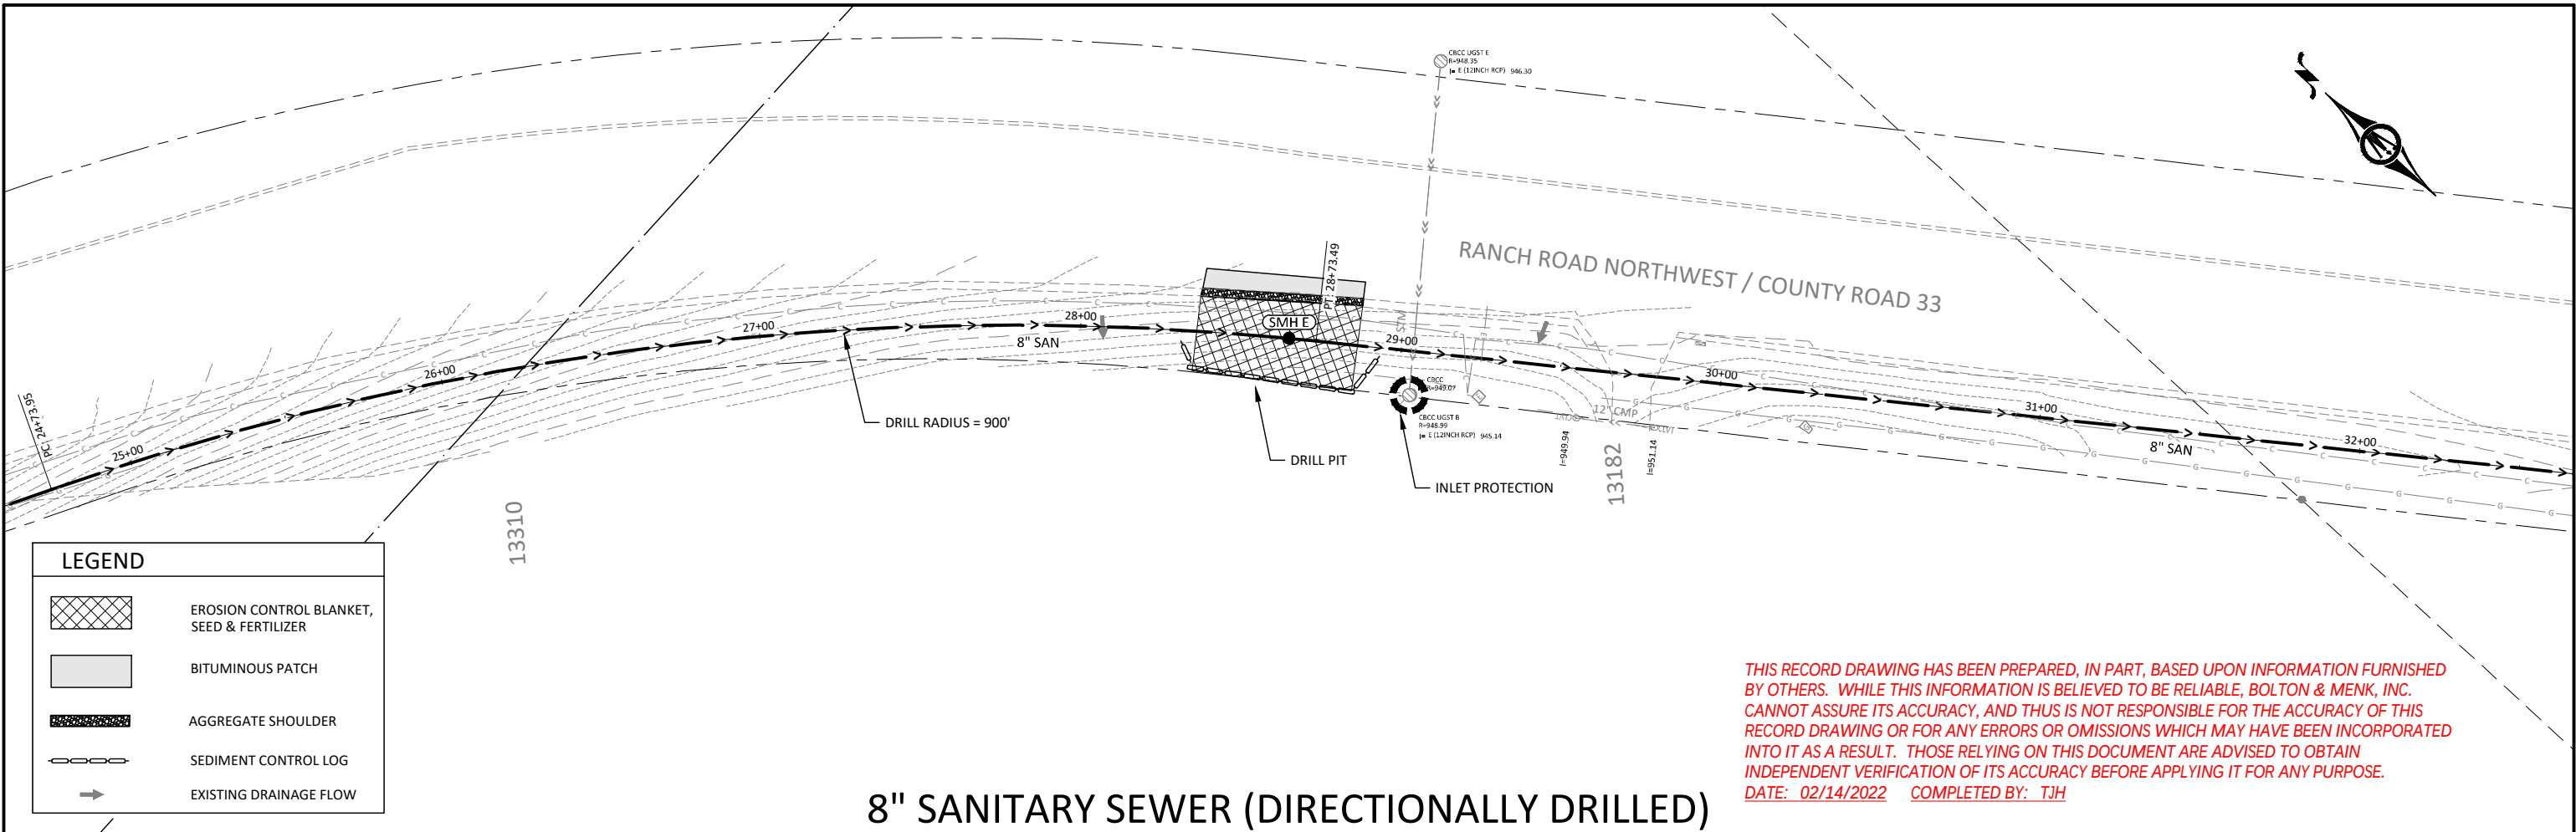

© Bolton & Menk, Inc. 2020. All Rights Reserved.
A:\19122405\19122405.dwg 8/17/2020 10:21:02 AM

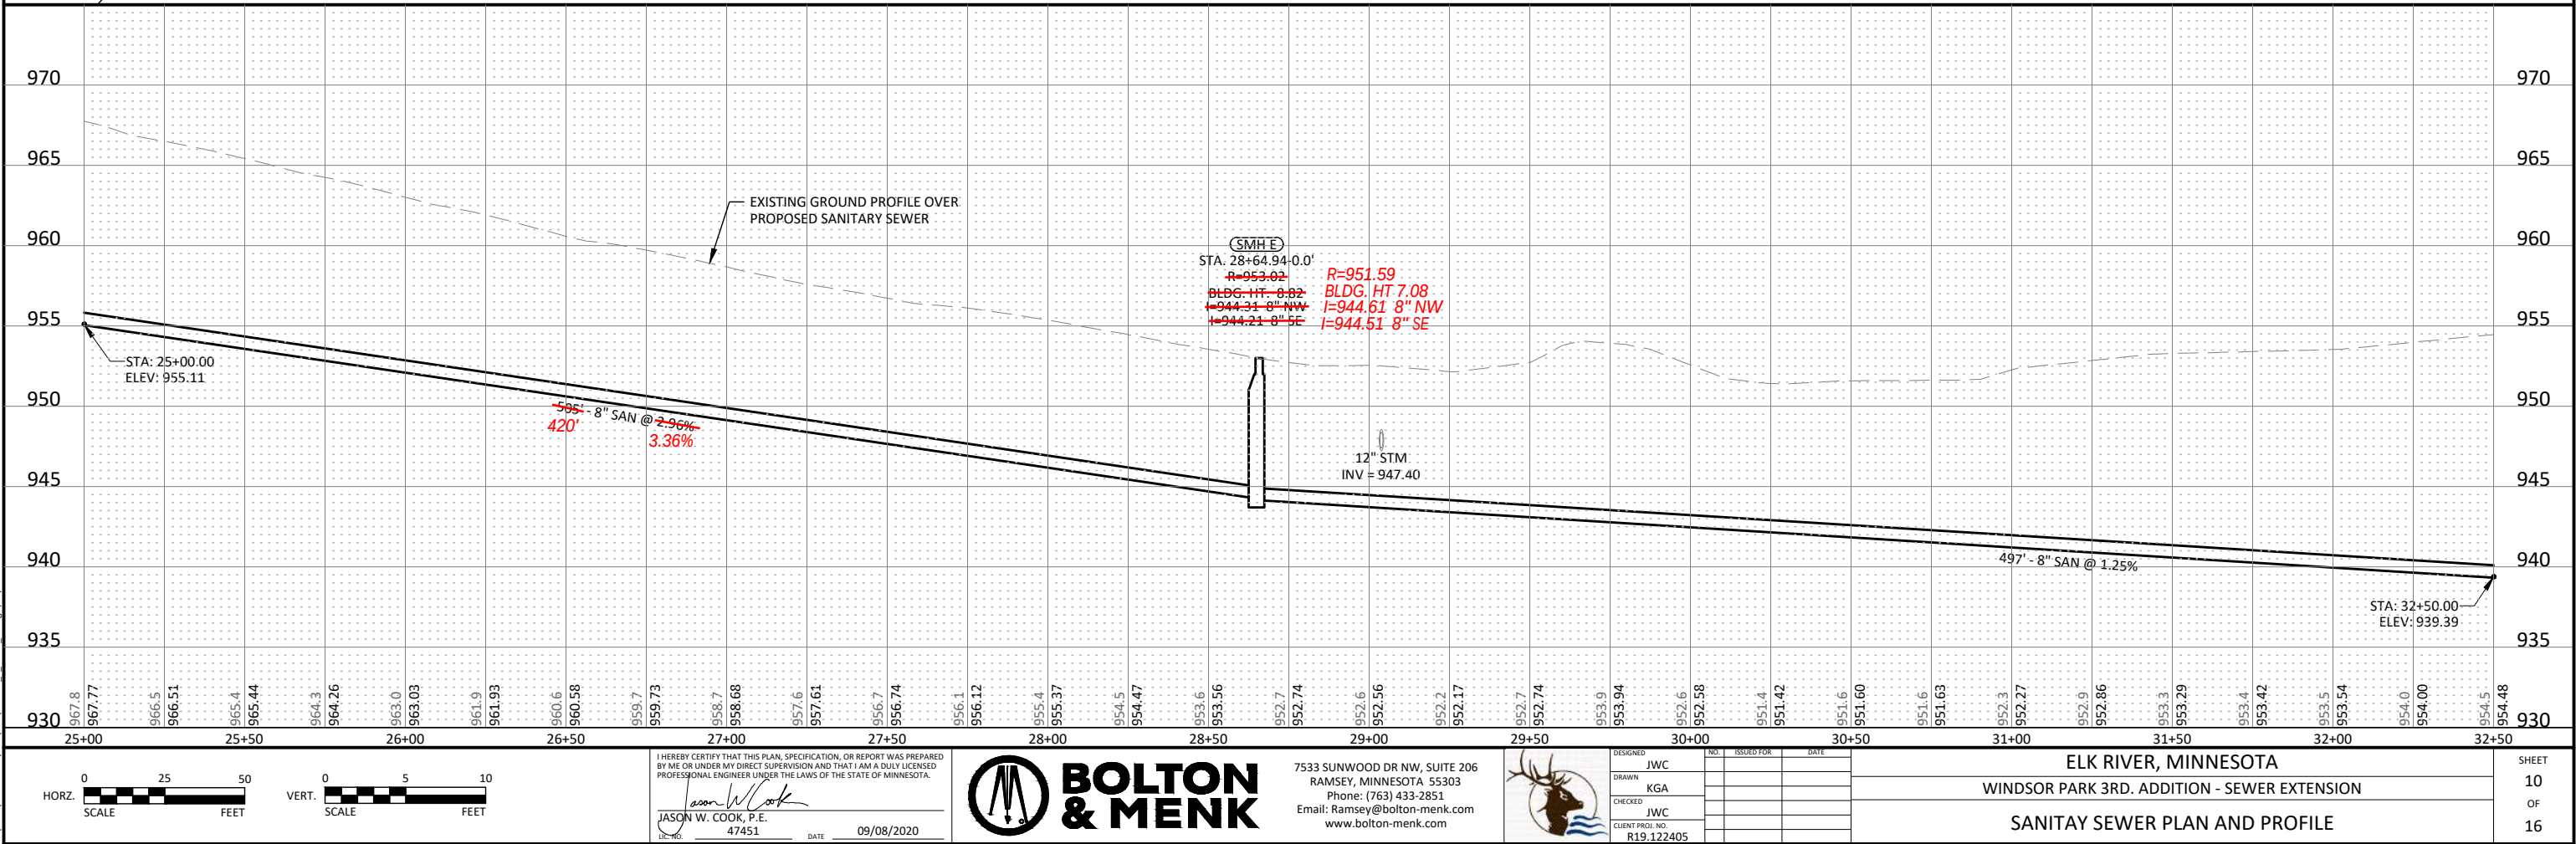

I HEREBY CERTIFY THAT THIS PLAN, SPECIFICATION, OR REPORT WAS PREPARED BY ME OR UNDER MY DIRECT SUPERVISION AND THAT I AM A DULY LICENSED PROFESSIONAL ENGINEER UNDER THE LAWS OF THE STATE OF MINNESOTA.
Jason W. Cook
JASON W. COOK, P.E.
47451
DATE 09/08/2020



7533 SUNWOOD DR NW, SUITE 206
RAMSEY, MINNESOTA 55303
Phone: (763) 433-2851
Email: Ramsey@bolton-menk.com
www.bolton-menk.com



DESIGNED	JWC	NO.	ISSUED FOR	DATE
DRAWN	KGA			
CHECKED	JWC			
CLIENT PROJ. NO.	R19.122405			

ELK RIVER, MINNESOTA
WINDSOR PARK 3RD. ADDITION - SEWER EXTENSION
SANITARY SEWER PLAN AND PROFILE

SHEET
10
OF
16