




BITUMINOUS PARKING LOT ACCESS ROAD - TYPICAL SECTION
NOT TO SCALE

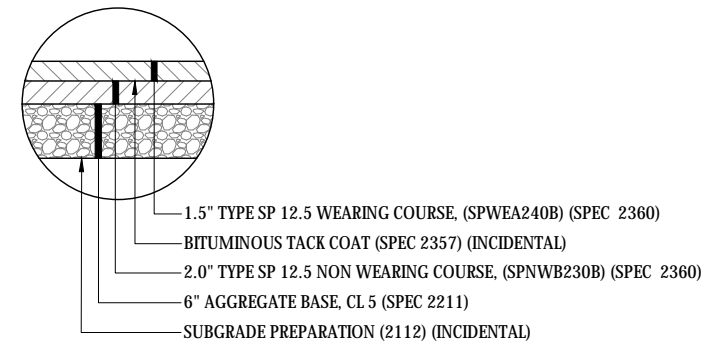


BITUMINOUS PARKING LOT - TYPICAL SECTION
NOT TO SCALE

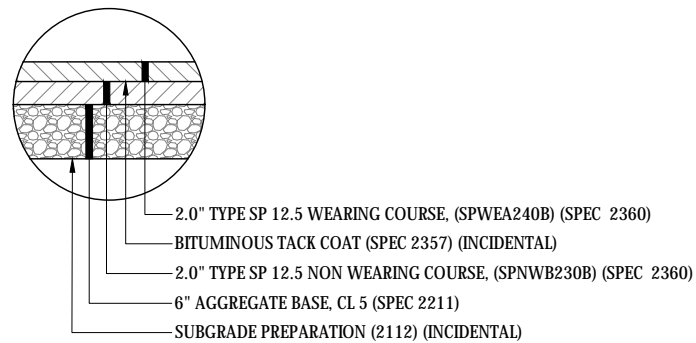


BITUMINOUS ROAD PATCHING - TYPICAL SECTION
COUNTY ROAD 33 - RANCH ROAD
NOT TO SCALE

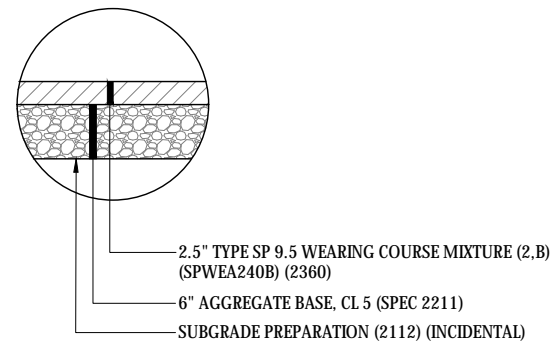

BITUMINOUS TRAIL PATCH - TYPICAL SECTION
GREAT NORTHERN TRAIL
NOT TO SCALE

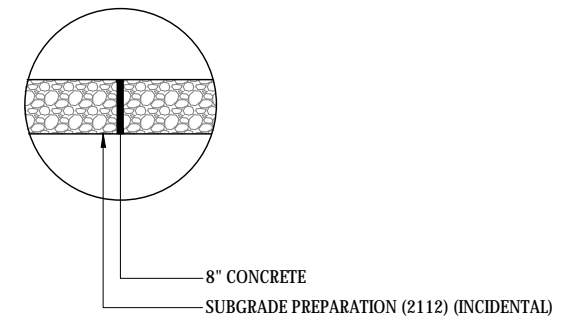

LOAD OUT CONCRETE SLAB DETAIL - TYPICAL SECTION
NOT TO SCALE

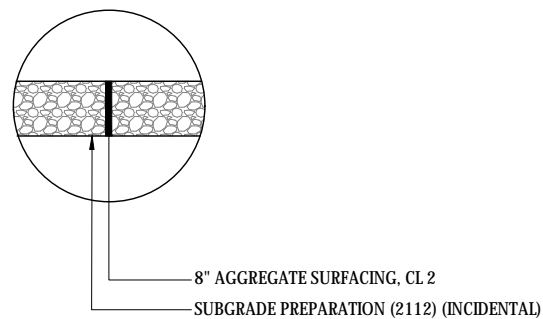

WEST SIDE LIFT STATION ACCESS DRIVE - TYPICAL SECTION
NOT TO SCALE

© Bolton & Menk, Inc. 2019. All Rights Reserved. C:\WORK\2019\PERM\CAD\11886603.dwg, 3/1/2019, 4:02:23 PM

CONTRACTOR: Minger Construction
RECORD PLAN
ZGN 12-22-2020

I HEREBY CERTIFY THAT THIS PLAN, SPECIFICATION, OR REPORT WAS PREPARED BY ME OR UNDER MY DIRECT SUPERVISION AND THAT I AM A DULY LICENSED PROFESSIONAL ENGINEER UNDER THE LAWS OF THE STATE OF MINNESOTA.
Kevin F. Bittner
Kevin F. Bittner
LIC. NO. 21814 DATE 03/01/2019



7533 SUNWOOD DR NW, SUITE 206
RAMSEY, MINNESOTA 55303
Phone: (763) 433-2851
Email: Ramsey@bolton-menk.com
www.bolton-menk.com

DESIGNED	NO.	REVISION	DATE
KFB			
DRAWN			
KGA			
CHECKED			
KFB			
CLIENT PROJ. NO.			
R16.115896			

ELK RIVER LANDFILL INC.
WASTE WATER FORCEMAIN
TYPICAL SECTIONS