



© Bolton & Menk, Inc. 2019. All Rights Reserved.
 65 WASHINGTON AVENUE, SUITE 1100, MINNEAPOLIS, MN 55401
 DATE: 3/7/2019 4:01:02 PM

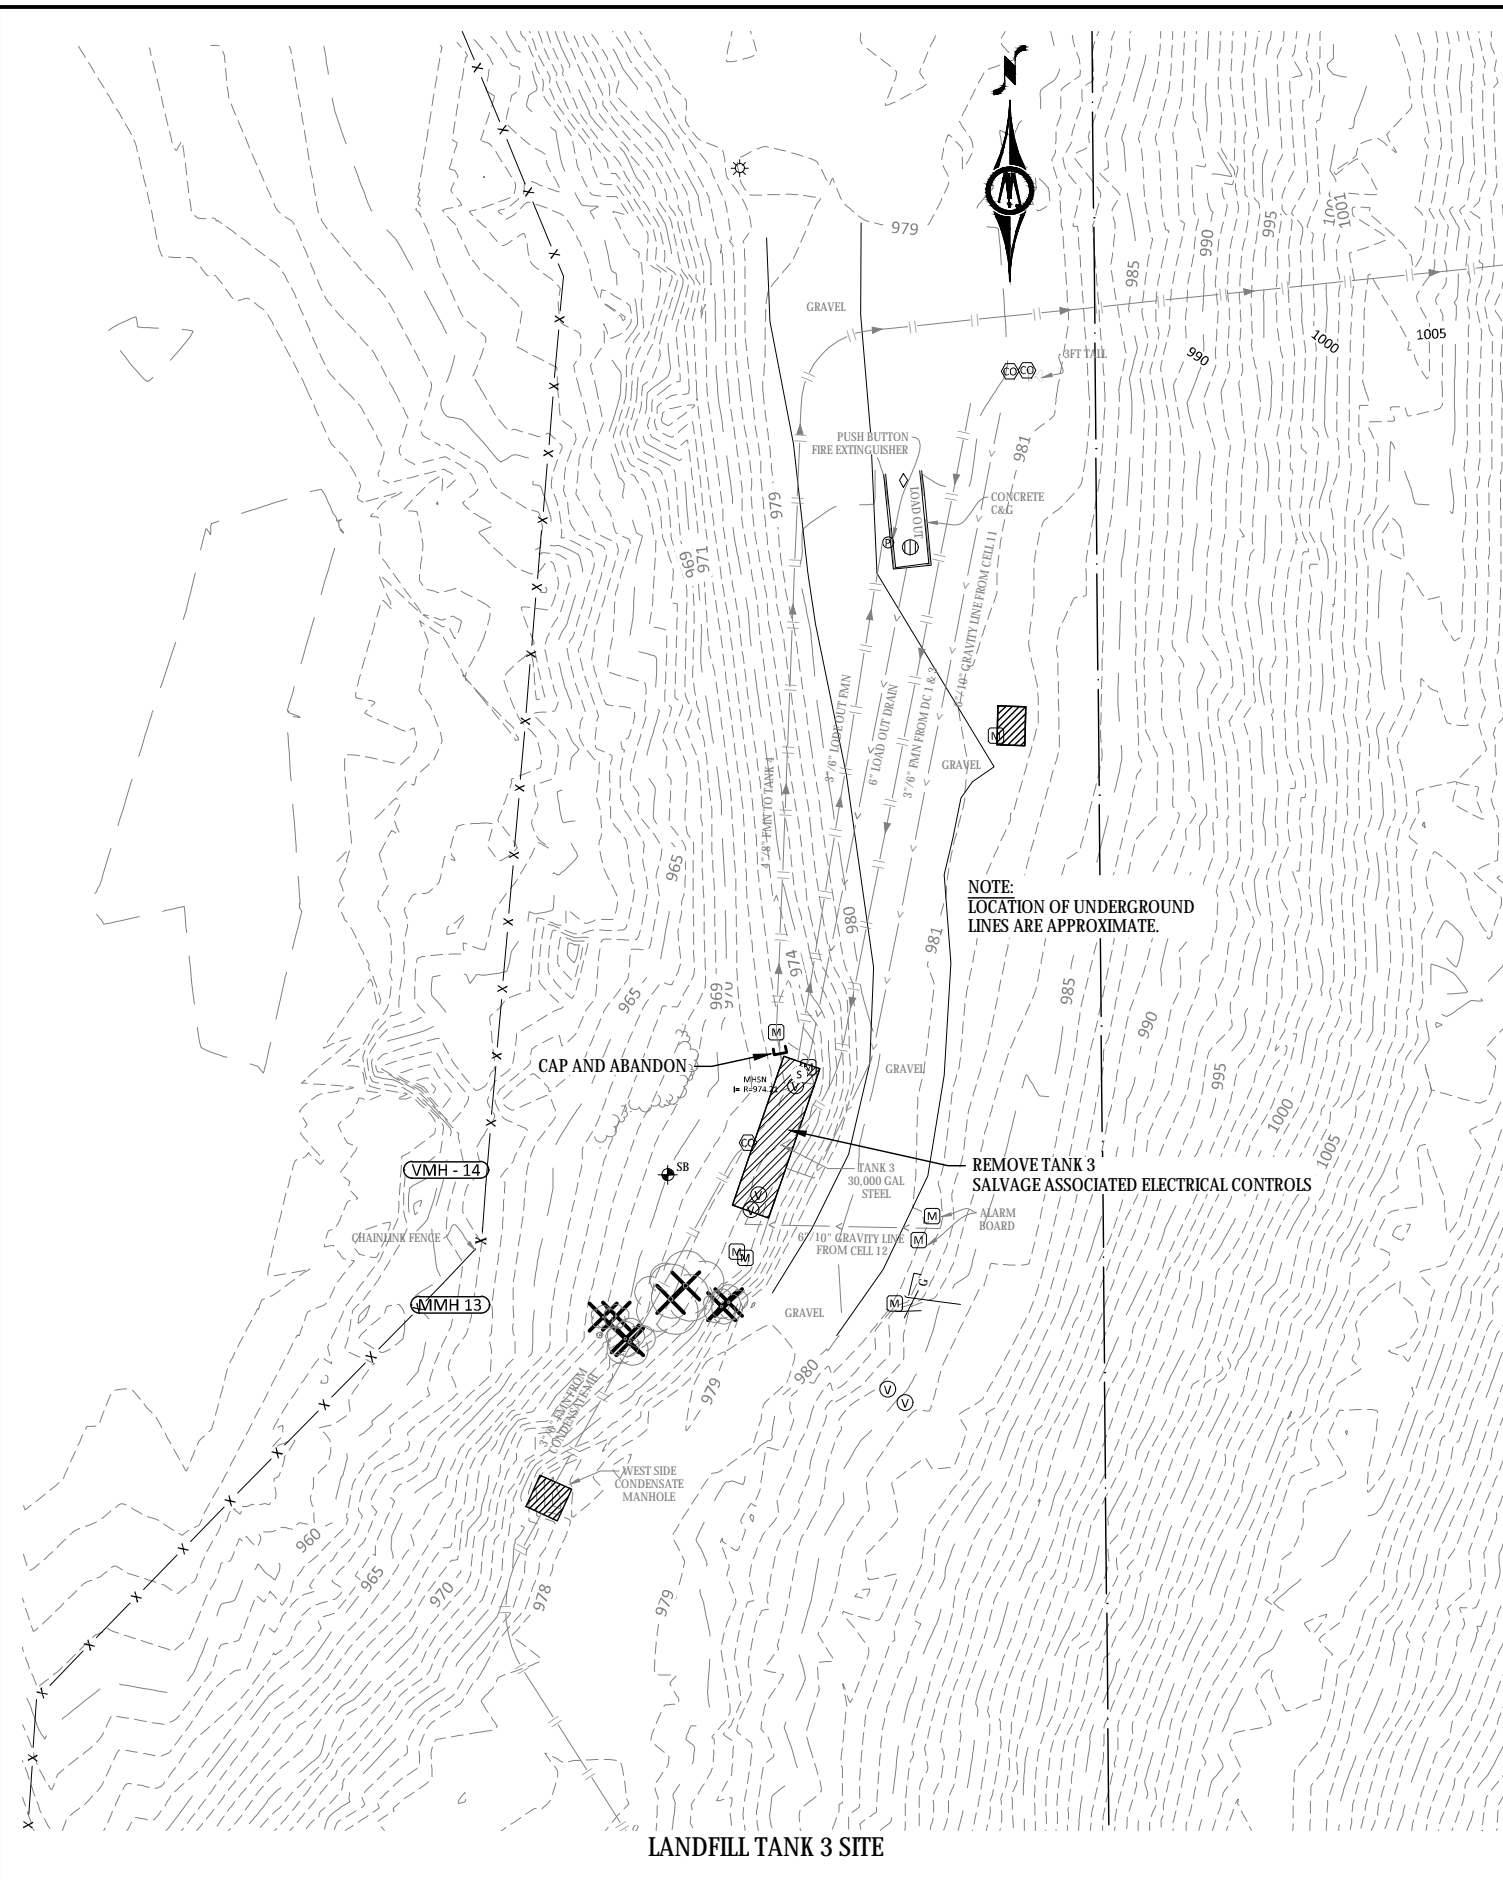

LANDFILL TANK 3 SITE

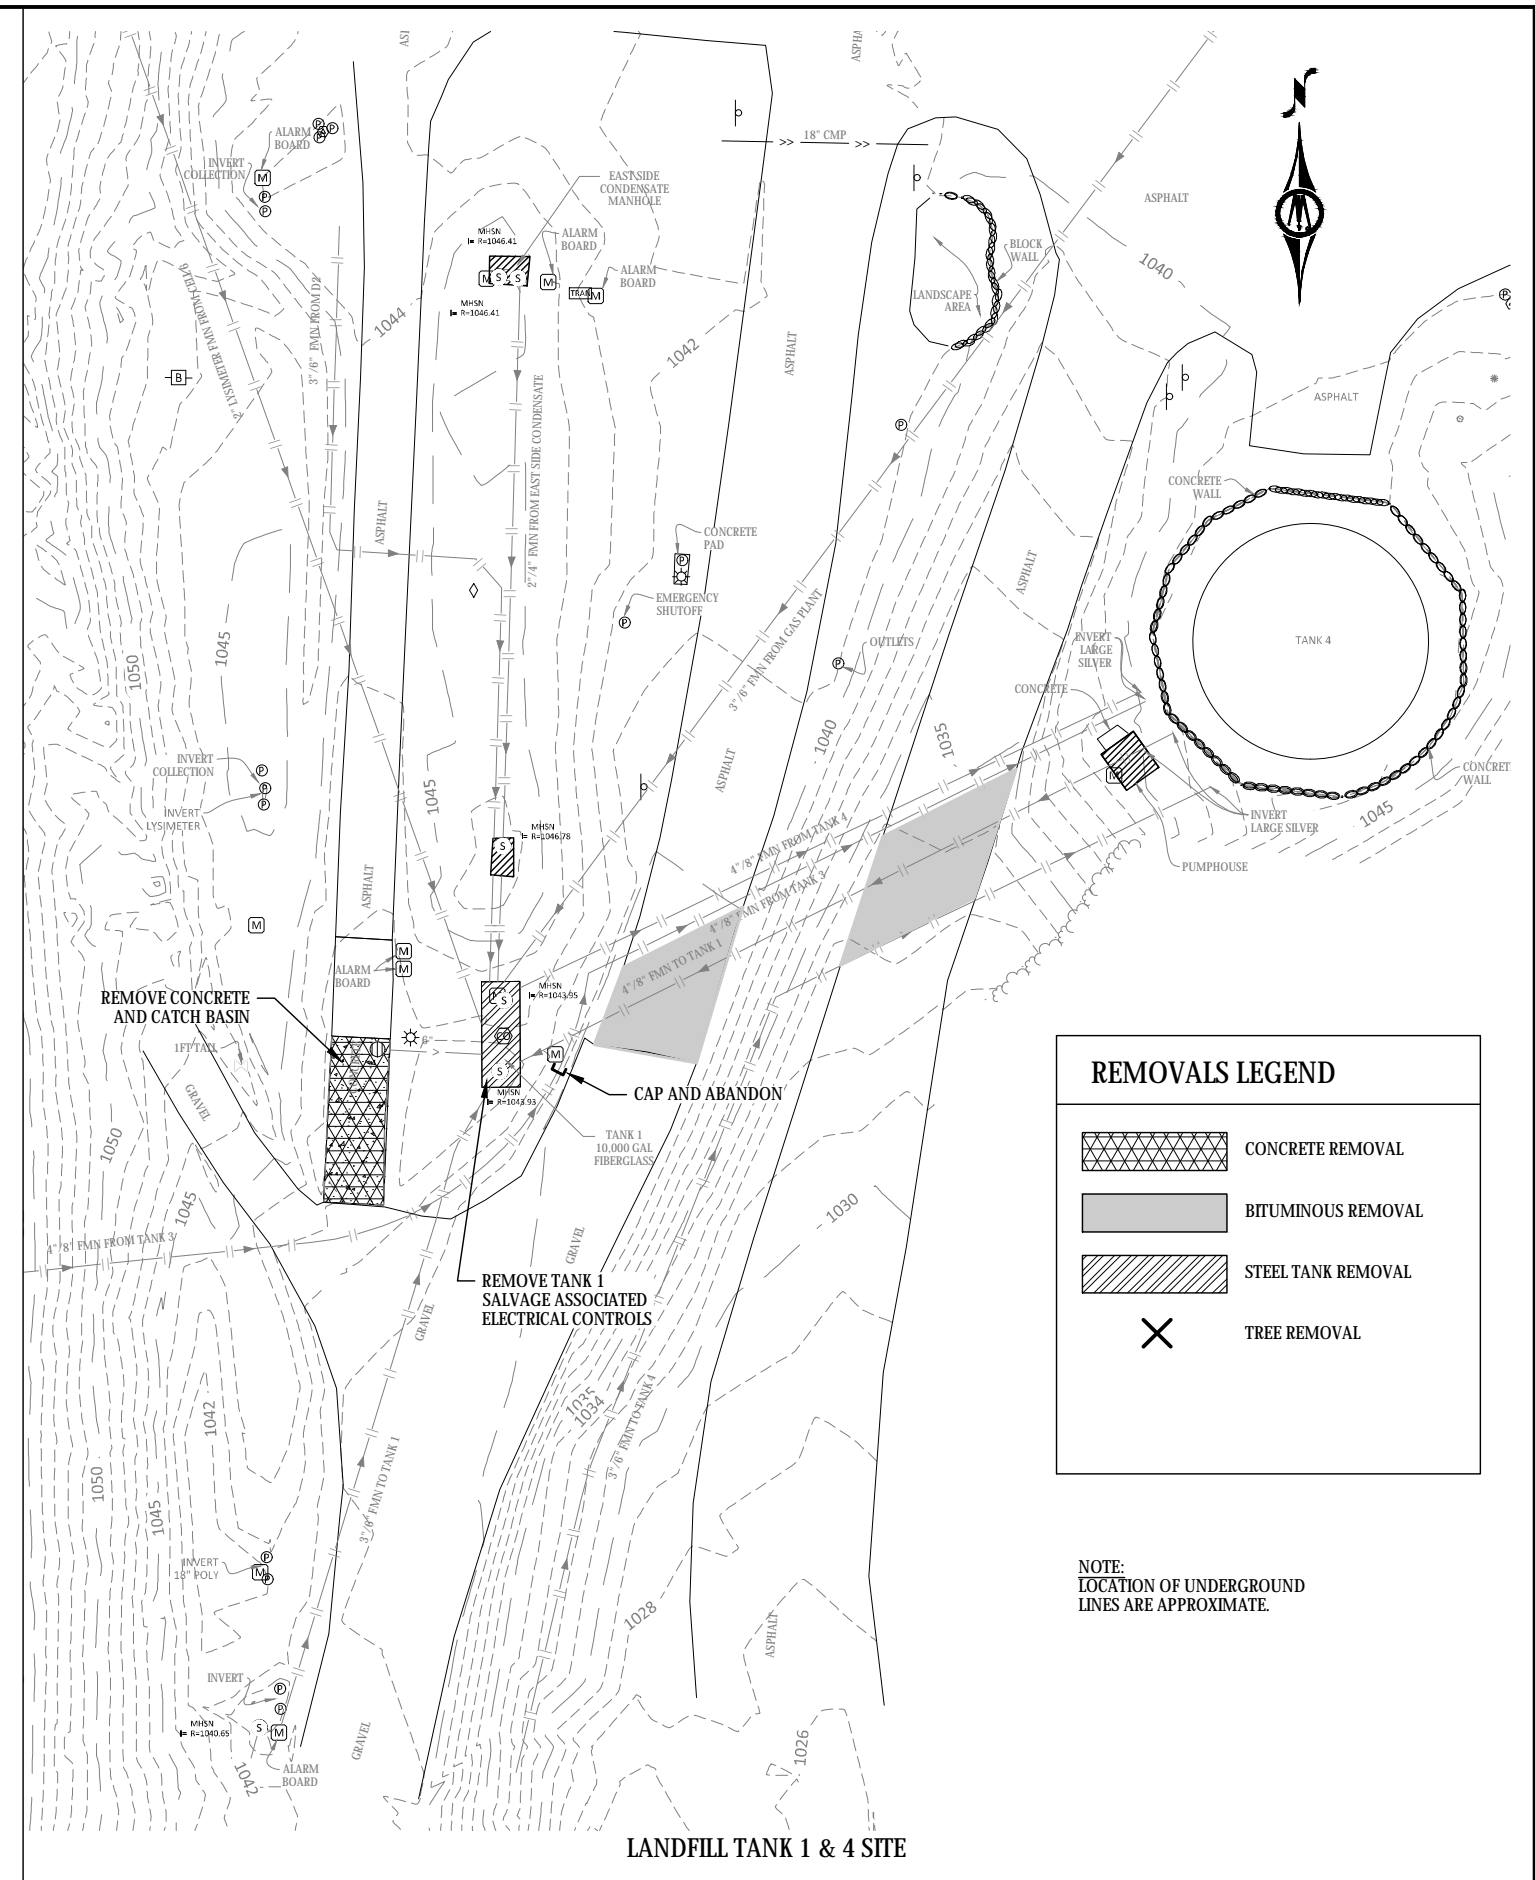

LANDFILL TANK 1 & 4 SITE

REMOVALS LEGEND

- CONCRETE REMOVAL
- BITUMINOUS REMOVAL
- STEEL TANK REMOVAL
- TREE REMOVAL

NOTE:
LOCATION OF UNDERGROUND
LINES ARE APPROXIMATE.

CONTRACTOR: Minger Construction
RECORD PLAN
 ZGN 12-22-2020

I HEREBY CERTIFY THAT THIS PLAN, SPECIFICATION, OR REPORT WAS PREPARED BY ME OR UNDER MY DIRECT SUPERVISION AND THAT I AM A DULY LICENSED PROFESSIONAL ENGINEER UNDER THE LAWS OF THE STATE OF MINNESOTA.

Kevin F. Bittner
 Kevin F. Bittner
 LIC. NO. 21814 DATE 03/01/2019



7533 SUNWOOD DR NW, SUITE 206
 RAMSEY, MINNESOTA 55303
 Phone: (763) 433-2851
 Email: Ramsey@bolton-menk.com
 www.bolton-menk.com

DESIGNED	NO.	REVISION	DATE
KFB			
KGA			
KFB			
CLIENT PROJ. NO.	R16.115896		

ELK RIVER LANDFILL INC.
WASTE WATER FORCEMAIN
EXISTING CONDITIONS & REMOVALS