



**DITCH CHECK - BIOROLL**  
NOT TO SCALE


NOTE:  
POINT 'A' MUST BE 1'-0" MIN HIGHER THAN POINT 'B' TO ENSURE THAT WATER FLOWS OVER THE DITCH CHECK AND NOT AROUND THE ENDS

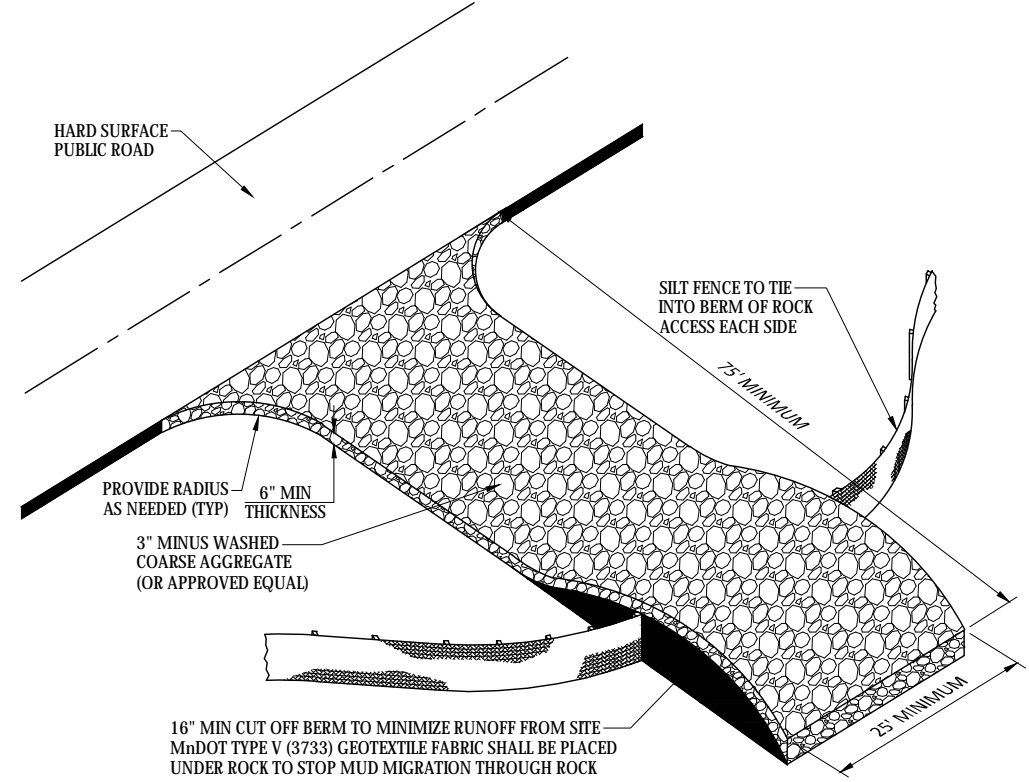

**ROCK CONSTRUCTION ENTRANCE**  
NOT TO SCALE

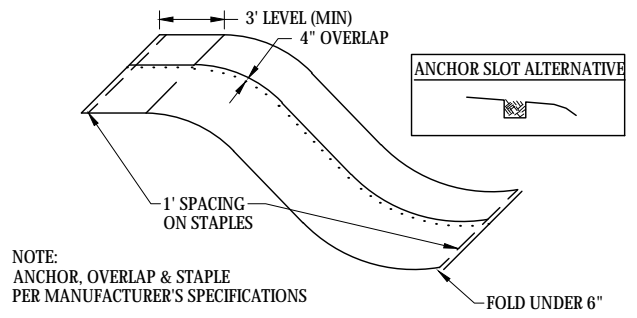

**EROSION CONTROL BLANKET INSTALLATION**  
NOT TO SCALE

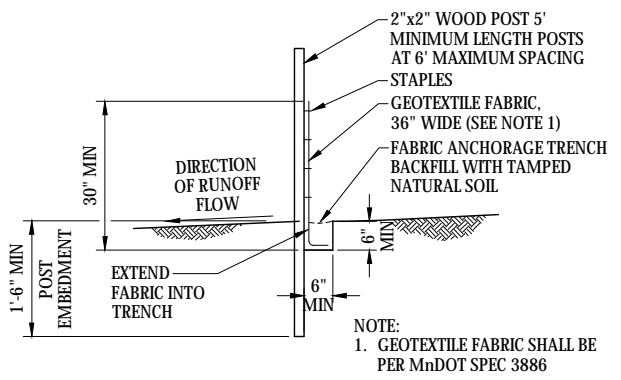

**SILT FENCE - PREASSEMBLED**  
NOT TO SCALE

© Bolton & Menk, Inc. 2019. All Rights Reserved. 115886.CAD/CED/115886C003.dwg, 3/1/2019, 4:02:58 PM

**CONTRACTOR: Minger Construction**  
**RECORD PLAN**  
ZGN 12-22-2020

I HEREBY CERTIFY THAT THIS PLAN, SPECIFICATION, OR REPORT WAS PREPARED BY ME OR UNDER MY DIRECT SUPERVISION AND THAT I AM A DULY LICENSED PROFESSIONAL ENGINEER UNDER THE LAWS OF THE STATE OF MINNESOTA.  
*Kevin F. Bittner*  
Kevin F. Bittner  
LIC. NO. 21814 DATE 03/01/2019



7533 SUNWOOD DR NW, SUITE 206  
RAMSEY, MINNESOTA 55303  
Phone: (763) 433-2851  
Email: Ramsey@bolton-menk.com  
www.bolton-menk.com

DRAWN	NO.	REVISION	DATE
KFB			
KGA			
KFB			

ELK RIVER LANDFILL INC.  
WASTE WATER FORCEMAIN  
EROSION CONTROL DETAILS