

EXISTING TOPOGRAPHIC SYMBOLS

	ACCESS GRATE		SATELLITE DISH
	AIR CONDITION UNIT		SIGN TRAFFIC
	ANTENNA		SIGNAL CONTROL CABINET
	AUTO SPRINKLER CONNECTION		SOIL BORING
	BARRICADE PERMANENT		SIREN
	BASKETBALL POST		TELEPHONE BOOTH
	BENCH		TILE INLET
	BIRD FEEDER		TILE OUTLET
	BOLLARD		TILE RISER
	BUSH		TRANSFORMER-ELECTRIC
	CATCH BASIN RECTANGULAR CASTING		TREE-CONIFEROUS
	CATCH BASIN CIRCULAR CASTING		TREE-DEAD
	CURB STOP		TREE-DECIDUOUS
	CLEAN OUT		TREE STUMP
	CULVERT END		TRAFFIC ARM BARRIER
	DRINKING FOUNTAIN		TRAFFIC SIGNAL
	DOWN SPOUT		TRASH CAN
	FILL PIPE		UTILITY MARKER
	FIRE HYDRANT		VALVE
	FLAG POLE		VALVE POST INDICATOR
	FLARED END / APRON		VALVE VAULT
	FUEL PUMP		VENT PIPE
	GRILL		WATER SPIGOT
	GUY WIRE ANCHOR		WELL
	HANDHOLE		WETLAND DELINEATED MARKER
	HANDICAP SPACE		WETLAND
	IRRIGATION SPRINKLER HEAD		WET WELL
	IRRIGATION VALVE BOX		YARD HYDRANT
	LIFT STATION CONTROL PANEL		
	LIFT STATION		
	LIGHT POLE		
	MAILBOX		
	MANHOLE-COMMUNICATION		
	MANHOLE-ELECTRIC		
	MANHOLE-GAS		
	MANHOLE-HEAT		
	MANHOLE-SANITARY SEWER		
	MANHOLE-STORM SEWER		
	MANHOLE-UTILITY		
	MANHOLE-WATER		
	METER		
	ORDER MICROPHONE		
	PARKING METER		
	PAVEMENT MARKING		
	PEDESTAL-COMMUNICATION		
	PEDESTAL-ELECTRIC		
	PEDESTRIAN PUSH BUTTON		
	PICNIC TABLE		
	POLE-UTILITY		
	POST		
	RAILROAD SIGNAL POLE		
	REGULATION STATION GAS		

PROPOSED TOPOGRAPHIC SYMBOLS

	CLEANOUT
	MANHOLE
	LIFT STATION
	STORM SEWER CIRCULAR CASTING
	STORM SEWER RECTANGULAR CASTING
	STORM SEWER FLARED END / APRON
	STORM SEWER OUTLET STRUCTURE
	STORM SEWER OVERFLOW STRUCTURE
	CURB BOX
	FIRE HYDRANT
	WATER VALVE
	WATER REDUCER
	WATER BEND
	WATER TEE
	WATER CROSS
	WATER SLEEVE
	WATER CAP / PLUG
	RIP RAP
	DRAINAGE FLOW
	TRAFFIC SIGNS

SURVEY SYMBOLS

	BENCH MARK LOCATION
	CONTROL POINT
	MONUMENT IRON FOUND
	CAST IRON MONUMENT

EXISTING TOPOGRAPHIC LINES

	RETAINING WALL
	FENCE
	FENCE-DECORATIVE
	GUARD RAIL
	TREE LINE
	BUSH LINE

SURVEY LINES

	CONTROLLED ACCESS BOUNDARY
	CENTERLINE
	EXISTING EASEMENT LINE
	PROPOSED EASEMENT LINE
	EXISTING LOT LINE
	PROPOSED LOT LINE
	EXISTING RIGHT-OF-WAY
	PROPOSED RIGHT-OF-WAY
	SETBACK LINE
	SECTION LINE
	QUARTER LINE
	SIXTEENTH LINE
	TEMPORARY EASEMENT


EXISTING UTILITY LINES

	FORCEMAIN
	SANITARY SEWER
	SANITARY SERVICE
	STORM SEWER
	STORM SEWER DRAIN TILE
	WATERMAIN
	WATER SERVICE

PROPOSED UTILITY LINES

	FORCEMAIN
	SANITARY SEWER
	SANITARY SERVICE
	STORM SEWER
	STORM SEWER DRAIN TILE
	WATERMAIN
	WATER SERVICE
	PIPE CASINGS

GRADING INFORMATION

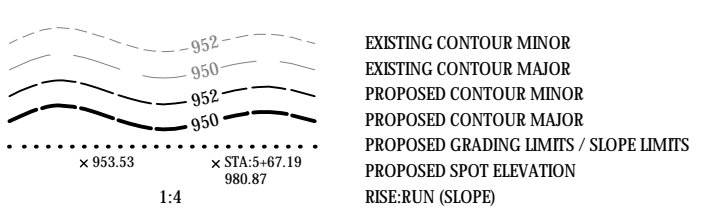

HATCH PATTERNS

	BITUMINOUS		GRAVEL
	CONCRETE		

EXISTING PRIVATE UTILITY LINES

NOTE:
EXISTING UTILITY INFORMATION SHOWN ON THIS PLAN HAS BEEN PROVIDED BY THE UTILITY OWNER. THE CONTRACTOR SHALL FIELD VERIFY EXACT LOCATIONS PRIOR TO COMMENCING CONSTRUCTION AS REQUIRED BY STATE LAW. NOTIFY GOPHER STATE ONE CALL, 1-800-252-1166 OR 651-454-0002.

THE SUBSURFACE UTILITY INFORMATION IN THIS PLAN IS UTILITY QUALITY LEVEL D UNLESS OTHERWISE NOTED. THIS UTILITY LEVEL WAS DETERMINED ACCORDING TO THE GUIDELINES OF CI/ASCE 38-02, ENTITLED "STANDARD GUIDELINES FOR THE COLLECTION AND DEPICTION OF EXISTING SUBSURFACE UTILITY DATA"

	UNDERGROUND FIBER OPTIC
	UNDERGROUND ELECTRIC
	UNDERGROUND GAS
	UNDERGROUND COMMUNICATION
	OVERHEAD ELECTRIC
	OVERHEAD COMMUNICATION
	OVERHEAD UTILITY

UTILITIES IDENTIFIED WITH A QUALITY LEVEL OTHER THAN D:

LINE TYPES FOLLOW THE FORMAT: UTILITY TYPE - QUALITY LEVEL
EXAMPLE: G-A G-A UNDERGROUND GAS, QUALITY LEVEL A
UTILITY QUALITY LEVEL (A,B,C,D) DEFINITIONS CAN BE FOUND IN CI/ASCE 38-02.

UTILITY QUALITY LEVELS:

- LEVEL D - INFORMATION COMES SOLELY FROM EXISTING UTILITY RECORDS.
- LEVEL C - SURVEYING ABOVE GROUND UTILITY FACILITIES, SUCH AS MANHOLES, VALVE BOXES, ETC; AND CORRELATING THIS INFORMATION WITH EXISTING UTILITY RECORDS.
- LEVEL B - THE USE OF SURFACE GEOPHYSICAL TECHNIQUES TO DETERMINE THE EXISTENCE AND HORIZONTAL POSITION OF UNDERGROUND UTILITIES.
- LEVEL A - THE USE OF NONDESTRUCTIVE DIGGING EQUIPMENT AT HORIZONTAL AND VERTICAL POSITION OF UNDERGROUND UTILITIES, AS WELL AS THE TYPE, SIZE, CONDITION, MATERIAL, AND OTHER CHARACTERISTICS.

ABBREVIATIONS

A	ALGEBRAIC DIFFERENCE	GRAV	GRAVEL	RT	RIGHT
ADJ	ADJUST	GU	GUTTER	SAN	SANITARY SEWER
ALT	ALTERNATE	GV	GATE VALVE	SCH	SCHEDULE
B-B	BACK TO BACK	HDPE	HIGH DENSITY POLYETHYLENE	SERV	SERVICE
BIT	BITUMINOUS	HH	HANDHOLE	SHLD	SHOULDER
BLDG	BUILDING	HP	HIGH POINT	STA	STATION
BMP	BEST MANAGEMENT PRACTICE	HWL	HIGH WATER LEVEL	STD	STANDARD
BR	BEGIN RADIUS	HYD	HYDRANT	STM	STORM SEWER
BV	BUTTERFLY VALVE	I	INVERT	TC	TOP OF CURB
CB	CATCH BASIN	K	CURVE COEFFICIENT	TE	TEMPORARY EASEMENT
C&G	CURB AND GUTTER	L	LENGTH	TEMP	TEMPORARY
CIP	CAST IRON PIPE	LO	LOWEST OPENING	TNH	TOP NUT HYDRANT
CIPP	CURED-IN-PLACE PIPE	LP	LOW POINT	TP	TOP OF PIPE
CL	CENTER LINE	LT	LEFT	TYP	TYPICAL
CL	CLASS	MH	MANHOLE	VCP	VITRIFIED CLAY PIPE
CMF	CORRUGATED METAL PIPE	MIN	MINIMUM	VERT	VERTICAL
C.O.	CHANGE ORDER	MR	MID RADIUS	VPC	VERTICAL POINT OF CURVE
COMM	COMMUNICATION	NIC	NOT IN CONTRACT	VPI	VERTICAL POINT OF INTERSECTION
CON	CONCRETE	NMC	NON-METALLIC CONDUIT	VPT	VERTICAL POINT OF TANGENT
CSP	CORRUGATED STEEL PIPE	NTS	NOT TO SCALE	WM	WATERMAIN
CLVT	CULVERT	NWL	NORMAL WATER LEVEL		
DIA	DIAMETER	OHW	ORDINARY HIGH WATER LEVEL	AC	ACRES
DIP	DUCTILE IRON PIPE	PC	POINT OF CURVE	CF	CUBIC FEET
DWY	DRIVEWAY	PCC	POINT OF COMPOUND CURVE	CV	COMPACTED VOLUME
E	EXTERNAL CURVE DISTANCE	PE	PERMANENT EASEMENT	CY	CUBIC YARD
ESMT	EASEMENT	PED	PEDESTRIAN, PEDESTAL	EA	EACH
ELEC	ELECTRIC	PERF	PERFORATED PIPE	EV	EXCAVATED VOLUME
ELEV	ELEVATION	PERM	PERMANENT	LB	POUND
EOF	EMERGENCY OVERFLOW	PI	POINT OF INTERSECTION	LF	LINEAR FEET
ER	END RADIUS	PL	PROPERTY LINE	LS	LUMP SUM
EX	EXISTING	PRC	POINT OF REVERSE CURVE	LV	LOOSE VOLUME
FES	FLARED END SECTION	PT	POINT OF TANGENT	SF	SQUARE FEET
F-F	FACE TO FACE	PVC	POLYVINYL CHLORIDE PIPE	SV	STOCKPILE VOLUME
FF	FINISHED FLOOR	PVMT	PAVEMENT	SY	SQUARE YARD
F&I	FURNISH AND INSTALL	R	RADIUS		
FM	FORCEMAIN	RCP	REINFORCED CONCRETE PIPE		
FO	FIBER OPTIC	RET	RETAINING		
F.O.	FIELD ORDER	R/W	RIGHT-OF-WAY		
GRAN	GRANULAR	RSC	RIGID STEEL CONDUIT		

© Bolton & Menk, Inc. 2019. All Rights Reserved. 02/15/2019 11:58:06 AM. C:\D\115896\02.dwg, 3/1/2019 3:29:08 PM

CONTRACTOR: Minger Construction
RECORD PLAN
ZGN 12-22-2020

I HEREBY CERTIFY THAT THIS PLAN, SPECIFICATION, OR REPORT WAS PREPARED BY ME OR UNDER MY DIRECT SUPERVISION AND THAT I AM A DULY LICENSED PROFESSIONAL ENGINEER UNDER THE LAWS OF THE STATE OF MINNESOTA.
Kevin F. Bittner
Kevin F. Bittner
I.C. NO. 21814 DATE 03/01/2019

BOLTON & MENK
7533 SUNWOOD DR NW, SUITE 206
RAMSEY, MINNESOTA 55303
Phone: (763) 433-2851
Email: Ramsey@bolton-menk.com
www.bolton-menk.com

DESIGNED	NO.	REVISION	DATE
KFB			
KGA			
KFB			
CLIENT PROJ. NO.	R16.115896		

ELK RIVER LANDFILL INC.
WASTE WATER FORCEMAIN
LEGEND

SHEET 2 OF 46