



- NOTE:**
1. CONTRACTOR TO FIELD VERIFY DEPTH AND LOCATION OF ALL EXISTING FORCEMAIN AND GRAVITY SEWER LINES PRIOR TO LIFT STATION CONSTRUCTION.
 2. PIPE ELEVATIONS ARE TO BOTTOM OF PIPE UNLESS OTHERWISE NOTED. SEE SHEET 4 FOR WEST LIFT STATION DETAILS

LEGEND:

	CONCRETE PAVEMENT
	GRAVEL ACCESS ROAD
	FORCEMAIN
	GRAVITY LINE

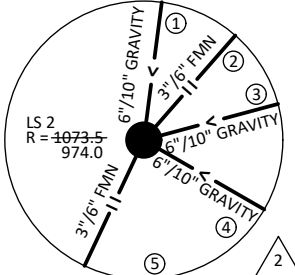

- INSET "A"**
- | | |
|---|-------------------------|
| ① | 10" BOOT @ 1058.0-958.0 |
| ② | 6" BOOT @ 1058.0-958.0 |
| ③ | 10" BOOT @ 1058.0-958.0 |
| ④ | 10" BOOT @ 1058.0-958.0 |
| ⑤ | 6" BOOT @ 1058.0-958.0 |

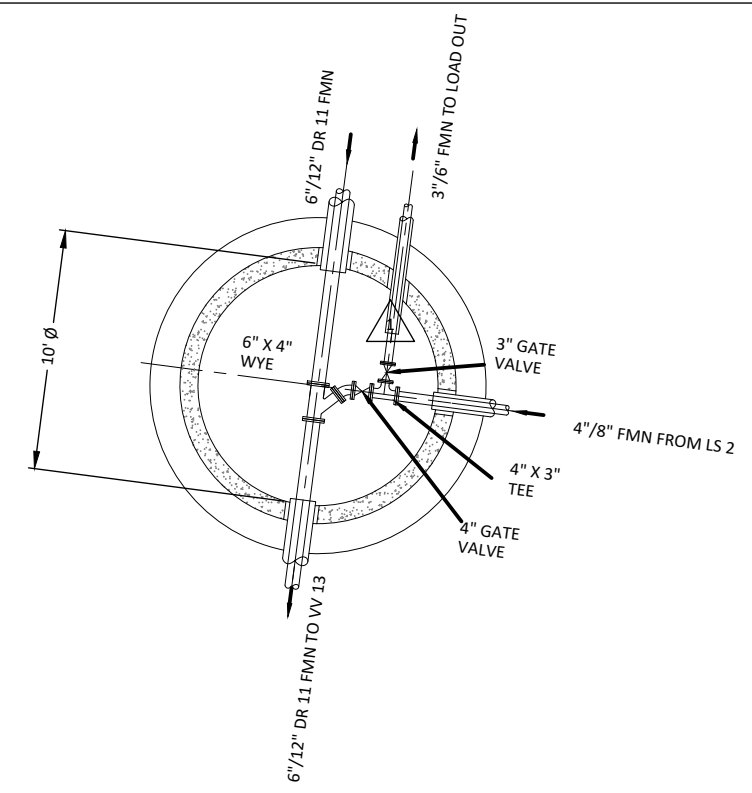

VALVE MANHOLE 14
NOT TO SCALE

I HEREBY CERTIFY THAT THIS PLAN, SPECIFICATION, OR REPORT WAS PREPARED BY ME OR UNDER MY DIRECT SUPERVISION AND THAT I AM A DULY LICENSED PROFESSIONAL ENGINEER UNDER THE LAWS OF THE STATE OF MINNESOTA.

Kevin F. Bittner
Kevin F. Bittner
LIC. NO. 21814 DATE 03/01/2019



7533 SUNWOOD DR NW, SUITE 206
RAMSEY, MINNESOTA 55303
Phone: (763) 433-2851
Email: Ramsey@bolton-menk.com
www.bolton-menk.com

DESIGNED	NO.	REVISION	DATE
KFB	1	VH 14	5/11/2020
KGA	2	LS 2	8/07/2020
KFB			
CLIENT PROJ. NO. R16.115896			

ELK RIVER LANDFILL INC.
WASTE WATER FORCEMAIN
LIFT STATION 2 SITE

© Bolton & Menk, Inc. 2021. All Rights Reserved. H:\WASTEWATER\PRJ\16115896\CAD\C3D\115896E301.dwg 11/13/2021 11:39:49 AM

CONTRACTOR: Minger Construction
RECORD PLAN
ZGN 12-22-2020