

LEGEND

EROSION CONTROL BLANKET, SEED & FERTILIZER


BITUMINOUS TRAIL PATCH

PA

PREASSEMBLED SILT FENCE

EXISTING DRAINAGE FLOW

6" DRILL HDPE DR 11 FORCEMAIN

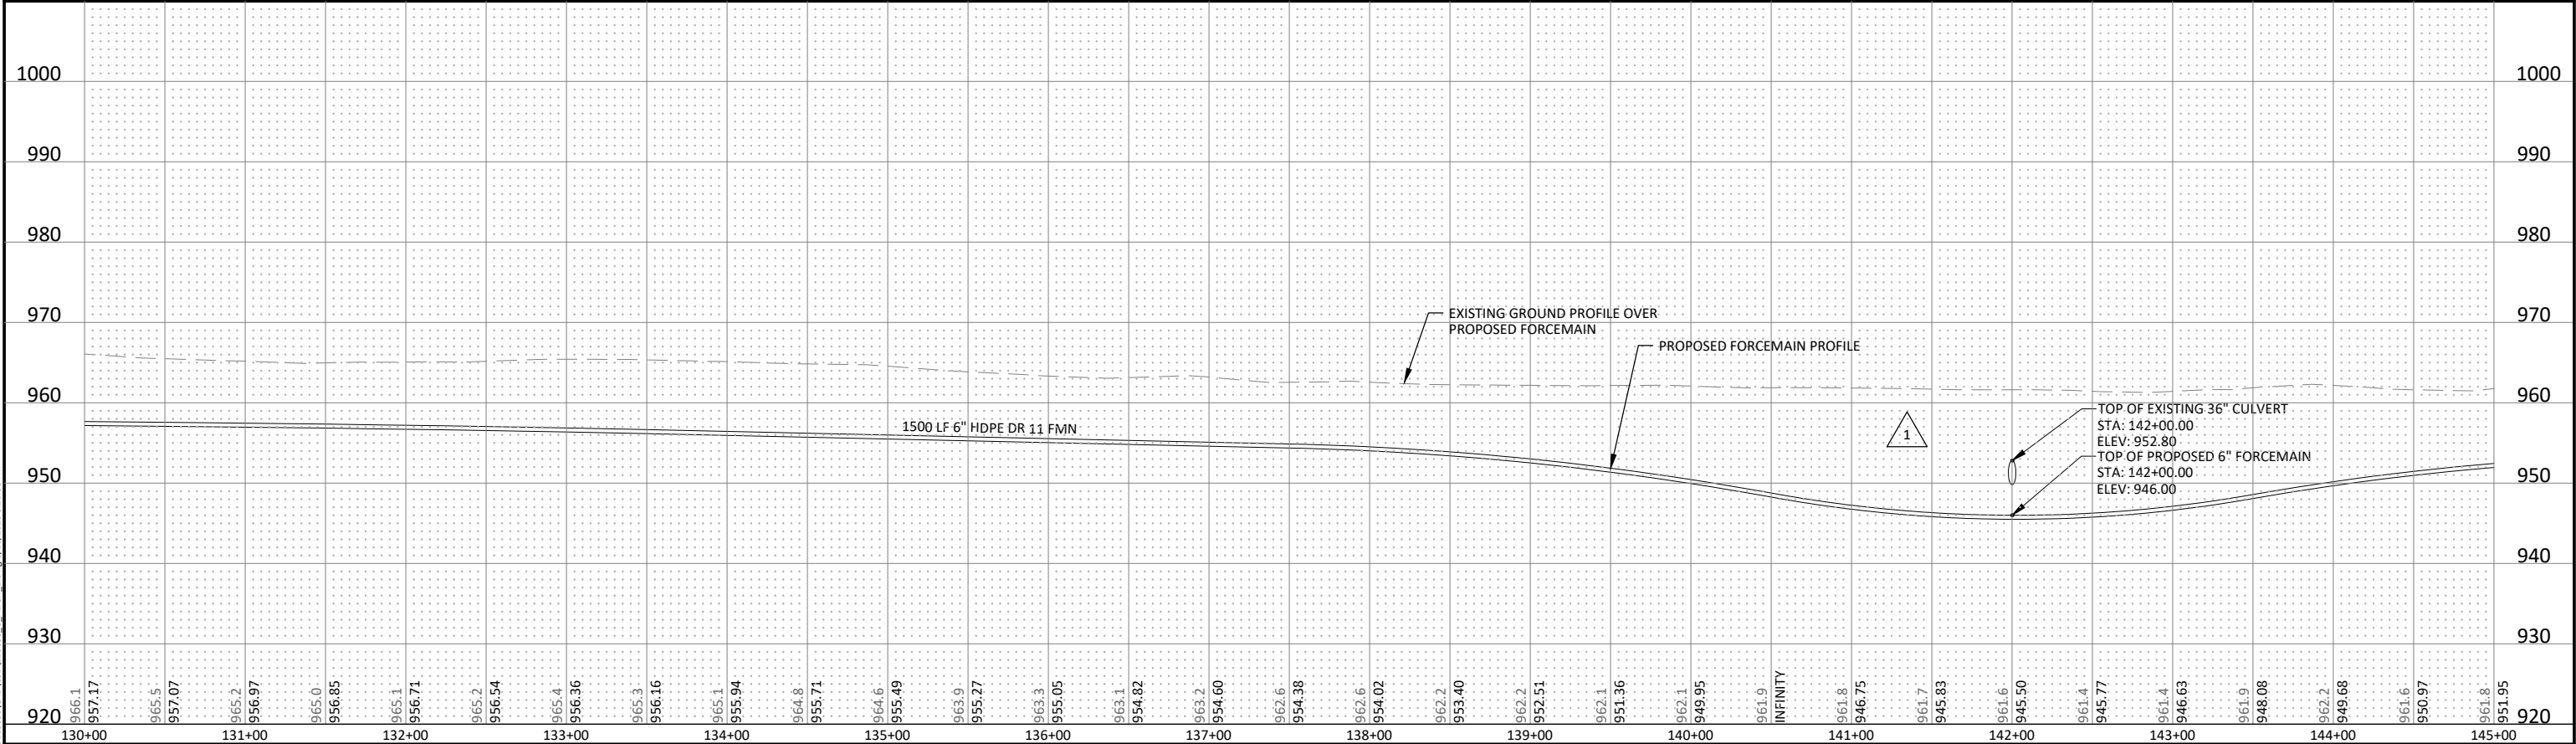

© Bolton & Menk, Inc. 2020. All Rights Reserved.
H:\WASTEWATER\PR\16115896\CAD\CDD\115896_C_ALIGN_1.dwg 6/10/2020 3:21:58 PM



CONTRACTOR: Minger Construction
RECORD PLAN
ZON 12-22-2020

I HEREBY CERTIFY THAT THIS PLAN, SPECIFICATION, OR REPORT WAS PREPARED BY ME OR UNDER MY DIRECT SUPERVISION AND THAT I AM A DULY LICENSED PROFESSIONAL ENGINEER UNDER THE LAWS OF THE STATE OF MINNESOTA.

Kevin F. Bittner
LIC. NO. 21814 DATE 03/01/2019



7533 SUNWOOD DR NW, SUITE 206
RAMSEY, MINNESOTA 55303
Phone: (763) 433-2851
Email: Ramsey@bolton-menk.com
www.bolton-menk.com

DESIGNED	NO.	REVISION	DATE
KFB	1	FMN GR	06/05/20
DRAWN			
KGA			
CHECKED			
KFB			
CLIENT PROJ. NO.			
R16.115896			

ELK RIVER LANDFILL INC.
WASTE WATER FORCEMAIN
FORCEMAIN PLAN & PROFILE
STA. 130+00 TO 145+00

SHEET
29
OF
46