


LEGEND

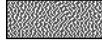

EROSION CONTROL BLANKET,
SEED & FERTILIZER



BITUMINOUS TRAIL PATCH


— PA —

PREASSEMBLED SILT FENCE




EXISTING DRAINAGE FLOW

6" DRILL HDPE DR 11 FORCEMAIN

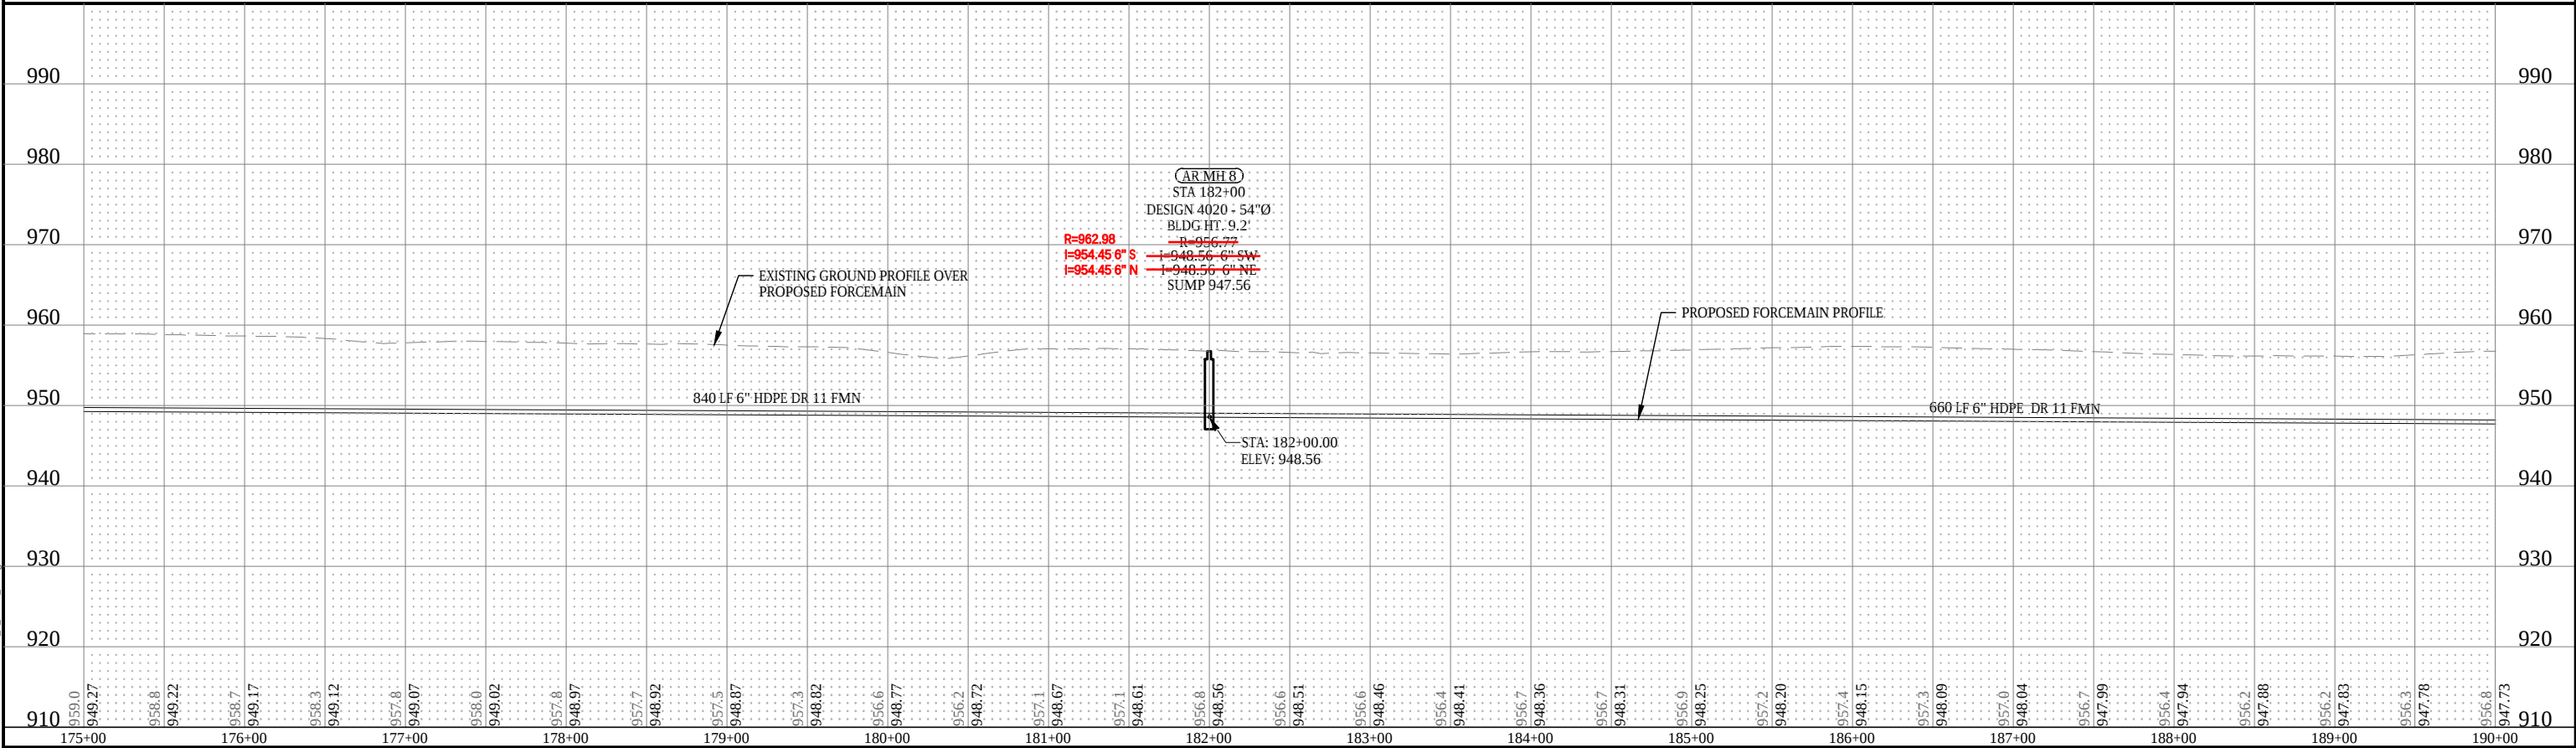

© Bolton & Menk, Inc. 2019. All Rights Reserved.
DRAWN: KGA, CADD: KGA, C. ALLEN, 1.dwg, 3/1/2019 4:09:20 PM

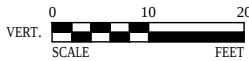

CONTRACTOR: Minger Construction
RECORD PLAN
ZGN 12-22-2020

I HEREBY CERTIFY THAT THIS PLAN, SPECIFICATION, OR REPORT WAS PREPARED
BY ME OR UNDER MY DIRECT SUPERVISION AND THAT I AM A DULY LICENSED
PROFESSIONAL ENGINEER UNDER THE LAWS OF THE STATE OF MINNESOTA.
Kevin F. Bittner
Kevin F. Bittner
LIC. NO. 21814 DATE 03/01/2019



**BOLTON
& MENK**

7533 SUNWOOD DR. NW, SUITE 206
RAMSEY, MINNESOTA 55303
Phone: (763) 433-2851
Email: Ramsey@bolton-menk.com
www.bolton-menk.com

DESIGNED	NO.	REVISION	DATE
KFB			
DRAWN			
KGA			
CHECKED			
KFB			
CLIENT PROJ. NO.			
R16.115896			

ELK RIVER LANDFILL INC.
WASTE WATER FORCEMAIN
FORCEMAIN PLAN & PROFILE
STA. 175+00 TO 190+00

SHEET
32
OF
46