




6" DRILL HDPE DR 11 FORCEMAIN

LEGEND

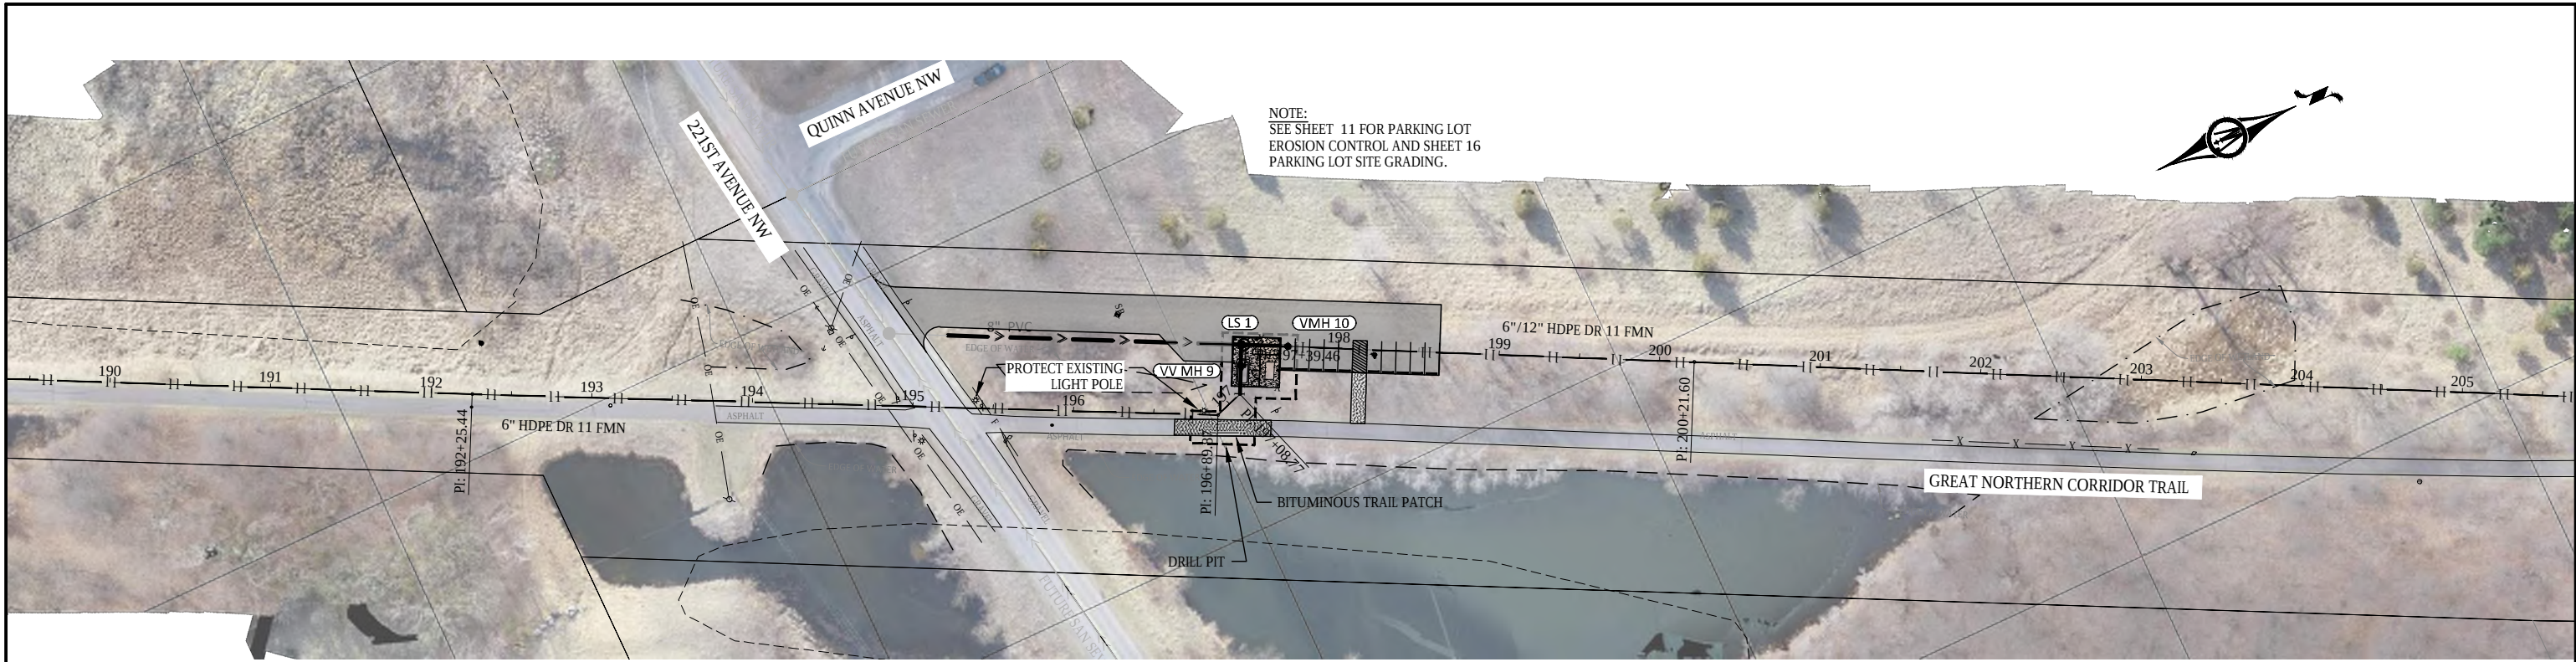

EROSION CONTROL BLANKET,
SEED & FERTILIZER




BITUMINOUS TRAIL PATCH

— PA —

PREASSEMBLED SILT FENCE



EXISTING DRAINAGE FLOW

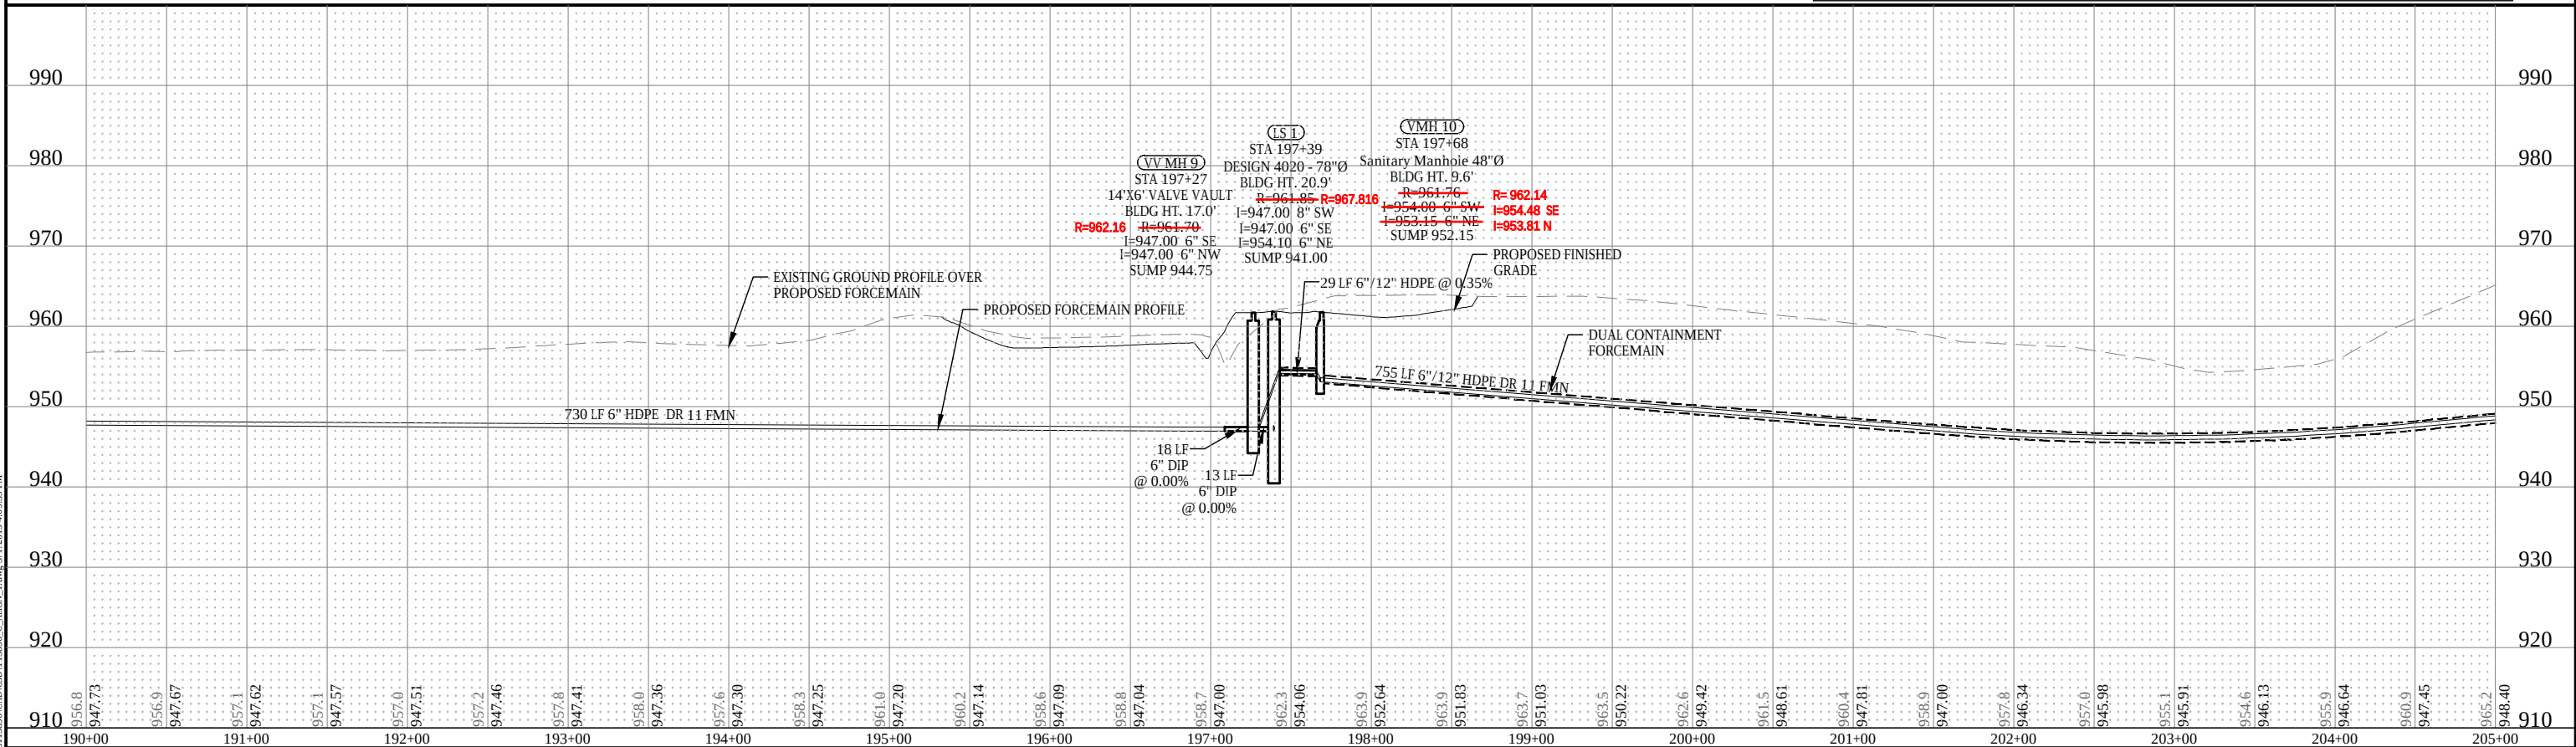

© Bolton & Menk, Inc. 2019. All Rights Reserved.
WASTEWATER FORCEMAIN PROJECT, C. ALLEN, L. JONES, 3/1/2019 4:09:30 PM

HORIZ. SCALE
0 50 100
FEET

VERT. SCALE
0 10 20
FEET

CONTRACTOR: Minger Construction
RECORD PLAN
ZGN 12-22-2020

I HEREBY CERTIFY THAT THIS PLAN, SPECIFICATION, OR REPORT WAS PREPARED
BY ME OR UNDER MY DIRECT SUPERVISION AND THAT I AM A DULY LICENSED
PROFESSIONAL ENGINEER UNDER THE LAWS OF THE STATE OF MINNESOTA.
Kevin F. Bittner
Kevin F. Bittner
LIC. NO. 21814 DATE 03/01/2019



7533 SUNWOOD DR. NW, SUITE 206
RAMSEY, MINNESOTA 55303
Phone: (763) 433-2851
Email: Ramsey@bolton-menk.com
www.bolton-menk.com

DESIGNED	DRAWN	CHECKED	CLIENT PROJ. NO.
KFB	KGA	KFB	R16.115896
NO.	REVISION	DATE	

ELK RIVER LANDFILL INC.
WASTE WATER FORCEMAIN
FORCEMAIN PLAN & PROFILE
STA. 190+00 TO 205+00

SHEET
33
OF
46