



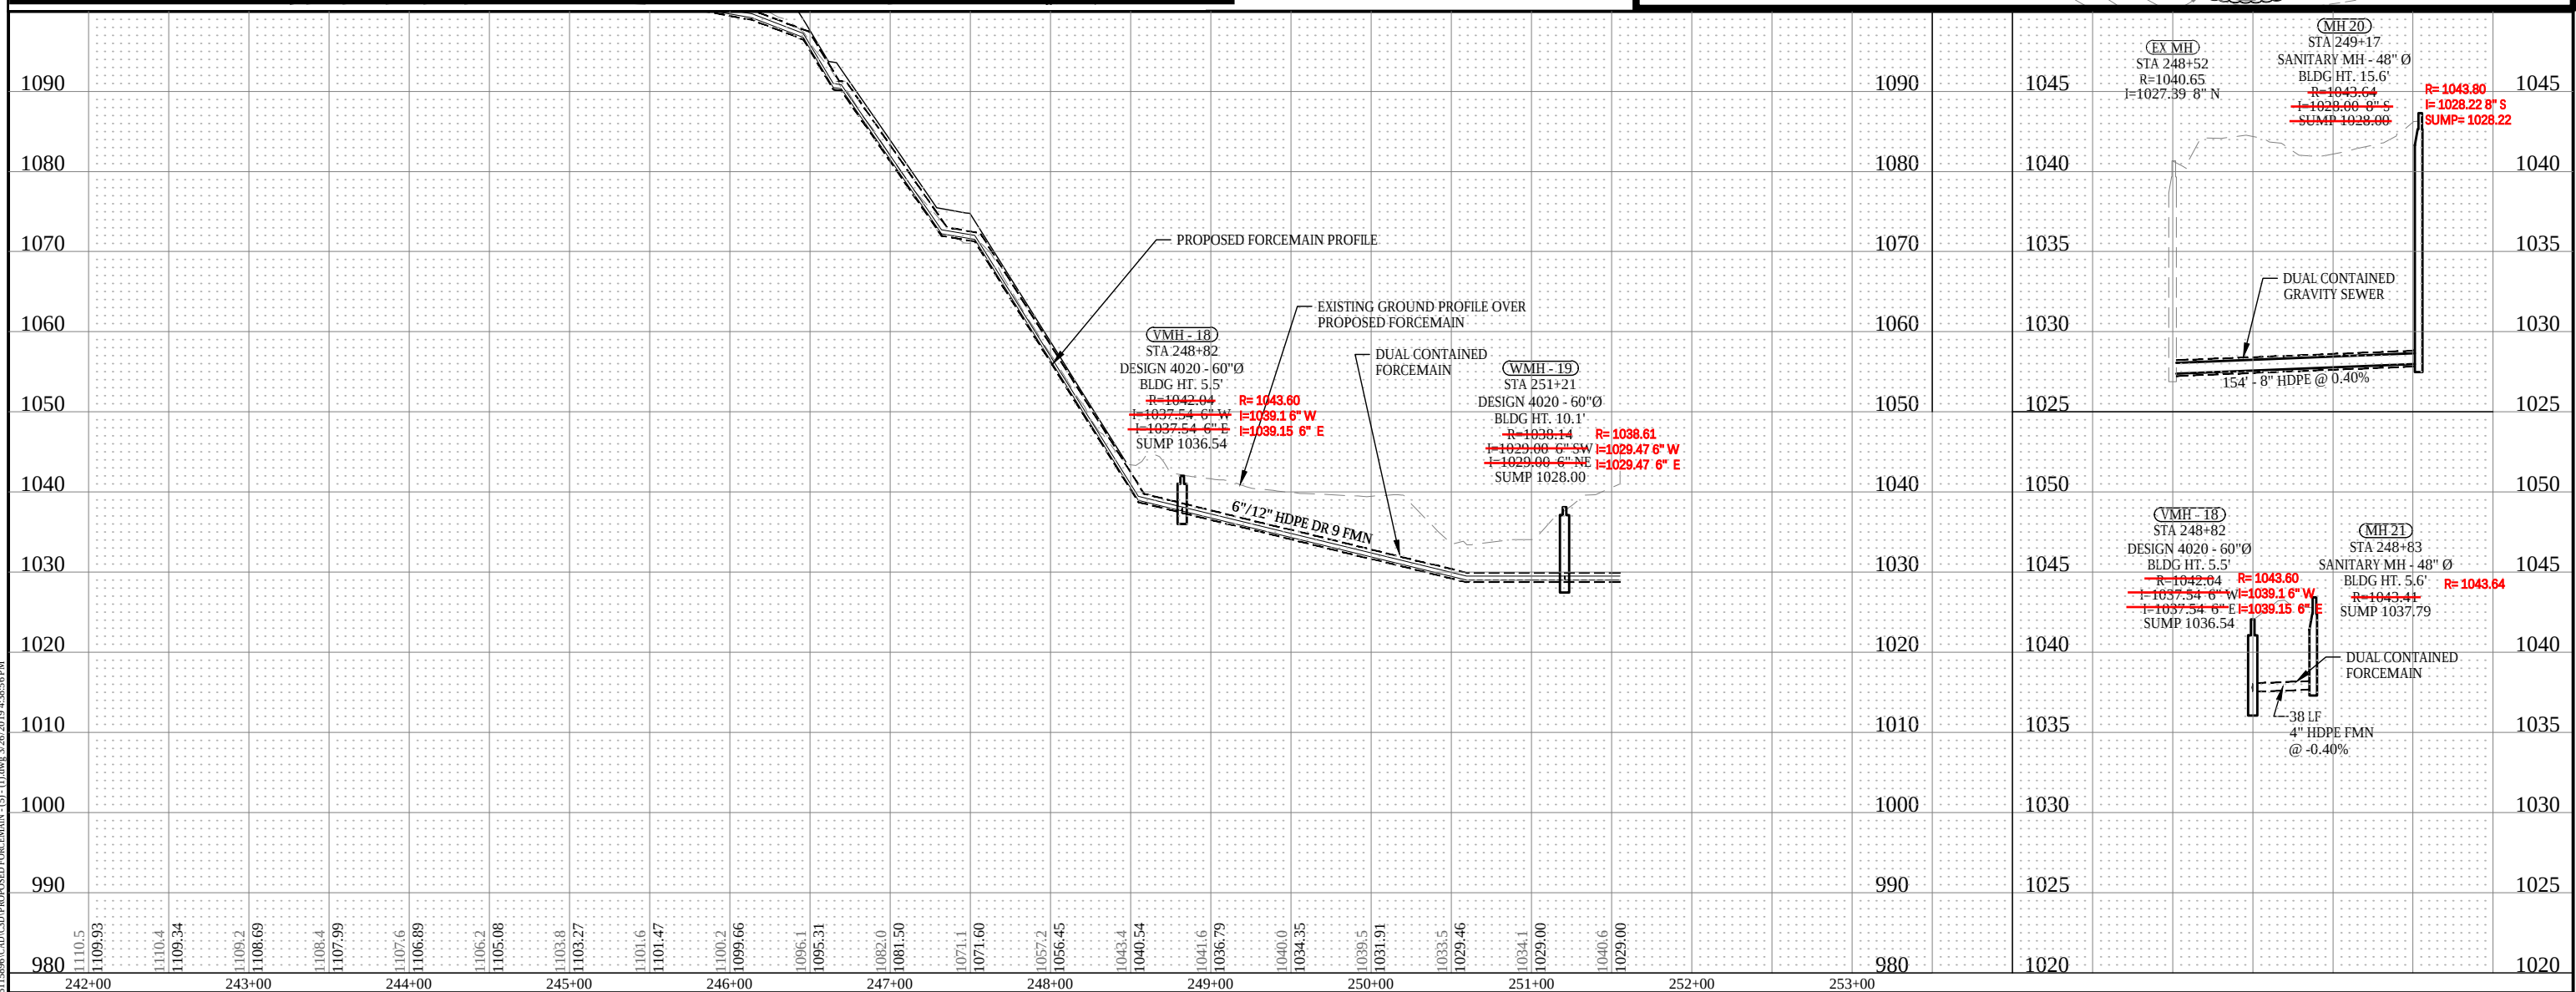

**CONTRACTOR: Minger Construction**  
**RECORD PLAN**  
ZGN 12-22-2020

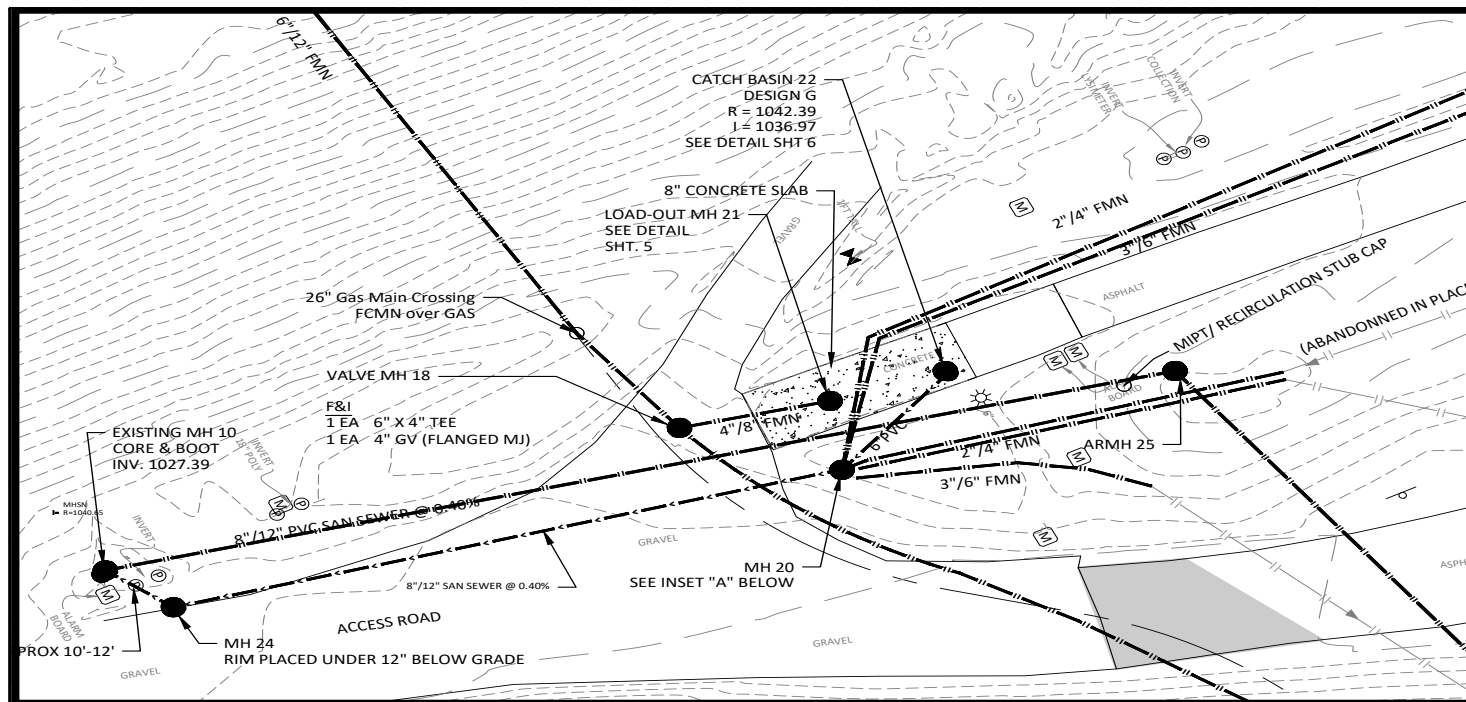

|                                |     |          |      |
|--------------------------------|-----|----------|------|
| DESIGNED                       | NO. | REVISION | DATE |
| KFB                            |     |          |      |
| DRAWN                          |     |          |      |
| KGA                            |     |          |      |
| CHECKED                        |     |          |      |
| KFB                            |     |          |      |
| CLIENT PROJ. NO.<br>R16.115896 |     |          |      |

SHEET  
37  
OF  
46