




© Bolton & Menk, Inc. 2019. All Rights Reserved.
P:\030 - Bolton & Menk\0300 - Elk River - Waste Management Lift Station\Constructs\Electrical\City Station - Details - E7.1.dwg 2/4/2019 7:45:25 AM

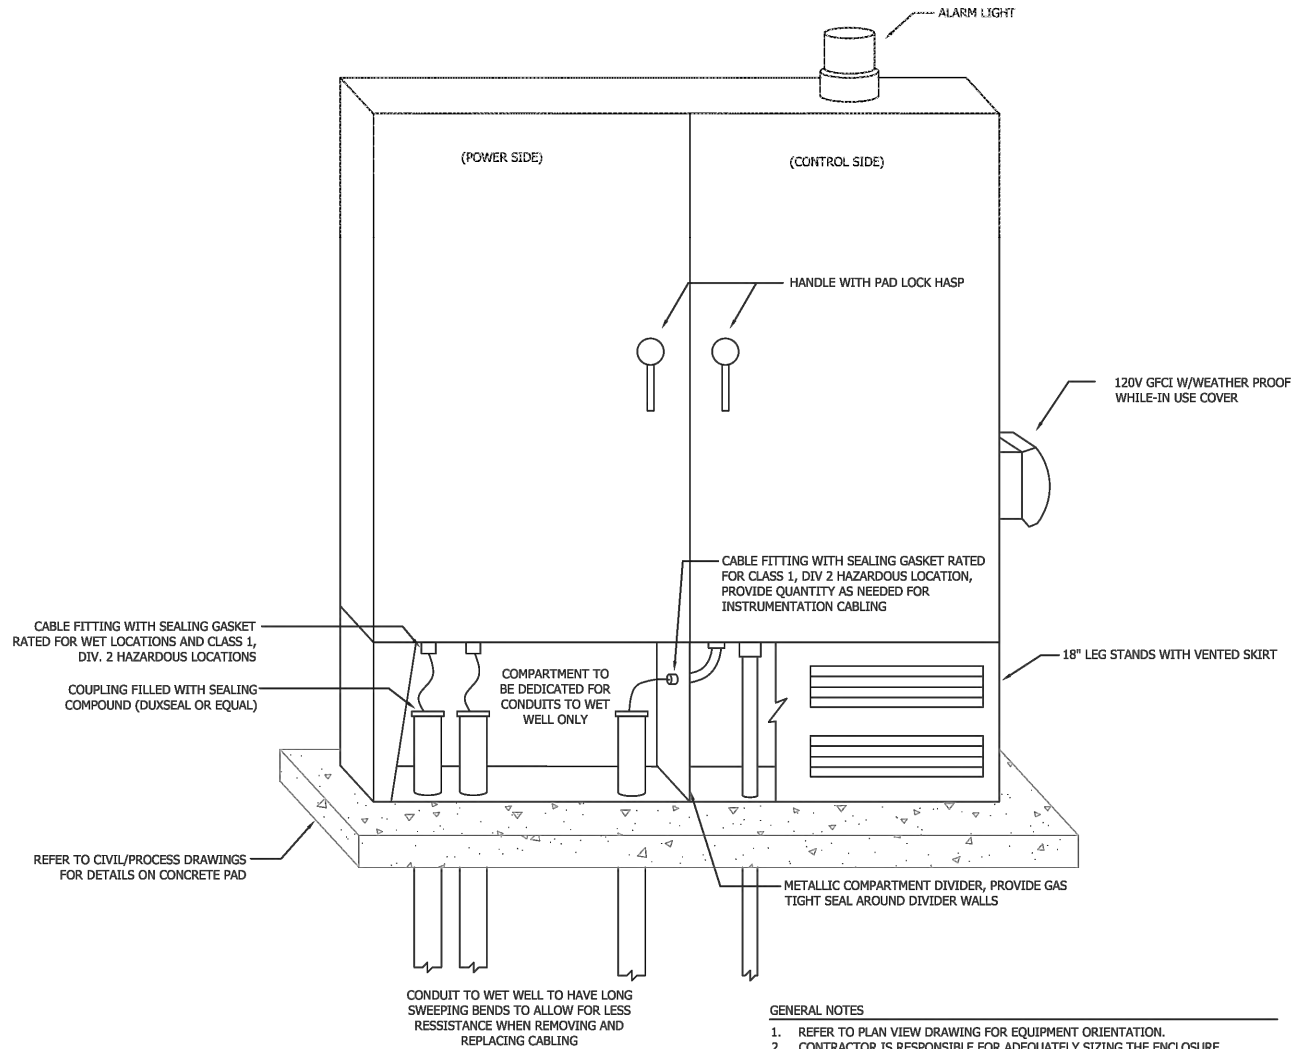


1 CONTROL PANEL ELEVATION
NOT TO SCALE

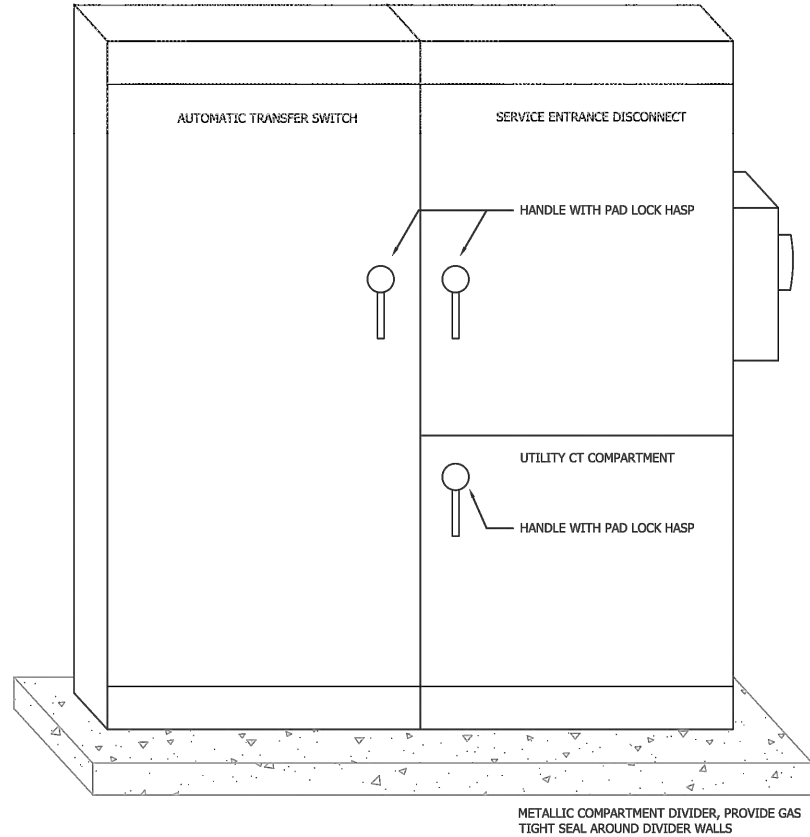


2 SERVICE CABINET ELEVATION
NOT TO SCALE

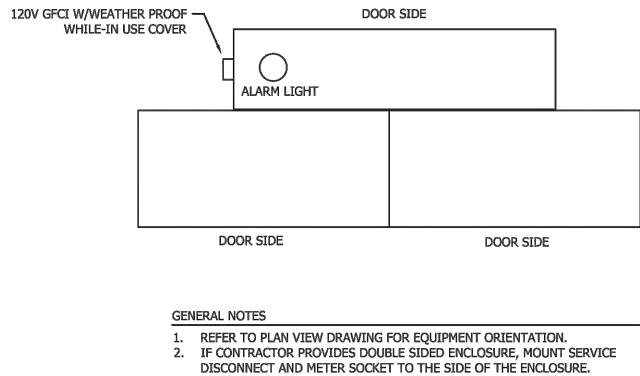

3 CABINETS PLAN VIEW
NOT TO SCALE

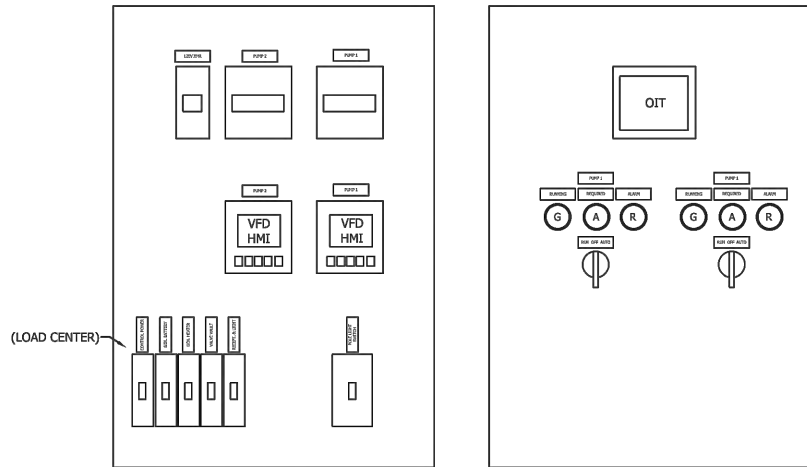

4 CONTROL CABINET INNER DOOR - PROPOSED LAYOUT
NOT TO SCALE

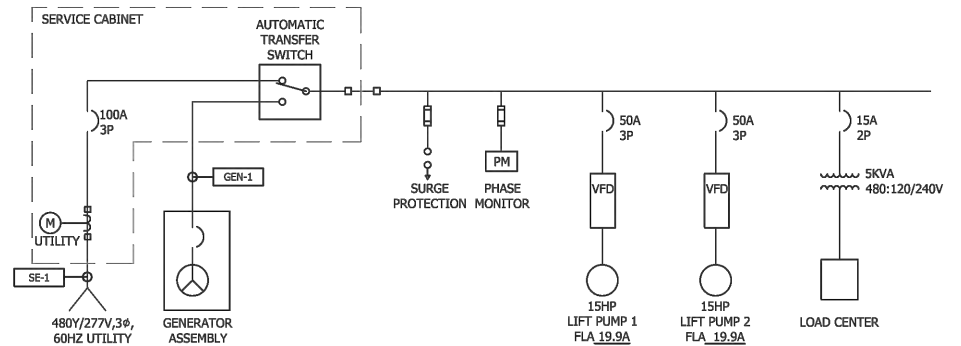

5 ONE-LINE DIAGRAM
NOT TO SCALE

CONTRACTOR: Minger Construction
RECORD PLAN
ZGN 12-22-2020

DESIGN TREE
engineering + land surveying
St. Cloud | Alexandria | Rogers
320-217-5557

I HEREBY CERTIFY THAT THIS PLAN, SPECIFICATION, OR REPORT WAS PREPARED BY ME OR UNDER MY DIRECT SUPERVISION AND THAT I AM A DULY LICENSED PROFESSIONAL ENGINEER UNDER THE LAWS OF THE STATE OF MINNESOTA.

SIGNATURE: *Aaron R. Mueller* TYPED OR PRINTED NAME: AARON R. MUELLER

DATE: 02/01/19 U.C. NO.: 46184

BOLTON & MENK

7533 SUNWOOD DR NW, SUITE 206
RAMSEY, MINNESOTA 55303
Phone: (763) 433-2851
Email: Ramsey@bolton-menk.com
www.bolton-menk.com

DESIGNED	NO.	REVISION	DATE
ARM			
DRAWN			
CAB			
CHECKED			
ARM			
CLIENT PROJ. NO.			
R16.115896			

ELK RIVER LANDFILL INC.
WASTE WATER FORCEMAIN
CITY LIFT STATION - ELECTRICAL DETAILS

SHEET
40
OF
46