


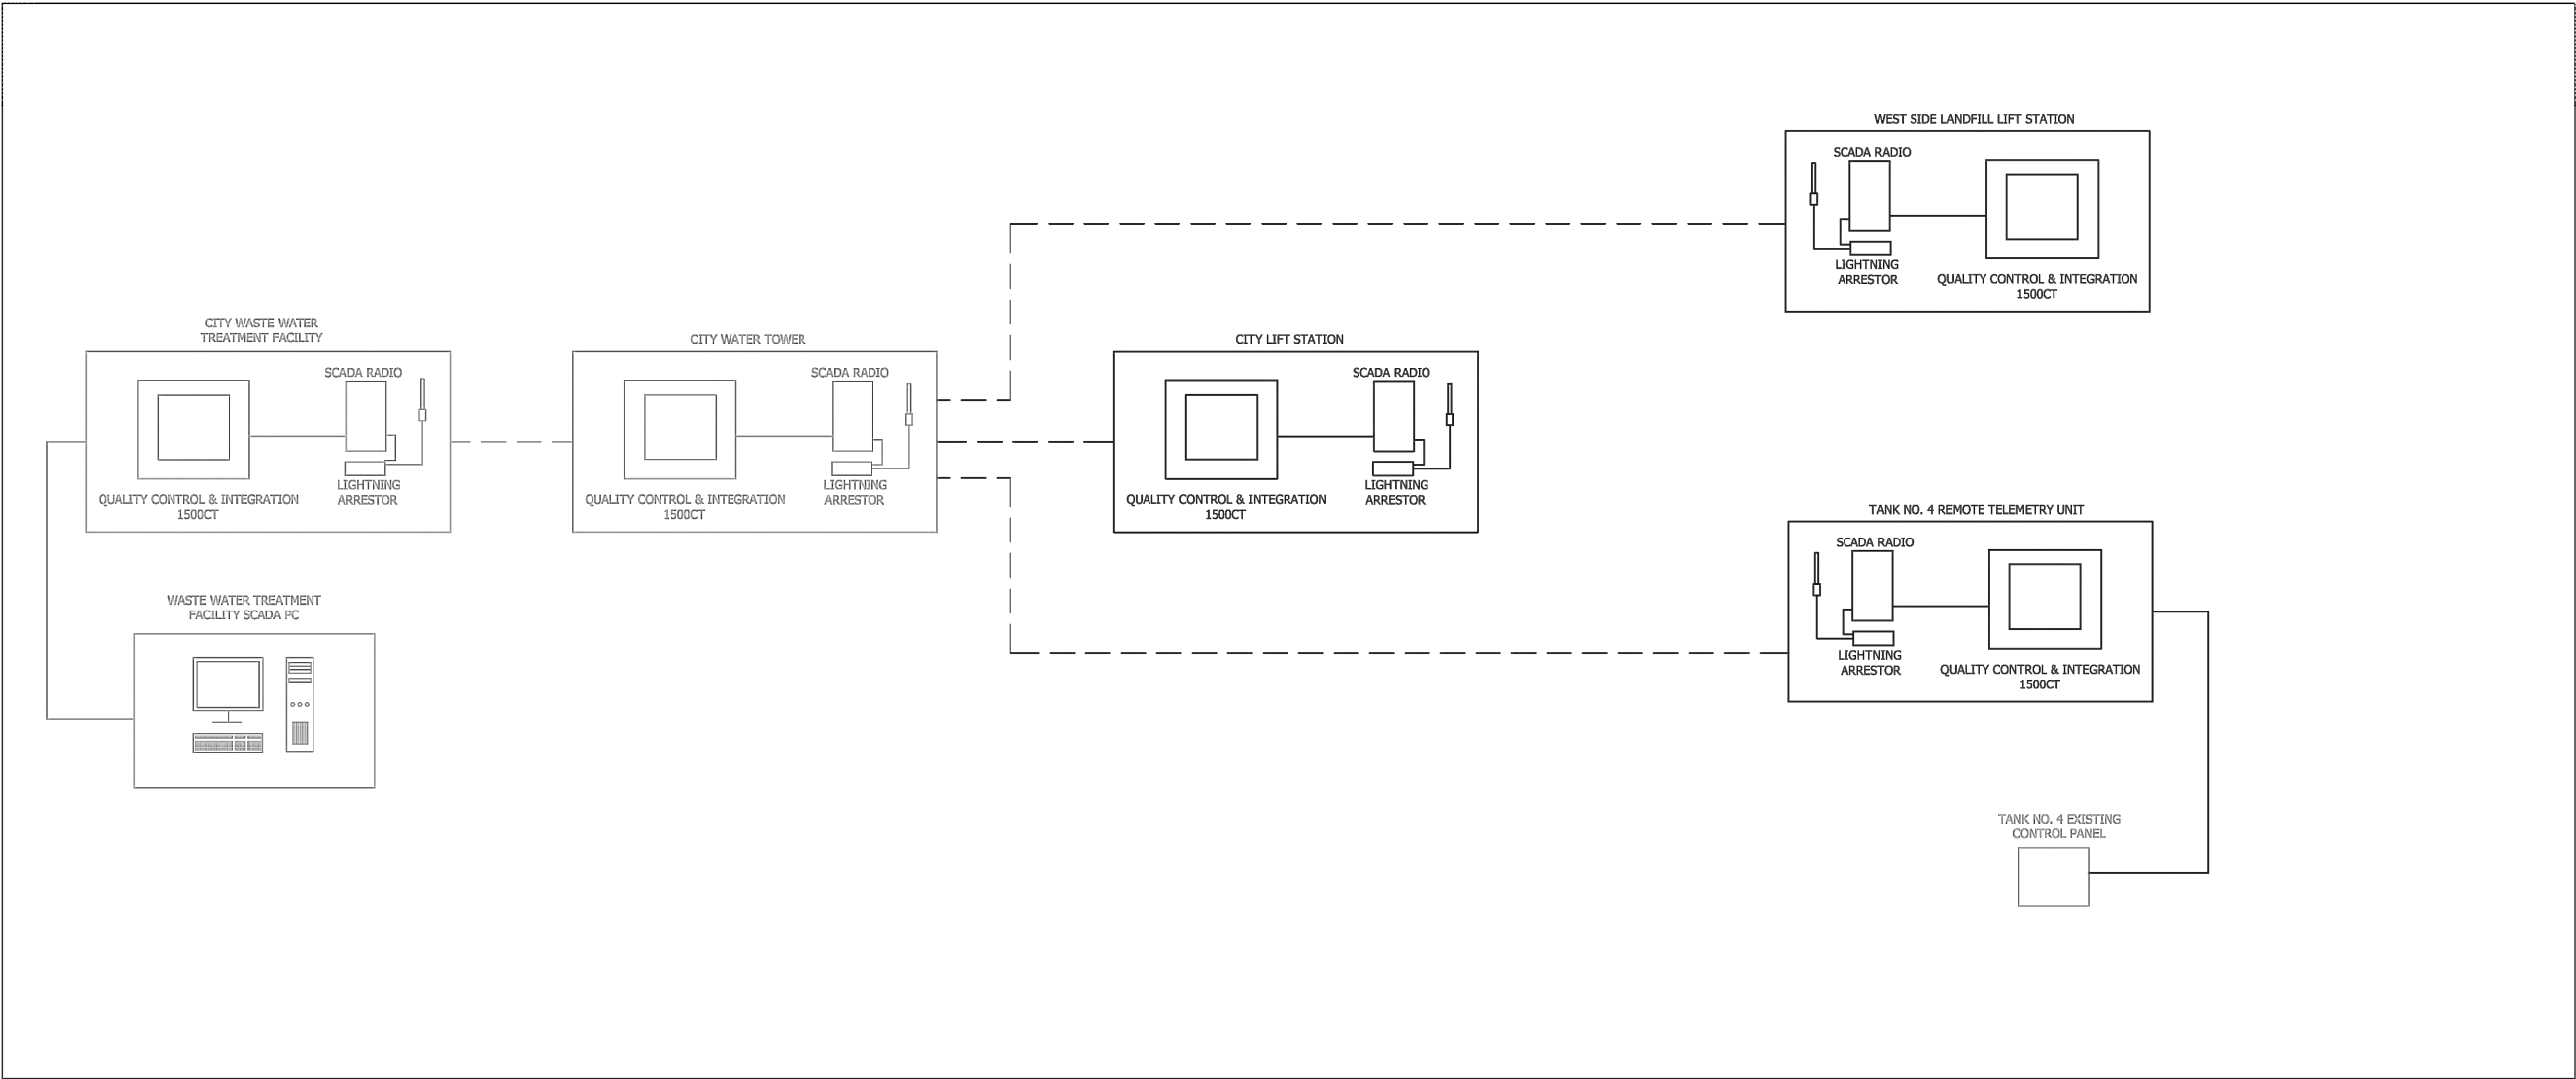

- GENERAL NOTES:
1. PROPOSED RADIO COMMUNICATION PATHS ARE SHOWN IN DASHED LINES, HARDWIRE CONNECTIONS SHOWN IN SOLID LINES.
 2. EQUIPMENT AND CONNECTIONS SHOWN IN LIGHT (GRAY) LINES ARE EXISTING. EQUIPMENT AND CONNECTIONS SHOWN IN DARK LINES REPRESENT NEW.
 3. CONTRACTOR TO PROVIDE TELEMETRY STUDY TO VERIFY RELIABLE COMMUNICATION PATH FOR NEW EQUIPMENT. CONTRACTOR SHALL PROVIDE ENGINEER WITH STUDY RESULTS AND FINAL RECOMMENDATIONS FOR RELIABLE RADIO PATHS.

1 PROPOSED TELEMETRY DETAIL
NOT TO SCALE

© Bolton & Menk, Inc. 2019. All Rights Reserved
R:\090 - Bolton & Menk\09018001 - Elk River - Waste Management Lift Station\Construct\Electrical\SCADA Diagram - EB.1.dwg 2/4/2019 7:46:02 AM

CONTRACTOR: Minger Construction
RECORD PLAN
ZGN 12-22-2020

DESIGN TREE
engineering + land surveying
St. Cloud | Alexandria | Rogers
320-217-5557

I HEREBY CERTIFY THAT THIS PLAN, SPECIFICATION, OR REPORT WAS PREPARED BY ME OR UNDER MY DIRECT SUPERVISION AND THAT I AM A DULY LICENSED PROFESSIONAL ENGINEER UNDER THE LAWS OF THE STATE OF MINNESOTA.
SIGNATURE:  TYPED OR PRINTED NAME: AARON R. MUELLER
DATE: 02/01/19 U.C. NO.: 46184



BOLTON & MENK

7533 SUNWOOD DR NW, SUITE 206
RAMSEY, MINNESOTA 55303
Phone: (763) 433-2851
Email: Ramsey@bolton-menk.com
www.bolton-menk.com

DESIGNED	NO.	REVISION	DATE
ARM			
DRAWN			
CAB			
CHECKED			
ARM			
CLIENT PROJ. NO.			
R16.115896			

ELK RIVER LANDFILL INC.
WASTE WATER FORCEMAIN
SCADA COMMUNICATIONS DIAGRAM

SHEET
46
OF
46