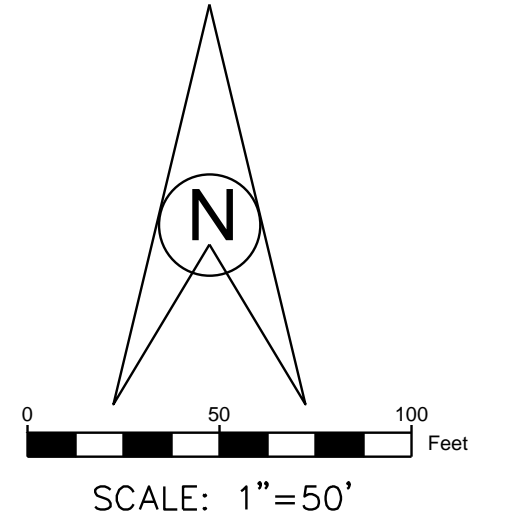


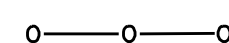
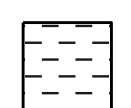


RECORD PLANS: 2-1-22  
 CONTRACTOR: BURSCHVILLE  
 CONSTRUCTION, INC.

SITE IS WITHIN ONE MILE OF UPPER ORONO LAKE (IMPAIRED WATER)  
 HOWEVER, NO RUNOFF IS PROPOSED TO DRAIN TO THIS WATER BODY.



-  DENOTES GREEN AREA INLET PROTECTION
-  DENOTES IN-STREET INLET PROTECTION
- SF — SF DENOTES PRE-CONSTRUCTION SILT FENCE
-  DENOTES SILT FENCE TO BE INSTALLED AFTER GRADING & UTILITY COMPLETION
-  DENOTES MN/DOT CAT. 3 EROSION CONTROL BLANKET WITH BIODEGRADABLE NETTING & SEED

TEMPORARY RESTORATION: MNDOT SEED MIX 25-121, TYPE 1 MULCH & 12-5-10 TYPE 3 FERTILIZER  
 PERMANENT RESTORATION: SEED OR SOD (PER HOMEOWNER)

INFILTRATION BASIN SHOULD BE LEFT 3' HIGH UNTIL UPGRADIENT AREAS ARE FULLY STABILIZED

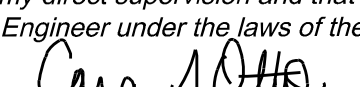
NO HEAVY EQUIPMENT OR CONSTRUCTION TRAFFIC ALLOWED IN BASIN AREA!!

MNDOT SEED MIX 33-261 WITH MNDOT CAT. 3N EROSION CONTROL BLANKET

INSTALL MNDOT CAT. 3 EROSION CONTROL BLANKET W/ BIODEGRADABLE NATURAL NETTING & SEED BETWEEN CURB & PROPERTY LINE

TEMPORARY RESTORATION: MNDOT SEED MIX 25-121, TYPE 1 MULCH & 12-5-10 TYPE 3 FERTILIZER  
 PERMANENT RESTORATION: SEED OR SOD (PER HOMEOWNER)

REV. NO.	DATE	BY	DESCRIPTION

DESIGNED C.S.O.	DRAWN T.J.B.	I hereby certify that this plan, specification, or report was prepared by me or under my direct supervision and that I am a duly Licensed Professional Engineer under the laws of the State of Minnesota.   Cara M. Schwahn Otto License # 40433 Date: 4-8-22
CHECKED C.S.O.		

 **OTTO ASSOCIATES**  
 Engineers & Land Surveyors, Inc.  
 www.ottoassociates.com  
 9 West Division Street  
 Buffalo, MN 55313  
 (763)682-4727  
 Fax: (763)682-3522

**PRESTIGIOUS WOODLAND HILLS FIFTH ADDITION**  
 BENZINGER PROPERTIES  
 ELK RIVER, MN

**STORMWATER POLLUTION PREVENTION PLAN**  
 SHEET NO. 10 OF 13 SHEETS

PROJECT NO: 19-0318  
 DATE: 2-1-22