


RECORD PLANS: 2-1-22 CONTRACTOR: BURSCHVILLE CONSTRUCTION, INC.

| REV. NO. | DATE | BY | DESCRIPTION | DESIGNED | DRAWN |
|----------|------|----|-------------|----------|--------|
| | | | | C. S. O. | T.J.B. |
| | | | | | |
| | | | | CHECKED | |
| | | | | C. S. O. | |
| | | | | | |



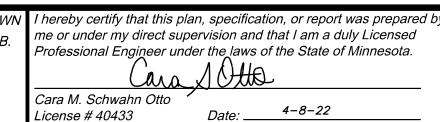

PRESTIGIOUS WOODLAND HILLS FIFTH ADDITION
BENZINGER PROPERTIES
ELK RIVER, MN

| | PROJECT NO: 19-0318 | | | | | |
|-----------|---------------------|----|----|--------|-------|--------|
| SHEET NO. | 11 | OF | 13 | SHEETS | DATE: | 2-1-22 |