










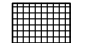


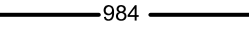


**LEGEND:**

-  PROPOSED RIP RAP
-  PROPOSED CONTOUR
-  PROPOSED STORM SEWER
-  PROPOSED WATER LINE
-  PROPOSED SANITARY SEWER
-  PROPOSED WATER SERVICE
-  PROPOSED SANITARY SERVICE
-  PROPOSED CATCH BASIN
-  PROPOSED FLARED END SECITON
-  PROPOSED STORM MANHOLE
-  PROPOSED GATE VALVE & BOX
-  PROPOSED HYDRANT
-  PROPOSED SANITARY MANHOLE
-  AS-BUILT CONTOUR

CONSTRUCTION OF PROJECT SHALL MEET CITY OF ELK RIVER DESIGN STANDARDS (LAST REVISION AUGUST 2017) UNLESS PLANS INDICATES OTHERWISE.

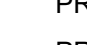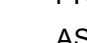
**RECORD DRAWING**

RECORD DRAWING  
MEASURED BY: MWCK @ BPA (04-18-22)  
  
DRAWN BY MW @ BPA

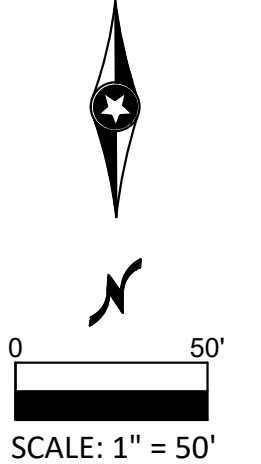

REV NO.	DATE	DESCRIPTION
1	02/22/2021	DRAWINGS ISSUED TO CITY
2	03/12/2021	DRAWINGS REVISED PER CITY REVIEW
3	03/30/2021	MPCA REVIEW
4	04/21/2021	FINAL CONSTRUCTION PLANS
5	05/14/2021	DRAWINGS REVISED PER 2ND CITY REVIEW
6	06/30/2021	ADDENDUM 1
		21-0046.00
		FILE NO.:
		RECORD AS-BUILT DRAWINGS


I hereby certify that this plan, specification, or report was prepared by me or under my direct supervision and that I am a duly Licensed Professional Engineer under the laws of the State of Minnesota.

Signed:  Christopher J. Dahn Lic. No. 58628  
Date: 04/18/2022

**BOGART, PEDERSON & ASSOCIATES, INC.**  
LAND SURVEYING  
ENVIRONMENTAL SERVICES  
13076 FIRST STREET, BECKER, MN 55308-9322  
TEL: 763-262-8822 FAX: 763-262-8844

**TRANQUIL MEADOWS  
RESIDENTIAL DEVELOPMENT  
PROVIDENCE S&S, LLC**  
City of Elk River, Sherburne County, MN  
SANITARY & WATERMAIN - 190 HALF AVE NW

SHEET NO.  
**C8**

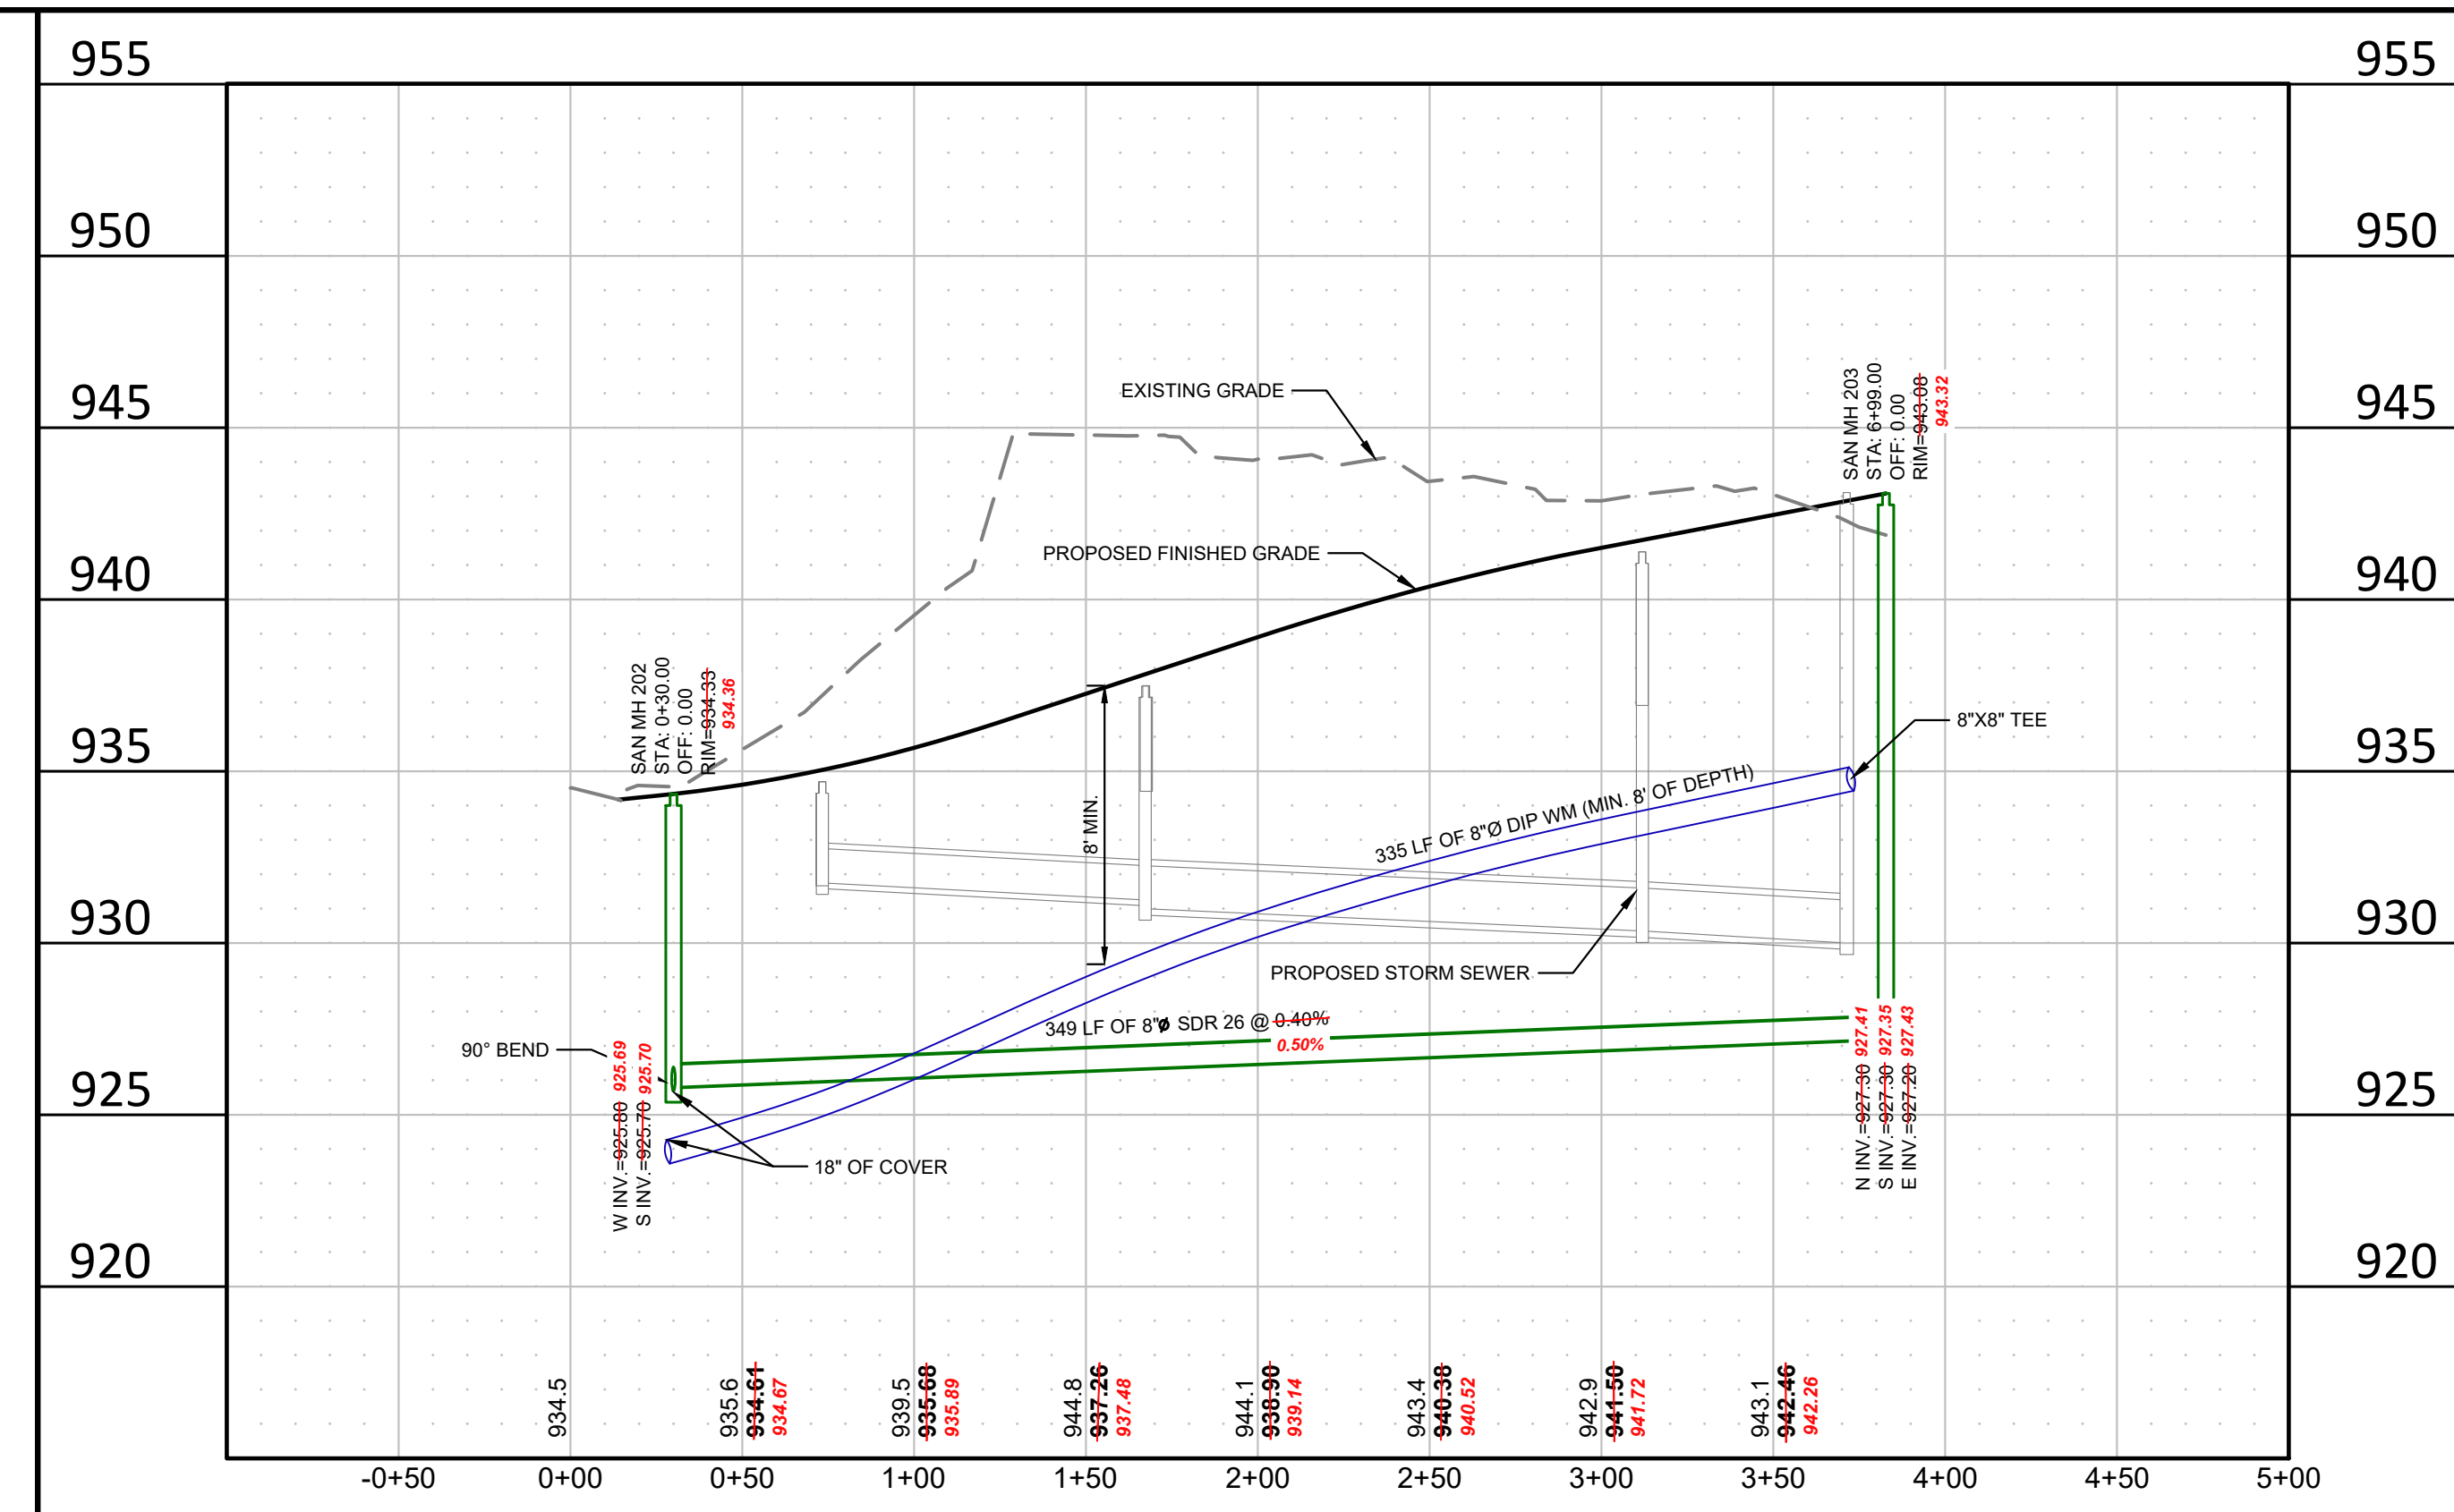

SCALE:  
HORIZONTAL: 1"=50'  
VERTICAL: 1"=5'