








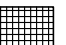

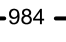

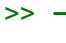


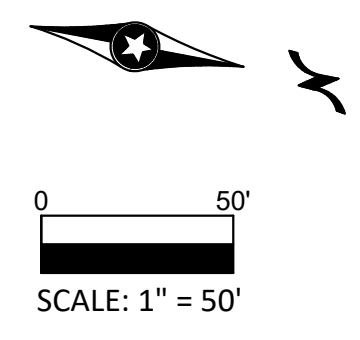
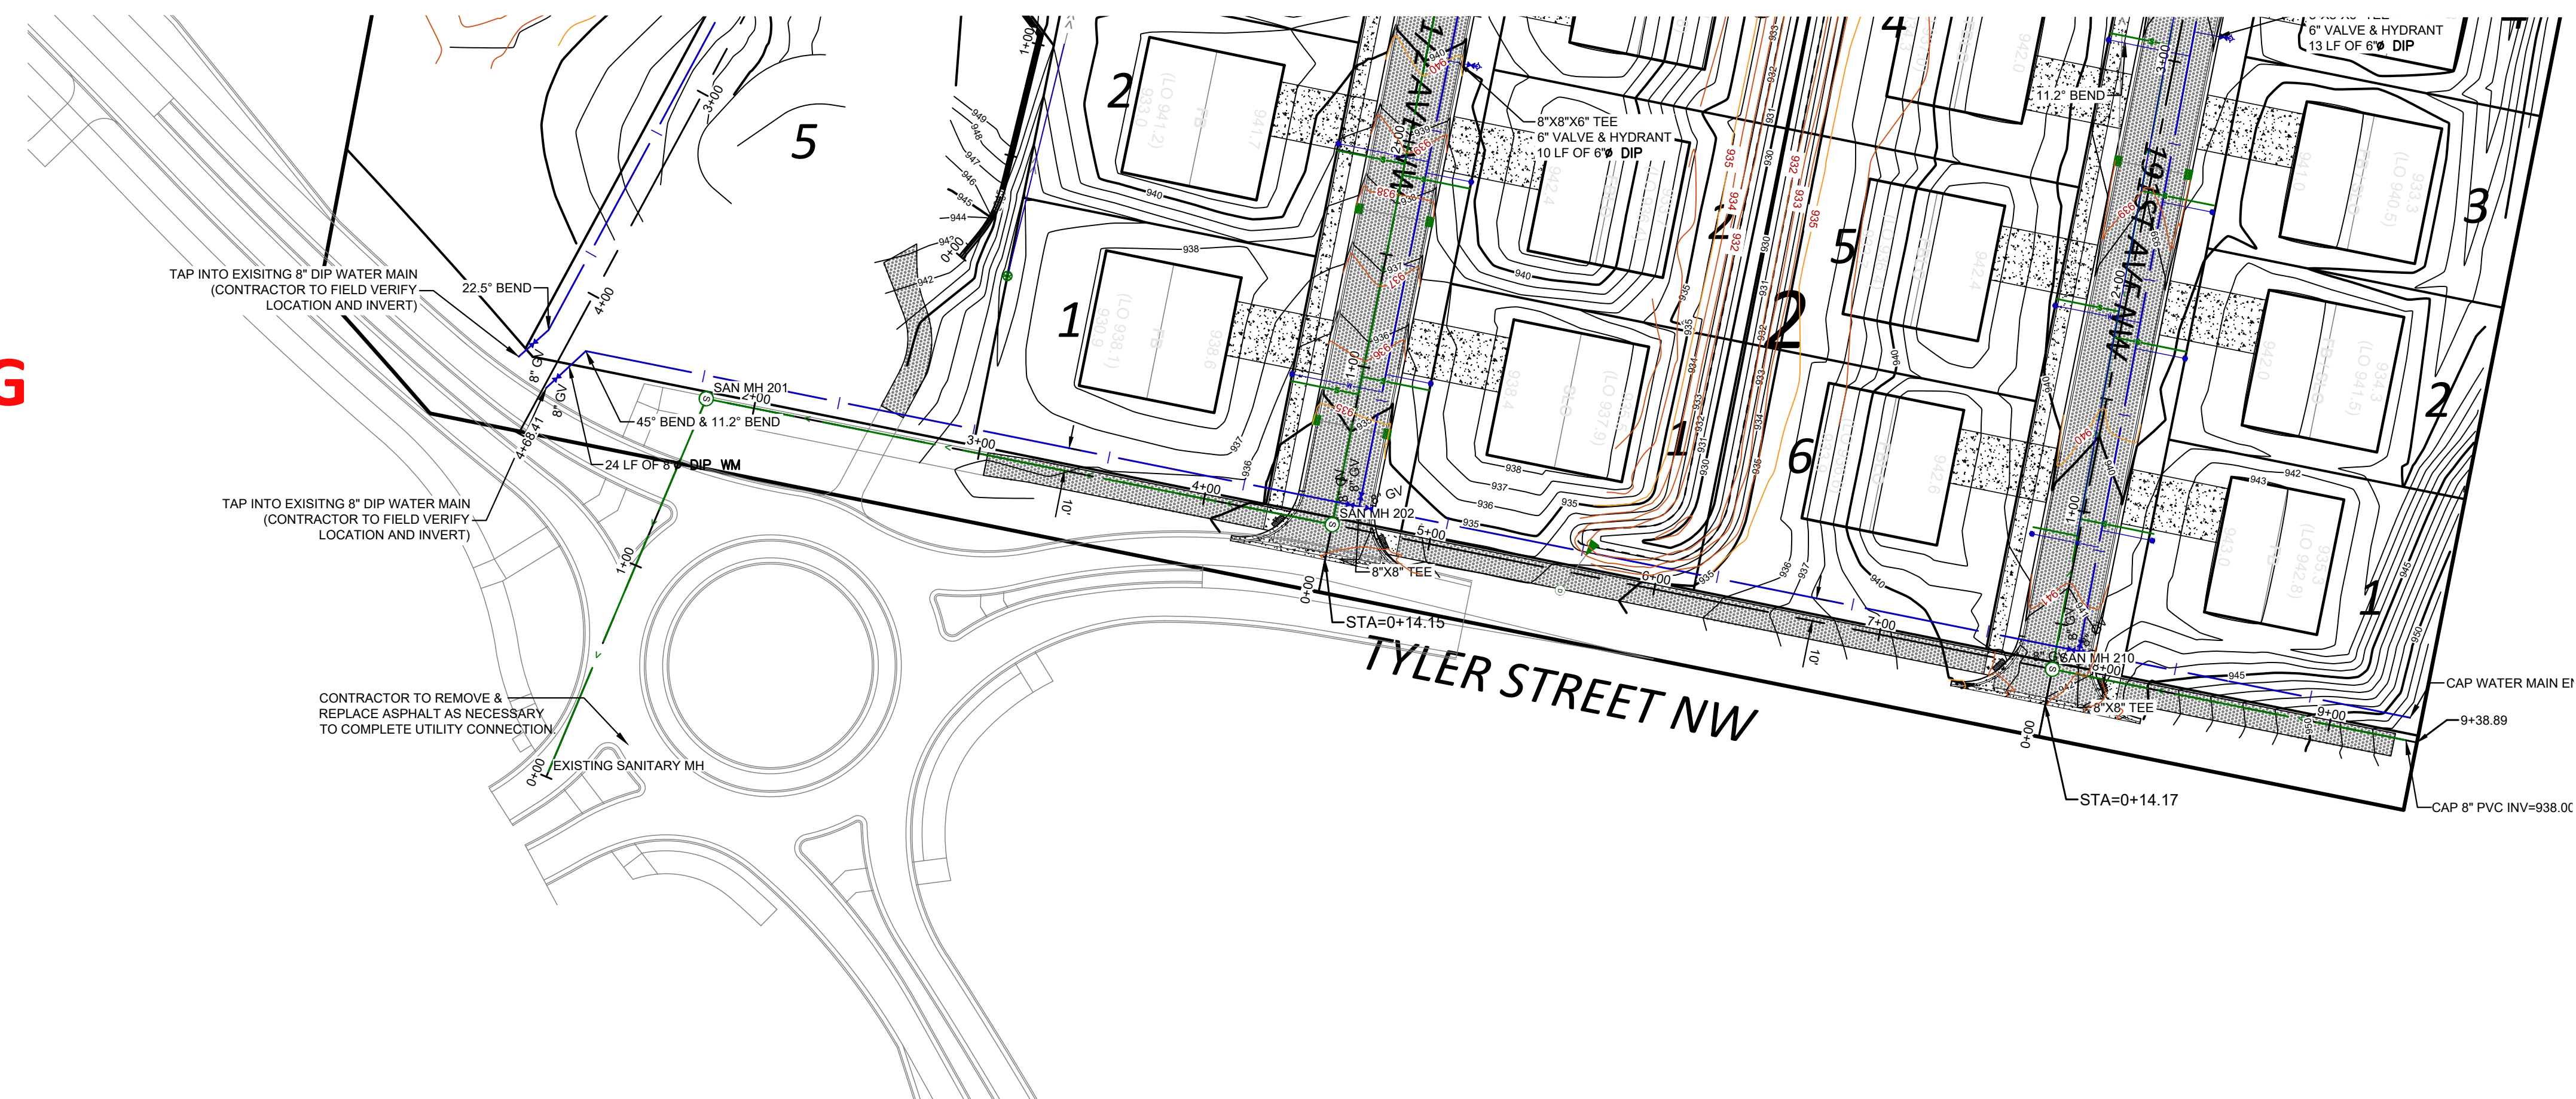
**LEGEND:**

-  PROPOSED RIP RAP
-  PROPOSED CONTOUR
-  PROPOSED STORM SEWER
-  PROPOSED WATER LINE
-  PROPOSED SANITARY SEWER
-  PROPOSED WATER SERVICE
-  PROPOSED SANITARY SERVICE
-  PROPOSED CATCH BASIN
-  PROPOSED FLARED END SECTION
-  PROPOSED STORM MANHOLE
-  PROPOSED GATE VALVE & BOX
-  PROPOSED HYDRANT
-  PROPOSED SANITARY MANHOLE
-  AS-BUILT CONTOUR

CONSTRUCTION OF PROJECT SHALL MEET CITY OF ELK RIVER DESIGN STANDARDS (LAST REVISION AUGUST 2017) UNLESS PLANS INDICATES OTHERWISE.

**RECORD DRAWING**

RECORD DRAWING  
 MEASURED BY: MW/CK @ BPA (04-18-22)  
 DRAWN BY MW @ BPA




REV NO.	DATE	DESCRIPTION
1	02/22/2021	DRAWINGS ISSUED TO CITY
2	03/12/2021	DRAWINGS REVISED PER CITY REVIEW
3	03/30/2021	MPCA REVIEW
4	04/21/2021	FINAL CONSTRUCTION PLANS
5	05/14/2021	DRAWINGS REVISED PER 2ND CITY REVIEW
6	06/30/2021	ADDENDUM 1
	04/18/2022	RECORD AS-BUILT DRAWINGS

DATE: 02/22/2021  
 DESIGN BY: MJM  
 DRAWN BY: MJM  
 CHECKED BY: CJD  
 DWG FILE: GRADING  
 FILE NO.: 21-10040.00

I hereby certify that this plan, specification, or report was prepared by me or under my direct supervision and that I am a duly Licensed Professional Engineer under the laws of the State of Minnesota.

Signed: Christopher J. Dahn  
 Lic. No. 56628  
 Date: 04/18/2022

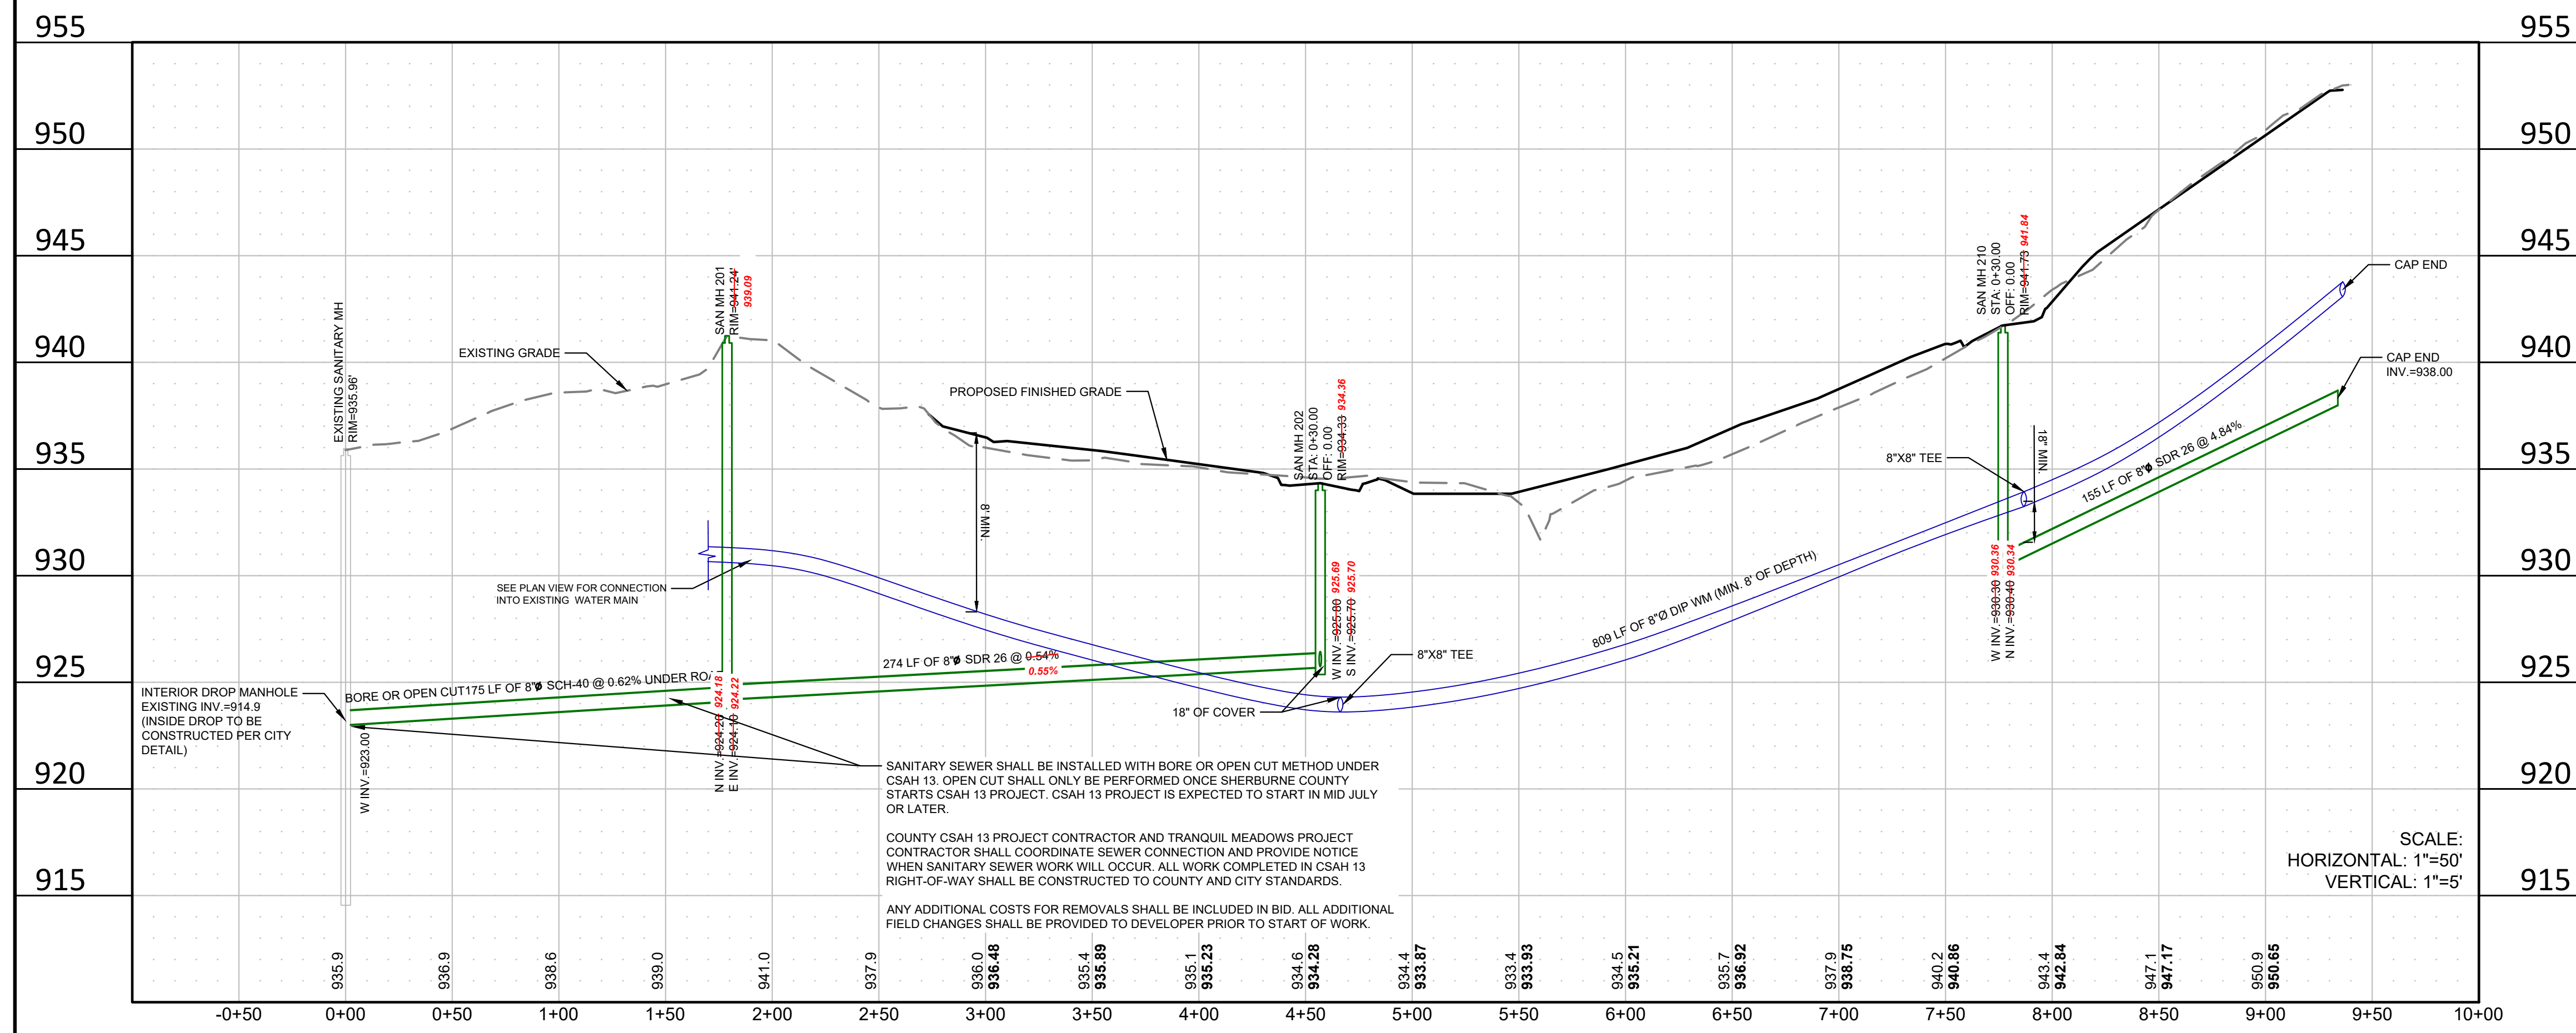

**BOGART, PEDERSON & ASSOCIATES, INC.**  
 LAND SURVEYING  
 ENVIRONMENTAL SERVICES  
 13076 FIRST STREET, BECKER, MN 55309-9322  
 TEL: 763-262-8822 FAX: 763-262-8844

**TRANQUIL MEADOWS  
 RESIDENTIAL DEVELOPMENT  
 PROVIDENCE S&S, LLC**  
 City of Elk River, Sherburne County, MN  
 SANITARY & WATERMAIN - EAST CONNECTION

SHEET NO.  
**C10**