PROJECT NAME: TRANQUIL MEADOWS RESIDENTIAL DEVELOPMENT LOCATION: 18990 TWIN LAKES PKWY NW, ELK RIVER, MN 55330

STORMWATER DISCHARGES ASSOCIATED WITH CONSTRUCTION ACTIVITY.

SHERBURNE COUNTY LAT/LONG: 45.315915, -93.542197

DESCRIPTION OF CONSTRUCTION ACTIVITY

DEVELOPMENT CONSISTS OF PAVEMENT AND STRUCTURE DEMOLITION, MASS GRADING, EROSION CONTROL, UTILITY INSTALLATION, ROAD SECTION PLACEMENT, AND TURF ESTABLISHMENT.

PROJECT CONTACTS

PROVIDENCE S&S, LLC AND THE CONTRACTOR ARE RESPONSIBLE FOR IMPLEMENTATION OF THE SWPPP AND THE INSTALLATION, INSPECTION, AND MAINTENANCE OF THE EROSION PREVENTION AND SEDIMENT CONTROL BMP'S BEFORE AND DURING CONSTRUCTION.

OWNER:

CHRISTOPHER DAHN

-BOGART, PEDERSON & ASSOCIATES ENGINEER AND SWPPP DESIGNER (EXP 2022) TRAINING:

ADDRESS: 13076 FIRST STREET

BECKER, MN 53308-9322

TELEPHONE: 763-262-8822 EMAIL; CDAHN@BOGART-PEDERSON,COM

OWNER CONTACT: STEPHEN ROHLF - PROVIDENCE S&S, LLC

ADDRESS: 17094 VANCE ST. NW, ELK RIVER, MN 55330

TELEPHONE: (763) 234-0177

SROHLF@CORNERSTONEAUTO.COM EMAIL:

BUSINESS NAME

OWNER NAME MAILING ADDRESS CITY **TELEPHONE** FMAII CONTACT NAME

ESTIMATED DATES OF CONSTRUCTION

MAILING ADDRESS

TELEPHONE

CITY

EMAIL

(TO BE FILLED IN BY CONTRACTOR) (TO BE FILLED IN BY CONTRACTOR) COMPLETION DATE

PERMANENT STORMWATER DESIGN CALCULATIONS:

SEE THE STORM WATER MANAGEMENT REPORT FOR MORE INFORMATION. CONTACT BOGART, PEDERSON & ASSOCIATES FOR REPORT. PROPOSED FLOW RATE IS LIMITED THROUGH STORM WATER BEING DIRECTED TO MULTIPLE WET RETENTION BASINS AND INFILTRATION BASIN.

SEE GEOTECHNICAL REPORT FOR MORE INFORMATION.

DESCRIPTION OF EROSION CONTROL ACTIVITY:

THE TRANQUIL MEADOWS RESIDENTIAL DEVELOPMENT EROSION CONTROL MEASURES CONSIST OF SILT FENCE INSTALLATION AROUND THE PERIMETER OF GRADING, ROCK CONSTRUCTION ENTRANCE PLACEMENT, EROSION CONTROL BLANKET LAYING ON STEEP SLOPES, AND TURF ESTABLISHMENT WITH SEEDING.

CUMULATIVE IMPERVIOUS SURFACES:

AREA OF DISTURBANCE:	11.20 ACRES
PRE-CONSTRUCTION IMPERVIOUS AREA:	0.97 ACRES
POST CONSTRUCTION IMPERVIOUS AREA:	3.70 ACRES
NEW IMPERVIOUS AREA:	2.73 ACRES

RECEIVING WATERS

STORM WATER FROM THIS SITE WILL BE DISCHARGED TO THE WETLAND WEST OF THE SITE. THE NORTH PORTION IS DIRECTED TO A CULVERT FLOWING EAST. SEE THE STORMWATER REPORT FOR DETAILED INFORMATION.

PLANS AND SPECIFICATIONS

THE PLAN SHEETS OF THIS PLAN SET INDICATE THE FOLLOWING ITEMS:

THE PROJECT LOCATION AND CONSTRUCTION LIMITS.

LOCATIONS OF IMPERVIOUS SURFACES.

LOCATIONS OF AREAS NOT TO BE DISTURBED (E.G., BUFFER ZONES, WETLANDS, ETC.).

STEEP SLOPE LOCATIONS.

LOCATIONS OF ALL TEMPORARY AND PERMANENT EROSION AND SEDIMENT CONTROL

BMP'S TO BE INSTALLED ON THE PROJECT.

THE DETAIL SHEETS INDICATE EROSION AND SEDIMENT CONTROL BMPS TO BE

INSTALLED ON THE PROJECT IF DEWATERING IS REQUIRED FOR THIS PROJECT, THE PUMP DISCHARGE SHALL BE TREATED PRIOR TO BEING DISCHARGED OFF-SITE OR INTO A SURFACE WATER. THE

TEMPORARY SEDIMENT CONTROL PRACTICES

DOWN GRADIENT SILT FENCE AND SEDIMENT LOG INSTALLATIONS ARE TO BE INPLACE PRIOR TO THE COMMENCEMENT OF ANY EARTHWORK OPERATIONS.

TOPSOIL IS TO BE WINDROWED ALONG THE CONSTRUCTION LIMITS AND PLACED AS SLOPE DRESSING IMMEDIATELY FOLLOWING COMPLETION OF THE GRADING OPERATIONS, AS THE GRADING OPERATIONS PROCEED.

DISCHARGE SHALL BE VISUALLY CHECKED TO ENSURE THAT IT IS VISIBLY CLEAN

TOPSOIL PLACEMENT ALONG THE EMBANKMENT SLOPES THOUGH THE WETLANDS AREA IS TO BE SPREAD BY A LOW IMPACT CRAWLER TRACTOR OPERATING UP AND DOWN THE SLOPES SO AS TO PROVIDE TRACK PRINTS PARALLEL WITH THE CONTOURS.

INSTALLATION OF MN/DOT CATEGORY 3 EROSION CONTROL BLANKET ALONG THE EMBANKMENT SLOPES ADJACENT THE WETLANDS AREA.

ALL TEMPORARY SOILS STOCKPILES WILL REQUIRE AN EFFECTIVE MEANS OF SEDIMENT CONTROL SUCH AS AN EROSION CONTROL BLANKET COVERING OR SILT FENCE INSTALLATION ALONG THE TOE OF SLOPE.

ALL COMPLETED SWALES SLOPES AND BOTTOMS NOT DRAINING TOWARDS WETLAND AREAS ARE TO BE STABILIZED WITHIN 7 DAYS.

TEMPORARY STABILIZATION WILL BE REQUIRED IN AREAS WHERE GRADING OPERATIONS ARE SUSPENDED OR CEASED FOR A PERIOD OF 7 DAYS OR GREATER.

PROJECT ENTRANCE ON TWIN LAKES ROAD NW. STREET SWEEPING OF THE PAVED SURFACES WILL BE REQUIRED AS DIRECTED BY THE

A ROCK CONSTRUCTION ENTRANCE FOR SEDIMENT CONTROL IS TO BE PROVIDED AT THE

TIMING OF EROSION CONTROL

SILT FENCE AND SEDIMENT LOGS WILL BE INSTALLED PRIOR TO CONSTRUCTION.

CONCRETE FLEXAMAT AND FILTER BLANKET WILL BE PLACED AT THE OUTLETS WITHIN 24 HOURS OF THE

THE CONTRACTOR MUST STABILIZE ALL EXPOSED SOIL AREAS IMMEDIATELY FOLLOWING CONSTRUCTION WHEREVER CONSTRUCTION WILL NOT OCCUR FOR A PERIOD GREATER THAN OR EQUAL TO 7 DAYS.

STABILIZATION WORK MUST BE COMPLETE WITHIN 7 CALENDAR DAYS AFTER THE CONSTRUCTION WORK IN THAT AREA HAS TEMPORARILY OR PERMANENTLY CEASED.

AREAS THAT ARE WITHIN 200 FT OF A PUBLIC WATER MUST BE STABILIZED WITHIN 24 HOURS OF COMPLETING CONSTRUCTION DURING PERIODS OF "WORK IN WATER RESTRICTIONS" FOR TIME PERIODS DECLARED BY THE

THE CONTRACTOR IS RESPONSIBLE TO MAINTAIN THE DISTURBED AREA UNTIL VEGETATION IN ESTABLISHED.

ONCE VEGETATION IS ESTABLISHED AND CONSTRUCTION IS COMPLETE, THE SILT FENCE AND ANY OTHER TEMPORARY FROSION CONTROL THAT IS NOT BIODEGRADABLE SHALL BE REMOVED.

STREET SWEEPING TO BE PROVIDED AS DIRECTED BY THE ENGINEER OR OWNER. THE CITY REQUIRES STREET SWEEPING TO OCCUR WITHIN 8 HOURS OF NOTICE FROM THE CITY.

APPLYING MULCH, HYDROMULCH, TACKIFIER, POLYACRYLAMIDE OR SIMILAR EROSION PREVENTION PRACTICES IS NOT ACCEPTABLE STABILIZATION IN ANY PART OF A TEMPORARY OR PERMANENT DRAINAGE DITCH OR SWALE. BLANKETS OR OTHER APPROVED, BY THE ENGINEER, METHOD SHALL BE USED.

INSPECTION AND MAINTENANCE ACTIVITIES

THE CONTRACTOR SHALL BE RESPONSIBLE FOR COORDINATING AND SCHEDULING THE WORK OF ALL OPERATIONS, INCLUDING SUBCONTRACTORS AND UTILITY COMPANIES, SUCH THAT EROSION AND SEDIMENT CONTROL MEASURES ARE FULLY EXECUTED FOR EACH OPERATION AND IN A TIMELY MANNER OVER THE DURATION OF THE PROJECT, OPERATORS HAVE DAILY ACCESS TO THE PROJECT SITE, THE CONTRACTOR SHALL BE FULLY RESPONSIBLE FOR THE SWPPP IMPLEMENTATION UNTIL THE ENTIRE SITE HAS UNDERGONE FINAL STABILIZATION AND N.O.T HAS BEEN SUBMITTED TO THE MPCA.

THE CONTRACTOR IS TO PROVIDE A TRAINED INDIVIDUAL RESPONSIBLE FOR THE IMPLEMENTATION. INSPECTION AND MAINTENANCE OF THE EROSION AND SEDIMENT CONTROL BMPS ON THE PROJECT. THAT INDIVIDUAL IS TO BE IDENTIFIED AT THE PRE-CONSTRUCTION CONFERENCE AND LISTED IN THE MINUTES

THE APPOINTED INDIVIDUAL IS TO PERFORM A ROUTINE INSPECTION OF THE ENTIRE SITE AT LEAST ONCE EVERY SEVEN DAYS DURING CONSTRUCTION OPERATIONS AND WITHIN 24 HOURS AFTER A RAINFALL EVENT GREATER THAN 0.5 INCHES IN 24 HOURS.

A INSPECTION FORM WILL BE PROVIDED BY THE CONTRACTOR. ANY DEFICIENCIES IN THE EROSION AND SEDIMENT CONTROL BMPS ARE TO BE NOTED ON THE INSPECTION FORM AND CORRECTED BY THE END OF THE

PERIMETER CONTROL DEVICES ARE TO BE REPAIRED OR REPLACED WHEN THEY ARE NO LONGER EFFECTIVE OR WHEN THE SEDIMENT REACHES ONE-HALF THE HEIGHT OF THE DEVICE.

TOTAL HOURS OF TRAINING

TOTAL HOURS OF TRAINING

SWPPP IMPLEMENTATION, REVISING, AMENDING, AND INSPECTING (TO BE FILLED IN BY THE CONTRACTOR) NAME OF INDIVIDUAL

OVERSEEING & INSPECTING DATE OF TRAINING NAME OF INSTRUCTOR ENTITY PROVIDING TRAINING CONTENT OF TRAINING

BMP INSTALLATION, MAINTENANCE, AND REPAIR (TO BE FILLED IN BY THE CONTRACTOR)

NAME OF INDIVIDUAL **OVERSEEING & INSPECTING** DATE OF TRAINING NAME OF INSTRUCTOR ENTITY PROVIDING TRAINING CONTENT OF TRAINING

FERTILIZERS ARE TO BE APPLIED ONLY IN THE AMOUNTS AS SPECIFIED AND WORKED INTO THE SOIL TO MINIMIZE EXPOSURE TO STORMWATER RUNOFF.

ONSITE REFUELING OPERATIONS ARE TO BE CONDUCTED WITH CARE. ANY INADVERTENT SPILLAGE OF FUEL OR CHEMICALS IS TO BE IMMEDIATELY CLEANED UP, REMOVED FROM THE SITE AND DISPOSED OF IN ACCORDANCE TO STATE AND LOCAL REGULATIONS. MAJOR SPILLS ARE TO BE REPORTED TO THE MPCA 24 HOUR NOTIFICATION NETWORK AT 800 422 0798. ALL VEHICLES ON-SITE ARE TO BE MONITORED FOR LEAKS AND SUBJECT TO ROUTINE PREVENTIVE MAINTENANCE EFFORTS TO REDUCE THE LIKELIHOOD OF LEAKAGE AND OR

PORTABLE SANITARY WASTE FACILITIES ARE TO BE PROVIDED ONSITE AND EMPTIED ON A BI-WEEKLY BASIS.

CONCRETE BATCH TRUCKS WILL NOT BE ALLOWED TO DISCHARGE DRUM AND CHUTE WASHOUT DIRECTLY ON THE GROUND. A PORTABLE WASHOUT RECEPTACLE IS TO BE PROVIDED BY THE CONTRACTOR AT THE LOCATION AS PROVIDED BY THE OWNER.

FINAL STABILIZATION

FINAL STABILIZATION OCCURS WHEN 70 PERCENT OF THE PERVIOUS AREA IS COVERED WITH UNIFORM, PERMANENT VEGETATION.

ALL TEMPORARY EROSION AND SEDIMENT CONTROL FEATURES ARE TO BE REMOVED AND THE NPDES NOTICE OF TERMINATION IS TO BE PREPARED AND SUBMITTED TO THE MPCA.

LOCATION OF SWPPP REQUIREMENTS IN PROJECT PLAN

DESCRIPTION TITLE LOCATION EROSION CONTROL DETAILS C14-C19 CONSTRUCTION DETAILS EROSION CONTROL LOCATIONS C12 EROSION CONTROL LOCATIONS

24 HOUR MPCA EMERGENCY NOTIFICATION: TELEPHONE NUMBERS: 651-649-5451 800-422-0798

ESTIMATED QUANTITIES:

THE FOLLOWING QUANITITES IS AN ESTIMATED PRELIMINARY AMOUNT REQUIRED FOR SEDIMENT CONTROL BMP'S AT THE START OF THE PROJECT. THIS ESTIMATE IS PROVIDED AS REQUIRED BY THE MINNESOTA POLLUTION CONTROL AGENCY GENERAL STORMWATER PERMIT FOR CONSTRUCTION ACTIVITY. ANY ADDITIONAL AND/OR REPLACEMENT BMP'S QUANTITIES WILL BE FURNISHED AND INSTALLED BY THE CONTRACTOR AT NO ADDITIONAL COST TO THE OWNER.

QUANTITY

ESTIMATED PRELIMINARY QUANTITIES AT START OF P	ROJECT:	
<u>ITEM</u>	<u>UNIT</u>	ESTIMATED INITIAL
TEMPORARY CONSTRUCTION ENTRANCE	EA	1
TEMPORARY SEDIMENT FILTER	EA	23
TEMPORARY CONCRETE WASHOUT	EA	1
TEMPORARY PUMP SEDIMENT CONTROL DEVICE	EA	1
TEMPORARY SEDIMENT LOGS	LF	875
TEMPORARY SILT FENCE	LF	3,086
EROSION CONTROL BLANKET (3N-STRAW)	SY	13,170

TEMPORARY EROSION AND SEDIMENT CONTROL SPECIFICATIONS

PART 1 GENERAL

1.01 SECTION INCLUDES

A. PREVENTION OF SEDIMENTATION OF WATERWAYS, OPEN DRAINAGE WAYS, AND STORM AND SANITARY

SEWERS DUE TO CONSTRUCTION ACTIVITIES.

1.02 REFERENCE STANDARDS

A. GENERAL PERMIT AUTHORIZATION TO DISCHARGE STORM WATER ASSOCIATED WITH CONSTRUCTION ACTIVITY UNDER THE NATIONAL POLLUTANT DISCHARGE ELIMINATION SYSTEM. MINNESOTA PERMIT NO: MN

1.03 PERFORMANCE REQUIREMENTS

A. COMPLY WITH ALL REQUIREMENTS OF THE MINNESOTA POLLUTION CONTROL AGENCY FOR EROSION AND

B. DO NOT BEGIN CLEARING, GRADING, OR OTHER WORK INVOLVING DISTURBANCE OF GROUND SURFACE COVER UNTIL APPLICABLE PERMITS HAVE BEEN OBTAINED; FURNISH ALL DOCUMENTATION REQUIRED TO

1. OBTAIN AND PAY FOR PERMITS REQUIRED BY AUTHORITY HAVING JURISDICTION.

C. TIMING: PUT PREVENTIVE MEASURES IN PLACE PRIOR TO DISTURBANCE OF SURFACE COVER AND BEFORE PRECIPITATION OCCURS.

D. EROSION OFF SITE: PREVENT EROSION OF SOIL AND DEPOSITION OF SEDIMENT ON OTHER PROPERTIES CAUSED BY WATER LEAVING THE PROJECT SITE DUE TO CONSTRUCTION ACTIVITIES FOR THIS PROJECT. 1. PREVENT TRACKING OF MUD ONTO PUBLIC ROADS OUTSIDE SITE.

2. PREVENT MUD AND SEDIMENT FROM FLOWING ONTO PAVEMENTS

SITE, INCLUDING RIVERS, STREAMS, LAKES, PONDS, OPEN DRAINAGE WAYS, STORM SEWERS, AND SANITARY 1. IF SEDIMENTATION OCCURS, INSTALL OR CORRECT PREVENTIVE MEASURES IMMEDIATELY AT NO COST TO OWNER; REMOVE DEPOSITED SEDIMENTS; COMPLY WITH REQUIREMENTS OF AUTHORITIES HAVING

E. SEDIMENTATION OF WATERWAYS OFF SITE: PREVENT SEDIMENTATION OF WATERWAYS OFF THE PROJECT

F. MAINTENANCE: MAINTAIN TEMPORARY PREVENTIVE MEASURES UNTIL PERMANENT MEASURES HAVE BEEN ESTABLISHED

PART 2 PRODUCTS

2.01 MATERIALS

A. TEMPORARY SILT FENCE: WOVEN POLYPROPYLENE GEOTEXTILE RESISTANT TO COMMON SOIL CHEMICALS MILDEW, AND INSECTS; NON-BIODEGRADABLE; IN LONGEST LENGTHS POSSIBLE; FABRIC INCLUDING SEAMS

WITH THE FOLLOWING MINIMUM AVERAGE ROLL LENGTHS: 1. AVERAGE OPENING SIZE: 20 U.S. STD. SIEVE. MAXIMUM. WHEN TESTED IN ACCORDANCE WITH ASTM D4751 2. PERMITTIVITY: 0.05 SEC^-1. MINIMUM. WHEN TESTED IN ACCORDANCE WITH ASTM D4491

3. ULTRAVIOLET RESISTANCE: RETAINING AT LEAST 70 PERCENT OF TENSILE STRENGTH, WHEN TESTED IN ACCORDANCE WITH ASTM D4355/D4355M AFTER 500 HOURS EXPOSURE 4. TENSILE STRENGTH: 100 LB-F, MINIMUM, IN CROSS-MACHINE DIRECTION; 124 LB-F, MINIMUM, IN MACHINE

DIRECTION; WHEN TESTED IN ACCORDANCE WITH ASTM D4632. 5. ELONGATION: 15 TO 30 PERCENT, WHEN TESTED IN ACCORDANCE WITH ASTM D4632.

6. TEAR STRENGTH: 55 LB-F, MINIMUM, WHEN TESTED IN ACCORDANCE WITH ASTM D4533. 7. COLOR: MANUFACTURER'S STANDARD, WITH EMBEDMENT AND FASTENER LINES PREPRINTED.

8. SILT FENCE POSTS: ONE OF THE FOLLOWING, MINIMUM 5 FEET LONG: a. STEEL U- OR T-SECTION, WITH MINIMUM MASS OF 1.33 LB PER LINEAR FOOT.

b. SOFTWOOD, 4 BY 4 INCHES IN CROSS SECTION. c. HARDWOOD, 2 BY 2 INCHES IN CROSS SECTION.

B. TEMPORARY SEDIMENT LOGS: FILTER LOGS SHALL CONSIST OF TYPE WOOD FIBER BIOROLLS AND THE REQUIREMENTS OF MNDOT SPEC. 3897.

a. SHALL BE SILTSOXX PERIMETER CONTROL BY FILTREXX, INC., OR EQUAL C. TEMPORARY SEDIMENT FILTER.

SHALL BE ONE OF THE FOLLOWING.

1. SHALL BE ONE OF THE FOLLOWING

a. DROP-IN SEDIMENT FILTER UNIT THAT INSERTS INTO THE INLET. 1) SHALL BE FLEXSTORM PURE: PERMANENT INLET FILTER BY ADS, INC., OR EQUAL.

(a)PROVIDE CURB OPENING PROTECTION FOR EXISTING INLETS WITH CURB OPENINGS. D. TEMPORARY ROCK CONSTRUCTION ENTRANCE

ROCK SHALL BE CLEAN 1 TO 2 INCH WASHED ROCK.

E. TEMPORARY SLOPE EROSION PROTECTION

SHALL BE ONE OF THE FOLLOWING.

1) SHALL CONSIST OF A UNIFORM WEB OF INTERLOCKING STRAW OR WOOD FIBERS SANDWICHED

BETWEEN AN ATTACHED TOP AND BOTTOM LAYER OF NET BACKING 2) THE NETTING SHALL BE BIODEGRADABLE CONTAINING SUFFICIENT UV STABILIZATION FOR

BREAKDOWN TO OCCUR WITHIN A NORMAL GROWING SEASON. 3) STAPLES USED TO ANCHOR THE BLANKETS SHALL BE U-SHAPED, 11 GAUGE OR HEAVIER STEEL WIRE

HAVING A SPAN WIDTH OF 1 INCH AND A LENGTH OF 8 INCHES OR MORE FROM TOP TO BOTTOM AFTER BENDING.

4) THE EROSION CONTROL BLANKETS ACCEPTABLE FOR USE ON THIS PROJECT INCLUDE: (a)GEO-SYNTHETICS, INC., - LANDLOK 52.

(b)NORTH AMERICAN GREEN - S150. (c)OR EQUAL b. BONDED FIBER MATRIX

1) THE FIBERS SHALL BE COMPOSED OF 100% WOOD OR WOOD BY-PRODUCTS. A MINIMUM OF 25% OF THE FIBERS SHALL AVERAGE 10.16 MM (0.4 INCHES) IN LENGTH AND 50% OR MORE SHALL BE RETAINED ON A CLARK FIBER CLASSIFIER 24 MESH SCREEN. FIBERS SHALL BE COLORED WITH A WATER SOLUBLE, NON-TOXIC DYE, TO AID IN UNIFORM APPLICATION OVER THE SITE.

2) THE BINDER SHALL BE A HYDRO COLLOID BASED (GUAR GUM) WITH ADDED SLOW-RELEASE AND AGRICULTURAL BASED FERTILIZERS. THE BINDER SHALL NOT DISSOLVE OR DISPERSE UPON 3) THE BFM SLURRY SHALL DRY TO FORM A CRUST APPROXIMATELY 3-6 MM (1/8 TO 1/4 INCHES) THICK

ADHERING TO THE SOIL SURFACE. 4) THE MOISTURE CONTENT OF THE MATRIX SHALL BE 12% +/- 3% BY WEIGHT. 5) THE MATRIX SHALL CONSIST OF MATERIALS THAT ARE 100% BIODEGRADABLE AND 100% BENEFICIAL

6) THE MATRIX SHALL PROVIDE 100% CONTINUOUS COVERAGE AND SHALL HAVE NO HOLES GREATER

THAN 1MM IN SIZE. 7) THE HYDRATED MIXTURE DENSITY SHALL BE APPROXIMATED BY A SLUMP TEST PRIOR TO

8) THE BFM MULCH: WATER RATIO SHALL BE AS MANUFACTURER RECOMMENDATIONS. THE MINIMUM BFM MULCH TO WATER RATIO IS 50LBS BFM MULCH AND 100 GALLONS WATER. THE WATER RATE WILL VARY BETWEEN 100 GALLONS AND 125 GALLONS PER 50LBS, DEPENDING ON WHICH OF THE PRODUCTS IS USED 9) THE BONDED FIBER MATRIX MULCH PRODUCTS ACCEPTABLE FOR USE ON THIS PROJECT INCLUDE.

(a)ECOAEGIS - MANUFACTURED BY CANFOR. (b)SOIL GUARD - MANUFACTURED BY MAT, INC.

(c) CONWED 3000 - MANUFACTURED BY CONWED FIBERS, INC.

F. TEMPORARY PUMPED SEDIMENT CONTROL DEVICE.

1. NON-WOVEN GEOTEXTILE FABRIC SEWN INTO A BAG USING A DOUBLE NEEDLE MACHINE AND HIGH a. SEAMS SHALL HAVE AN AVERAGE WIDTH STRENGTH OF 60LB/INCH AS PER ASTM D4883 AND MEET OR

EXCEED THE FOLLOWING 1) GRAB TENSILE OF 205 LBS AS PER ASTM D 4632.

1. PROVIDE A SIGNED COPY TO THE OWNER.

2) PUNCTURE OF 110 LBS AS PER ASTM D 4833. 3) FLOW RATE OF 95 GAL/MIN/SF AS PER ASTM D 4491

4) PERMITTIVITY OF 1.5 SEC-1 AS PER ASTM D 4491 5) MULLEN BURST STRENGTH OF 350 PSI AS PER ASTM D 3786.

6) AOS% OF 80% US SIEVE AS PER ASTM D 4751. 2. SPOUT LARGE ENOUGH TO ACCOMMODATE A 4 INCH DISCHARGE HOSE WITH STRAP TO TIE UNIT CLOSED. 3. SHALL BE ONE OF THE FOLLOWING.

1) ACF ENVIRONMENTAL, INC., 2831 CARDWELL ROAD, RICHMOND, VIRGINIA 23234, 800-448-3636. b. DANDY DEWATERING BAG.

1) DANDY PRODUCTS, INC., P.O. BOX 1980, WESTERVILLE, OHIO 43086, 800-591-2284. c. OR EQUAL

PART 3 EXECUTION

a. DIRTBAG

3.01 PREPARATION

A. SCHEDULE WORK SO THAT SOIL SURFACES ARE LEFT EXPOSED FOR THE MINIMUM AMOUNT OF TIME.

B. THE CONSTRUCTION SITE OPERATOR SHALL FOLLOW ALL REQUIREMENTS OF THE MINNESOTA STORMWATER

C. THE CONTRACTOR SHALL COMPLETE AND SIGN THE NOTICE OF INTENT, OBTAIN THE OWNER'S SIGNATURE, AND SUBMIT TO THE MPCA.

RECORD DRAWING

3.03 INSTALLATION

A. TEMPORARY ROCK CONSTRUCTION ENTRANCE. 1. THE ROCK AREA SHALL BE A MINIMUM OF 6 INCHES DEEP, EXTEND THE FULL WIDTH OF THE EGRESS AREA AND SHALL BE AT LEAST 50FT LONG, HOWEVER, LONGER ENTRANCES MAY BE

REQUIRED TO ADEQUATELY CLEAN THE TIRES 2. GEOTEXTILE FABRIC MAY BE USED TO PREVENT MIGRATION OF MUD FROM THE UNDERLYING SOIL INTO THE ROCK.

B. TEMPORARY SILT FENCES:

1. STORE AND HANDLE FABRIC IN ACCORDANCE WITH ASTM D4873.

6. FASTEN FABRIC TO WOOD POSTS USING ONE OF THE FOLLOWING

2. USE NOMINAL 30 INCH HIGH BARRIERS, MINIMUM 60 INCH LONG POSTS SPACED AT 6 FEET MAXIMUM

3. EMBED BOTTOM OF FABRIC IN A TRENCH ON THE UPSLOPE SIDE OF FENCE, WITH 6 INCHES OF FABRIC LAID FLAT ON BOTTOM OF TRENCH FACING UPSLOPE; BACKFILL TRENCH AND COMPACT 4. MINIMUM POST EMBEDMENT.

a. STEEL POST = 24 INCHES, MINIMUM.

b. WOOD POST = 18 INCHES, MINIMUM

5. DO NOT SPLICE FABRIC WIDTH; MINIMIZE SPLICES IN FABRIC LENGTH; SPLICE AT POST ONLY, OVERLAPPING AT LEAST 18 INCHES, WITH EXTRA POST

a. FOUR NAILS PER POST WITH 3/4 INCH DIAMETER FLAT OR BUTTON HEAD, 1 INCH LONG, AND 14 GAGE, 0.083 INCH SHANK DIAMETER. b. FIVE STAPLES PER POST WITH AT LEAST 17 GAGE, 0.0453 INCH WIRE, 3/4 INCH CROWN WIDTH

AND 1/2 INCH LONG LEGS.

7. FASTEN FABRIC TO STEEL POSTS USING WIRE, NYLON CORD, OR INTEGRAL POCKETS. C. TEMPORARY SEDIMENT LOGS:

DISTURBED AREA. 2. STAKES SHOULD BE INSTALLED THROUGH THE MIDDLE OF THE PERIMETER CONTROL ON 10 FT CENTERS, USING 2 IN BY 2 IN BY 3 FT WOODEN STAKES. IN THE EVENT STAKING IS NOT POSSIBLE, I.E., WHEN PERIMETER CONTROL

1. PERIMETER CONTROL SHOULD BE INSTALLED PARALLEL TO THE BASE OF THE SLOPE OR OTHER

IS USED ON PAVEMENT, HEAVY CONCRETE BLOCKS SHALL BE USED BEHIND THE PERIMETER

CONTROL TO HELP STABILIZE DURING RAIN EVENTS. D. TEMPORARY SEDIMENT FILTERS

 DROP-IN SEDIMENT TRAP. a. PLACE AS RECOMMENDED BY THE MANUFACTURER.

E. TEMPORARY PUMPED SEDIMENT CONTROL DEVICE.

1. INSTALL AS PER MANUFACTURER'S RECOMMENDATIONS F. TEMPORARY SLOPE EROSION PROTECTION.

1. PLACE AT ANY AND ALL FINISH SLOPES THAT ARE STEEPER THAN 10H:1V. 2. SEED AND FERTILIZE PER SPECIFICATION 32 9219 PRIOR TO INSTALLING TEMPORARY SLOPE EROSION PROTECTION.

3 BONDED FIBER MATRIX a. INSTALL THE BFM AS PER THE MANUFACTURER'S INSTRUCTIONS WITH THE FOLLOWING MINIMUM

1) THE BFM SHALL BE APPLIED WITH HYDRAULIC SPRAY EQUIPMENT BY A MANUFACTURER'S CERTIFIED APPLICATOR. 2) APPLICATION SHALL BE DONE AT LEAST 24 HOURS IN ADVANCE OF PROJECTED RAINFALL TO ALLOW THE BFM MULCH ADEQUATE TIME TO DRY.

5) THE INSTALLATION RATE OF THE BFM MULCH SHALL BE 3500 LBS PER ACRE, MINIMUM AND

3) THE BFM MULCH SHALL BE APPLIED IN TWO STAGES (ONE-HALF RATE) WITH AMPLE TIME TO DEWATER THE FIRST APPLICATION. 4) THE BFM MULCH SHALL BE APPLIED FROM AT LEAST TWO ALTERNATE DIRECTIONS, PREFERABLY 90 DEGREES APART, IF POSSIBLE, TO ENSURE ALL SOIL FACES ARE COVERED.

100% COVERAGE 4. EROSION CONTROL BLANKET

a. INSTALL AS PER MANUFACTURER'S RECOMMENDATIONS

A. INSPECT PREVENTIVE MEASURES WEEKLY, WITHIN 24 HOURS AFTER THE END OF ANY STORM THAT PRODUCES 0.5 INCHES OR MORE RAINFALL AT THE PROJECT SITE, AND DAILY DURING PROLONGED

3.04 MAINTENANCE

B. REPAIR DEFICIENCIES IMMEDIATELY.

C. TEMPORARY SILT FENCES: 1. PROMPTLY REPLACE FABRIC THAT DETERIORATES UNLESS NEED FOR FENCE HAS PASSED. 2. REMOVE SILT DEPOSITS THAT EXCEED ONE-THIRD OF THE HEIGHT OF THE FENCE.

3. REPAIR FENCES THAT ARE UNDERCUT BY RUNOFF OR OTHERWISE DAMAGED. WHETHER BY

D. TEMPORARY CONSTRUCTION EXIT. 1. PERIODIC ADDITION OF ROCK, OR REMOVAL AND REPLACEMENT OF PAD SHALL BE PROVIDED AS

RUNOFF OR OTHER CAUSES.


VOIDS BECOME FILLED WITH SOIL. E. TEMPORARY PUMPED SEDIMENT CONTROL DEVICE. 1. REPLACE THE UNIT WHEN 1/2 FULL OF SEDIMENT OR WHEN SEDIMENT HAS REDUCED THE FLOW

RATE OF THE PUMP DISCHARGE TO AN IMPRACTICAL RATE.

F. PLACE SEDIMENT IN APPROPRIATE LOCATIONS ON SITE; DO NOT REMOVE FROM SITE. 3.05 CLEANUP A. REMOVE TEMPORARY MEASURE AFTER PERMANENT VEGETATION HAS BEEN ESTABLISHED.

B. WHERE REMOVAL OF TEMPORARY MEASURES WOULD LEAVE EXPOSED SOIL, SHAPE SURFACE TO AN ACCEPTABLE GRADE AND FINISH TO MATCH ADJACENT GROUND SURFACES.

IMPAIRED WATERS MAP

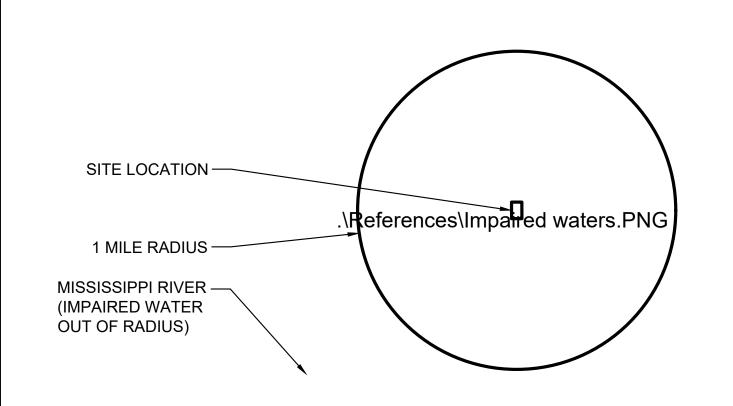

0

00

 γZ

Δш

D A

MO

SHEET NO.