



RECORD DRAWING

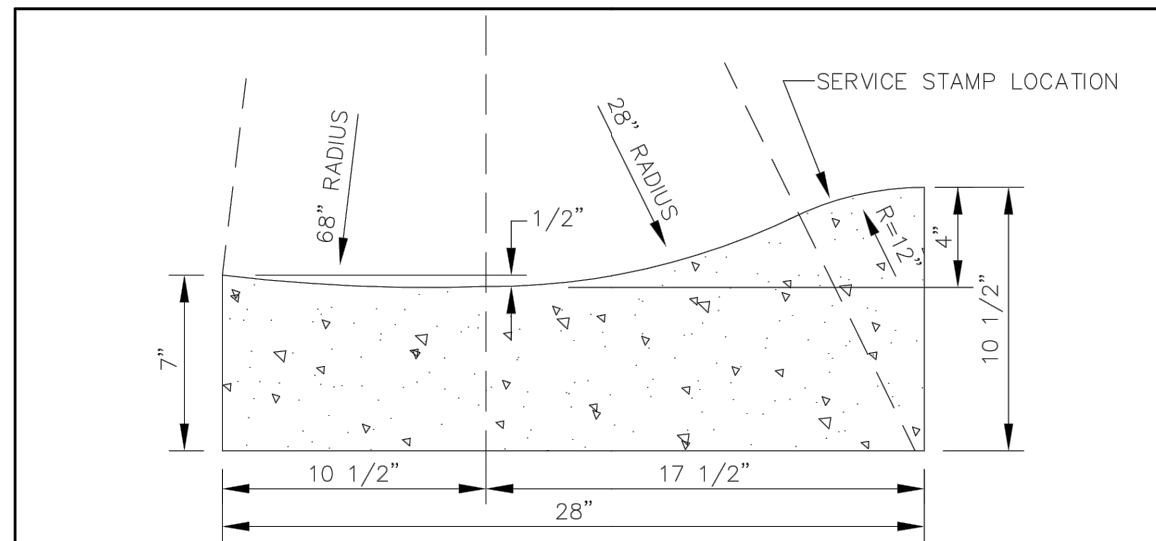

28" SURMOUNTABLE CONCRETE CURB AND GUTTER

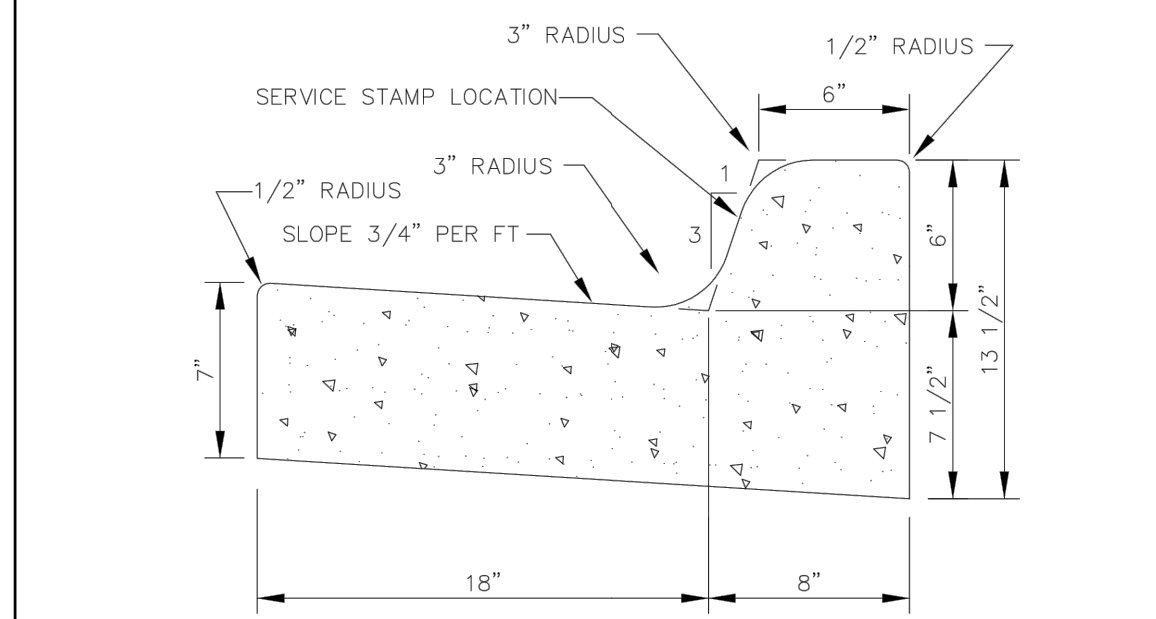


B618 CONCRETE CURB AND GUTTER

REV: 3/2006




SURMOUNTABLE AND B618
CONCRETE CURB AND GUTTER

STANDARD
PLATE
NO.
2000

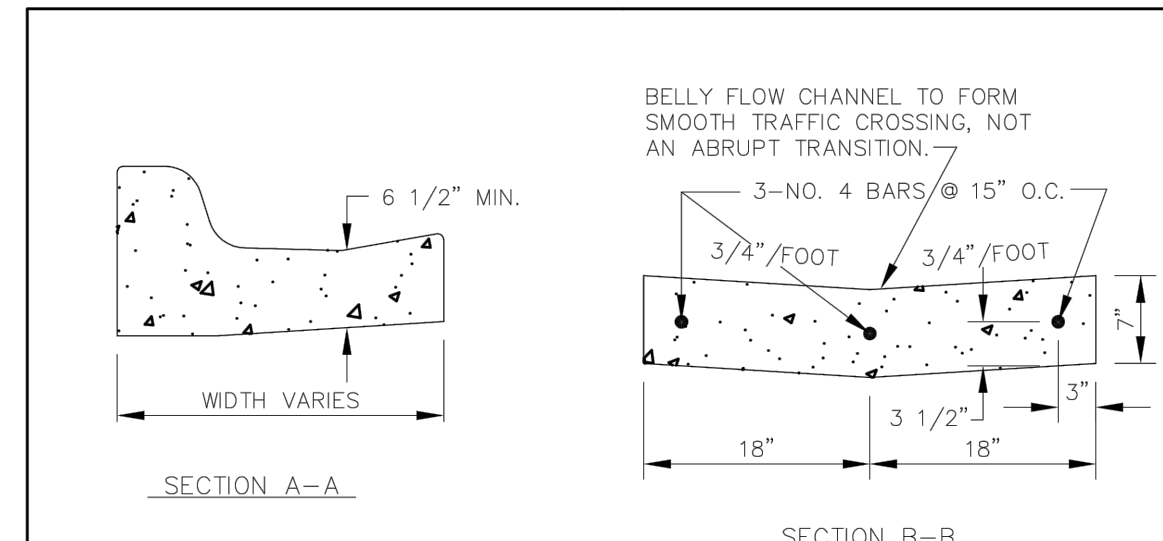

SECTION B-B

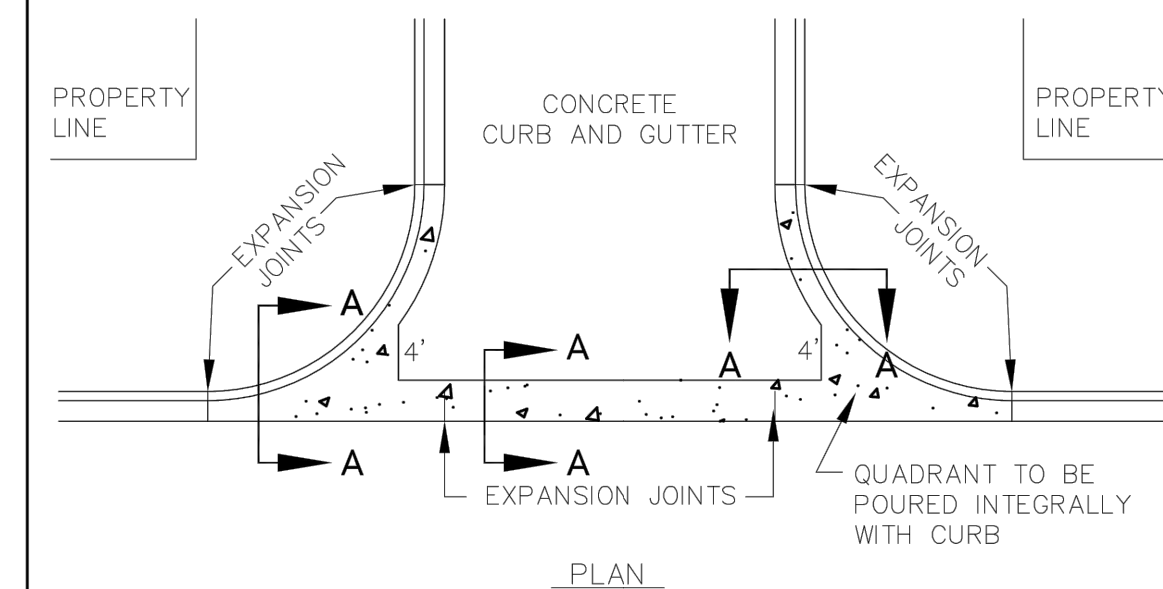


PLAN

REV: 3/2006




CONCRETE "V" GUTTER


STANDARD
PLATE
NO.
2001

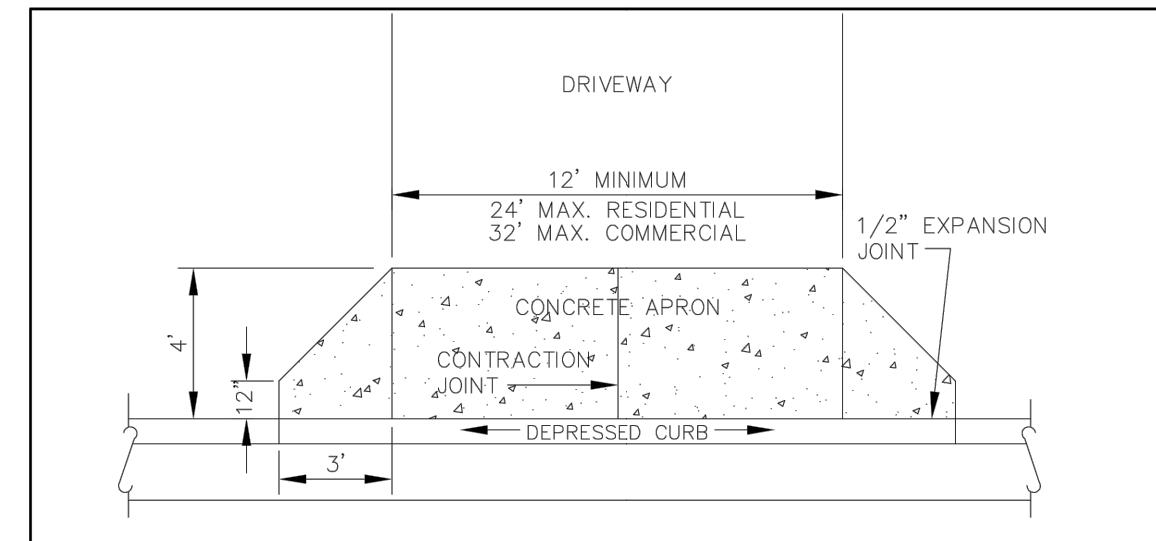

PLAN

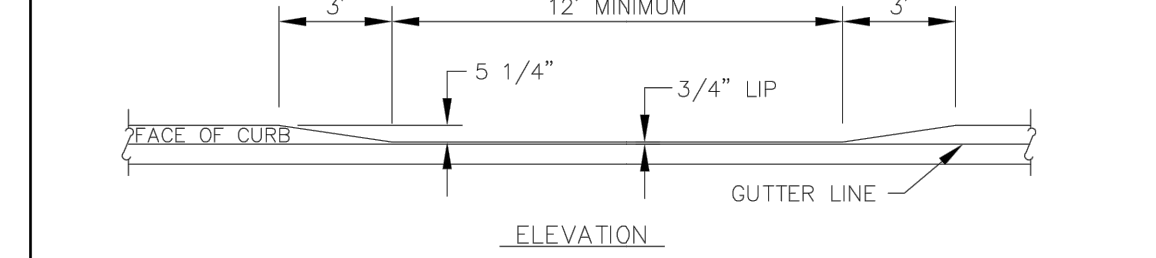

ELEVATION

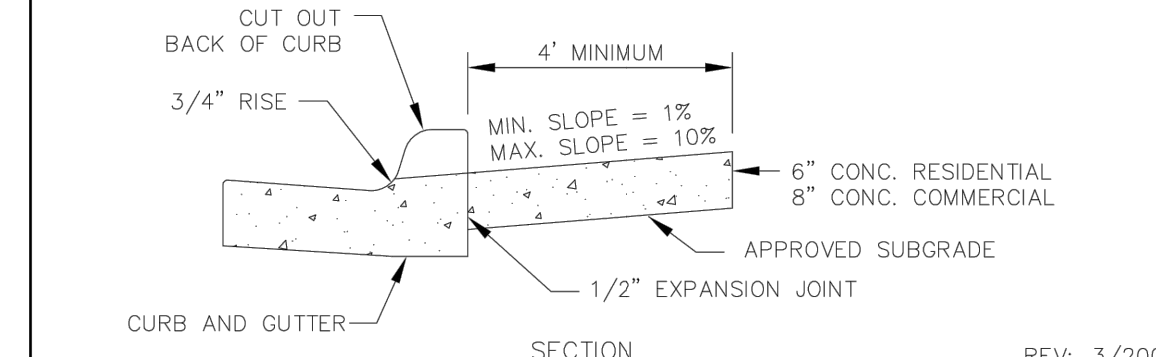



SECTION

REV: 3/2006




DEPRESSED CURB
WITH DRIVEWAY APRON


STANDARD
PLATE
NO.
2002

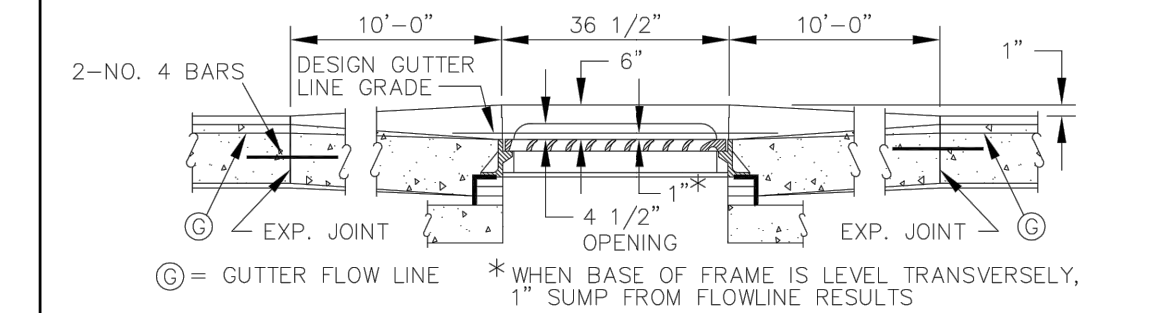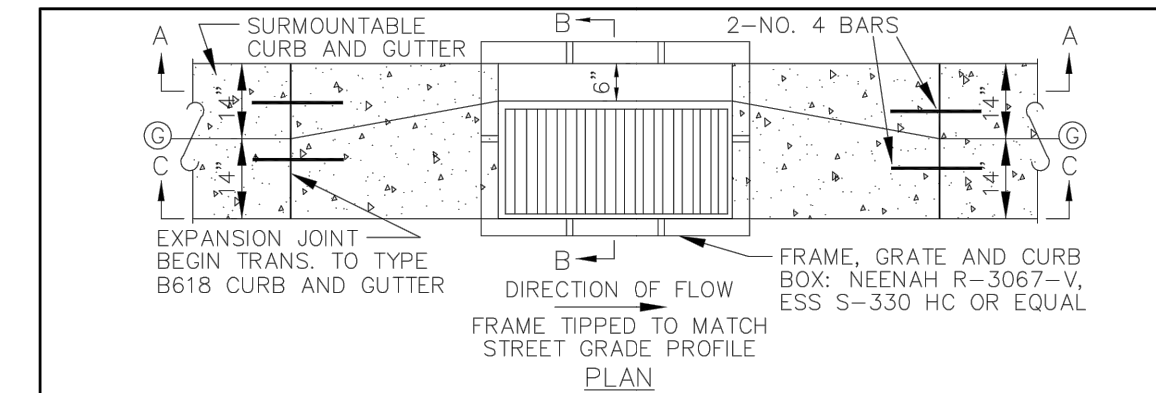

SECTION A-A

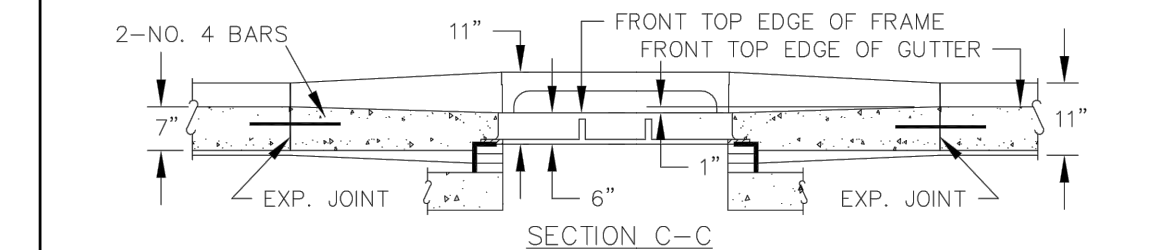

SECTION C-C

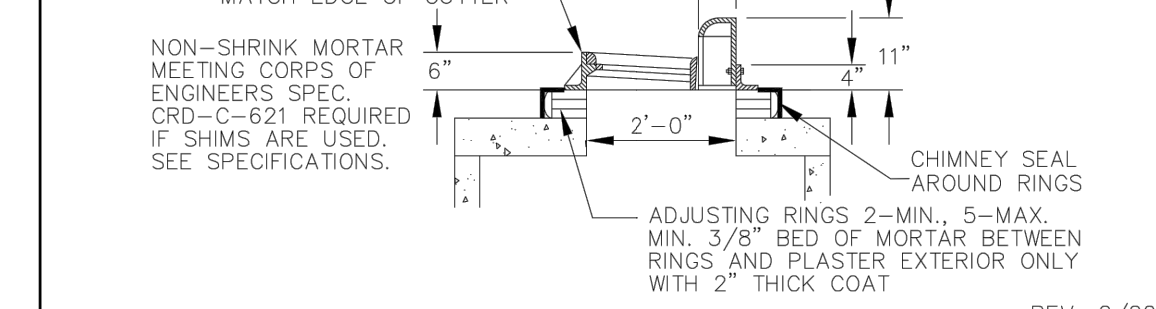


SECTION B-B

REV: 2/2017



CATCH BASIN FRAME PLACEMENT
SURMOUNTABLE CURB AND GUTTER

STANDARD
PLATE
NO.
2005

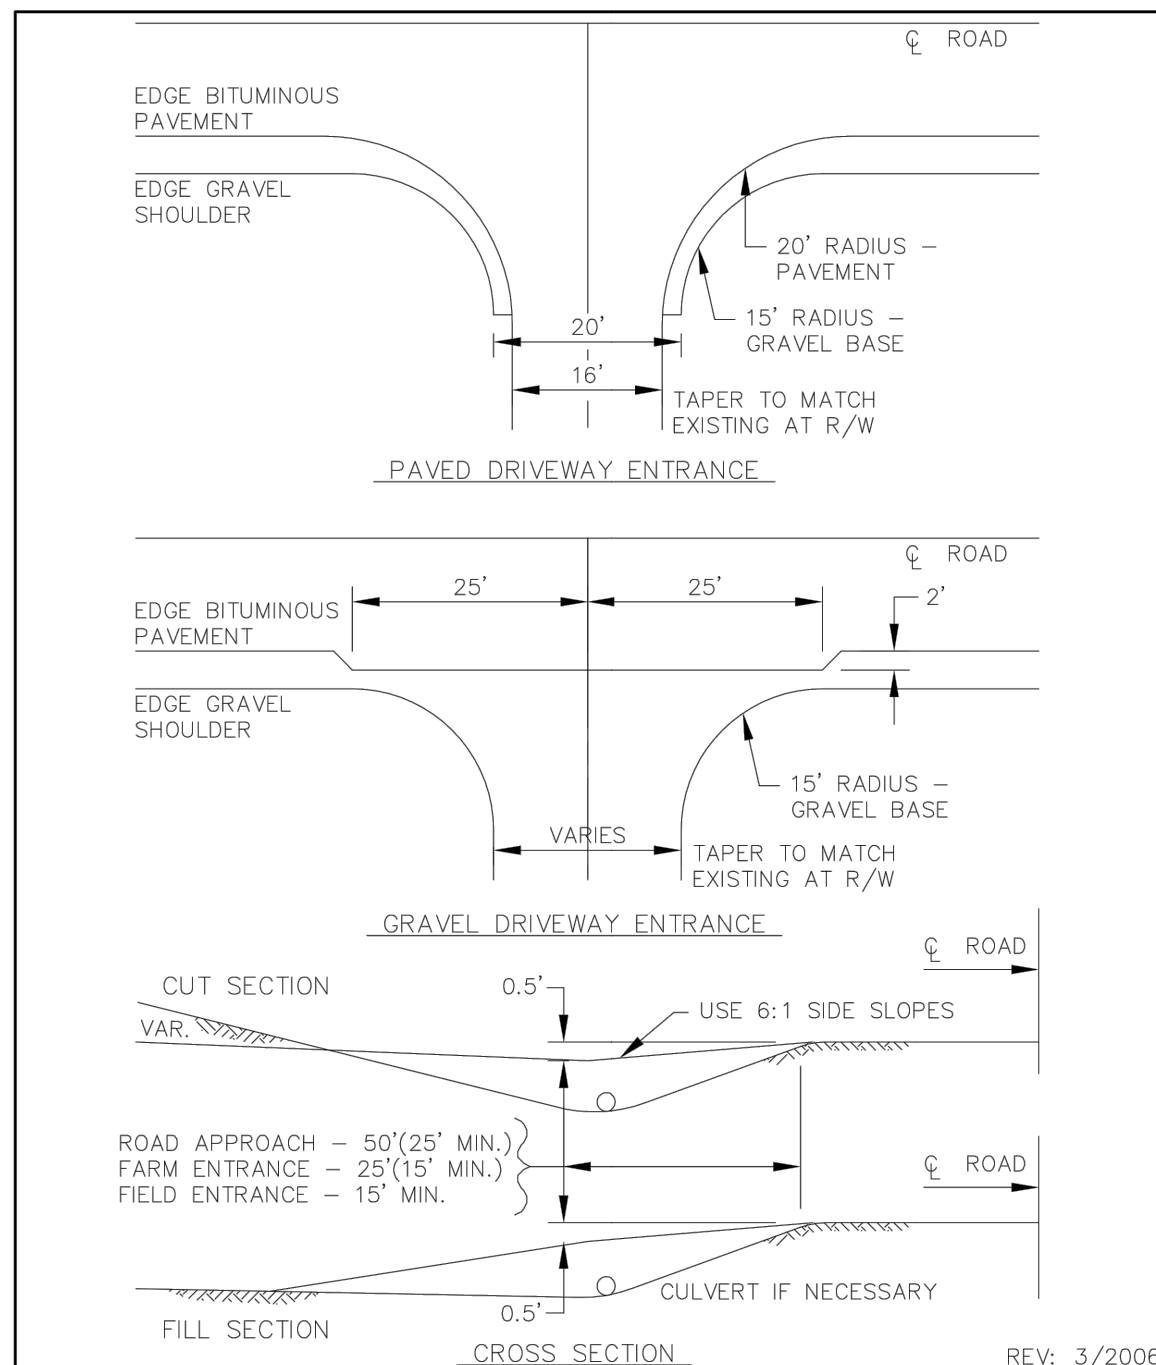


RURAL DRIVEWAY ENTRANCE

REV: 3/2006



RURAL DRIVEWAY ENTRANCE

STANDARD
PLATE
NO.
2007

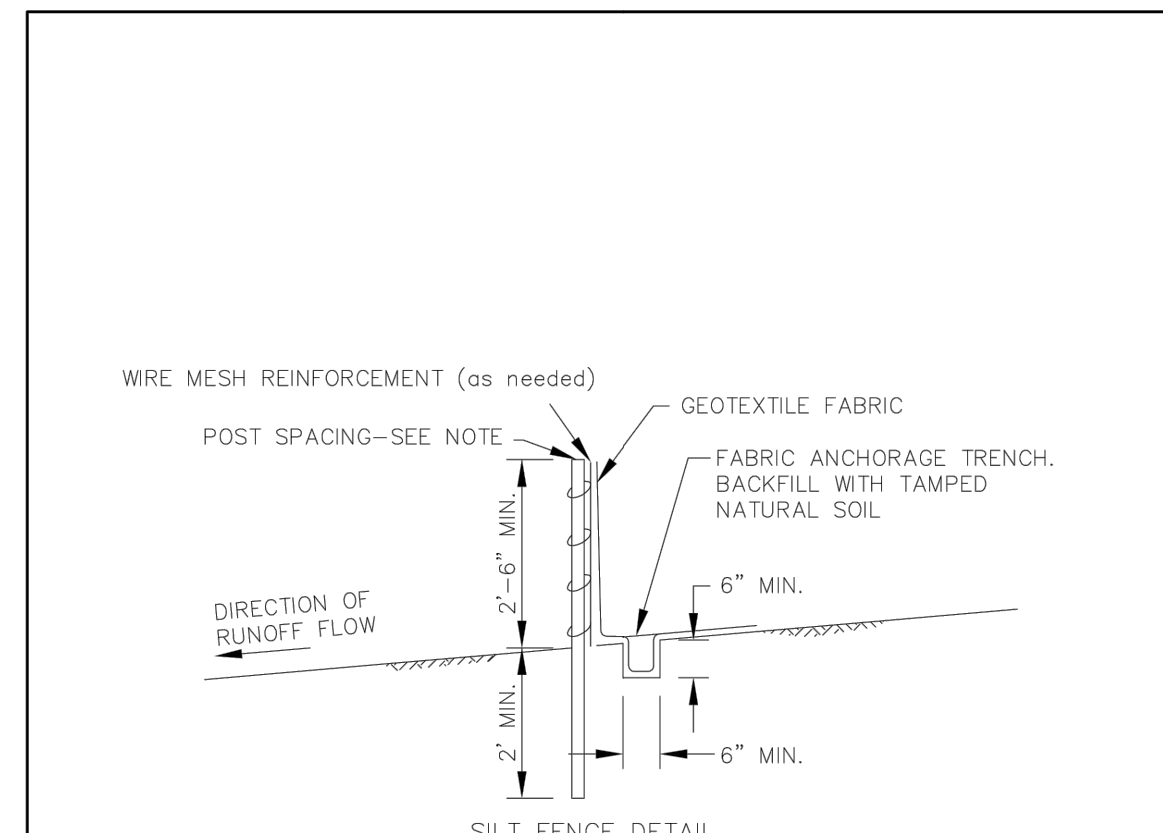

SILT FENCE DETAIL


- NOTE:
- SILT FENCES CONSTRUCTED WITH SUPPORT FENCES, POSTS SHALL BE SPACED AT 10' OR LESS, AND DRIVEN AT LEAST 2' INTO THE GROUND.
 - SILT FENCES CONSTRUCTED WITHOUT SUPPORT FENCES, POST SHALL BE SPACED AT 4' OR LESS, AND DRIVEN AT LEAST 3' INTO THE GROUND.

REV: 7/2007



STANDARD SILT FENCE

STANDARD
PLATE
NO.
2009

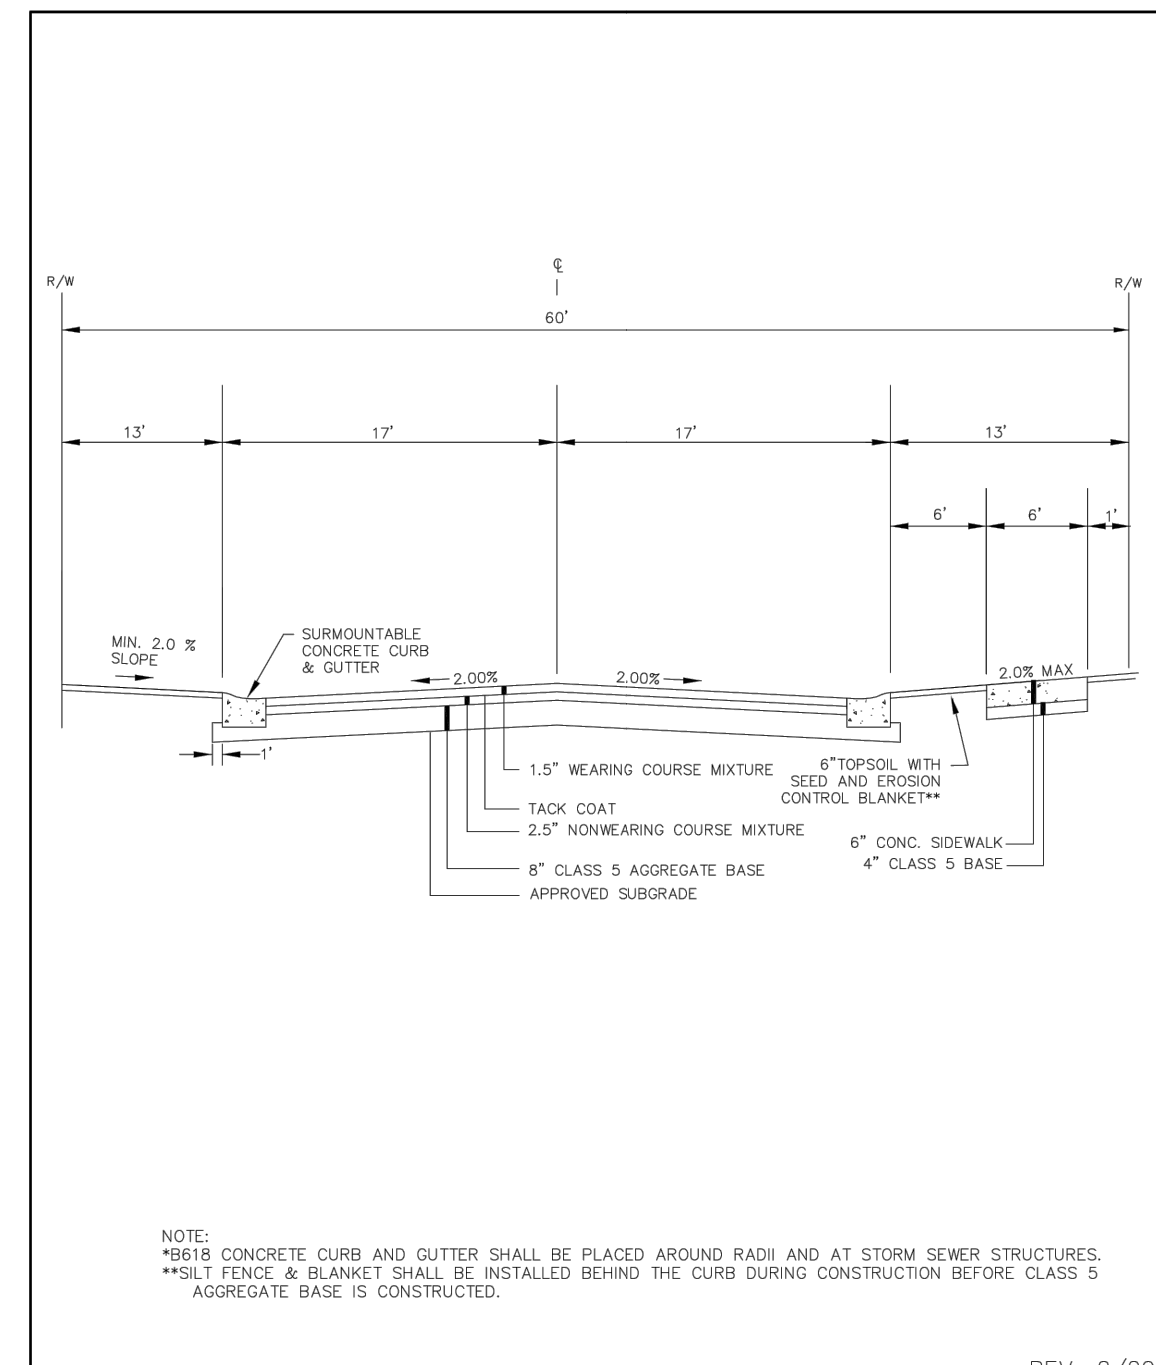

TYPICAL URBAN RESIDENTIAL
STREET SECTION

REV: 2/2017



TYPICAL URBAN RESIDENTIAL
STREET SECTION

STANDARD
PLATE
NO.
2010

REV. NO.	DATE	DESCRIPTION
1	02/22/2021	DRAWINGS ISSUED TO CITY
2	03/12/2021	DRAWINGS REVISED PER CITY REVIEW
3	03/30/2021	MPCA REVIEW
4	04/21/2021	FINAL CONSTRUCTION PLANS
5	05/14/2021	DRAWINGS REVISED PER 2ND CITY REVIEW
6	06/30/2021	ADDENDUM 1
	04/18/2022	RECORD AS-BUILT DRAWINGS

DATE:	02/22/2021
DESIGN BY:	MJM
DRAWN BY:	MJM
CHECKED BY:	CJD
DWG FILE:	DETAILS
FILE NO.:	21-0046.00

I hereby certify that this plan, specification, or report was prepared by me or under my direct supervision and that I am a duly Licensed Professional Engineer under the laws of the State of Minnesota.	Signed:	Lic. No. 58628
	Date: 04/18/2022	

BOGART, PEDERSON & ASSOCIATES, INC.
 LAND SURVEYING
 ENVIRONMENTAL SERVICES
 13076 FIRST STREET, BECKER, MN 55308-9322
 TEL: 763-262-8822 FAX: 763-262-8844

**TRANQUIL MEADOWS
 RESIDENTIAL DEVELOPMENT
 PROVIDENCE S&S, LLC**
 City of Elk River, Sherburne County, MN
 CONSTRUCTION DETAILS

SHEET NO. **C14**

Missing or invalid reference
 File: .\References\FULL DETAILS.pdf
 Sheet: 31