## **NORTH**

## **GENERAL NOTES**

- 1. THE INFORMATION SHOWN ON THESE DRAWINGS CONCERNING TYPE AND LOCATION OF EXISTING UTILITIES IS NOT GUARANTEED TO BE ACCURATE OR ALL INCLUSIVE. THE
- CONTRACTOR IS RESPONSIBLE FOR MAKING HIS OWN DETERMINATION AS TO TYPE AND LOCATION OF UTILITIES AS NECESSARY TO AVOID DAMAGE TO THESE UTILITIES. 2. CONTACT GOPHER STATE ONE—CALL AT (651) 454—0002 FOR EXISTING UTILITY LOCATIONS. FIELD VERIFY SIZE, ELEVATION, AND LOCATION OF EXISTING SANITARY SEWER, STORM
- SEWER, AND WATERMAIN AND NOTIFY ENGINEER OF ANY DISCREPANCIES PRIOR TO THE START OF INSTALLATIONS.
- 4. INSTALLATIONS SHALL CONFORM TO THE CITY OF ELK RIVER STANDARD SPECIFICATIONS & DETAIL PLATES WHICH GOVERN OVER ALL OTHER REFERENCED SPECIFICATIONS. 5. USE TRAFFIC CONTROL MEASURES IN ACCORDANCE WITH THE PROVISIONS OF "THE MINNESOTA MANUAL OF UNIFORM TRAFFIC CONTROL DEVICES" AS NECESSARY WHENEVER
- GRADING, UTILITY, OR PAVING OPERATIONS ENCROACH ONTO ADJACENT STREETS. 5.1. TRAFFIC CONTROL REQUIRED FOR TRAIL DISRUPTION. 6. TEMPORARY EROSION CONTROL MEASURES SHALL BE IN PLACE PRIOR TO THE START OF
- 7. SEE STORM WATER POLLUTION PREVENTION PLAN FOR ADDITIONAL EROSION CONTROL DETAILS AND SITE SEQUENCING NOTES. 8. NATIONAL POLLUTANT DISCHARGE ELIMINATION SYSTEM (N.P.D.E.S.) PERMIT REQUIRED.


ANY CONSTRUCTION.

## STORM SEWER NOTES

- 1. PROPOSED STORM SEWER PIPE SHALL BE: 1.1. REINFORCED CONCRETE PIPE (RCP) WITH R-4 GASKETS; AND, 1.2. HIGH-DENSITY POLYETHYLENE PIPÉ (HDPE). HDPE PIPE SHALL MEET THE REQUIREMENTS OF AASHTO M294, TYPE S WITH WATERTIGHT CONNECTIONS. USE SAND/GRANULAR MATERIAL FOR BACKFILLING AND COMPACTION OF HDPE IN
- ACCORDANCE WITH THE REQUIREMENTS OF ASTM 2321. 2. FIELD VERIFY SIZE, ELEVATION, AND LOCATION OF EXISTING STORM SEWER AND NOTIFY ENGINEER OF ANY DISCREPANCIES PRIOR TO ANY INSTALLATIONS.
- 3. STORM SEWER LENGTHS INCLUDE THE LAYING LENGTH OF THE FLARED—END SECTION.
  LAYING LENGTH OF APRON TO BE DEDUCTED FROM PAYMENT LENGTH OF PIPE.


  4. ALL PORTIONS OF THE STORM SEWER SYSTEM LOCATED WITHIN 10 FEET OF THE BUILDING OR WATER SERVICE LINE MUST BE TESTED IN ACCORDANCE WITH MINNESOTA RULES, CHAPTER 4714, SECTION 1109.0.


ALL CASTINGS (MANHOLES AND VALVE BOXES) MUST BE ADJUSTED TO 1/2" BELOW THE FINISHED ASPHALT BASE COURSE ELEVATION BEFORE PAVING OF THE ASPHALT BASE. NO CUTS WILL BE ALLOWED IN THE ASPHALT BASE. ADJUSTMENTS TO MEET FINAL WEAR COURSE ELEVATIONS WILL BE ACCOMPLISHED USING GLUE IN STEEL ADJUSTING RINGS. THE CITY WILL IMPOSE A \$1000/PATCH CHARGE TO THE DEVELOPER FOR EVERY PATCH LOCATION (NEEDED FOR CASTING ADJUSTMENT OR OTHER PAVEMENT REPAIR) IN THE BASE COURSE BITUMINOUS PAVEMENT.

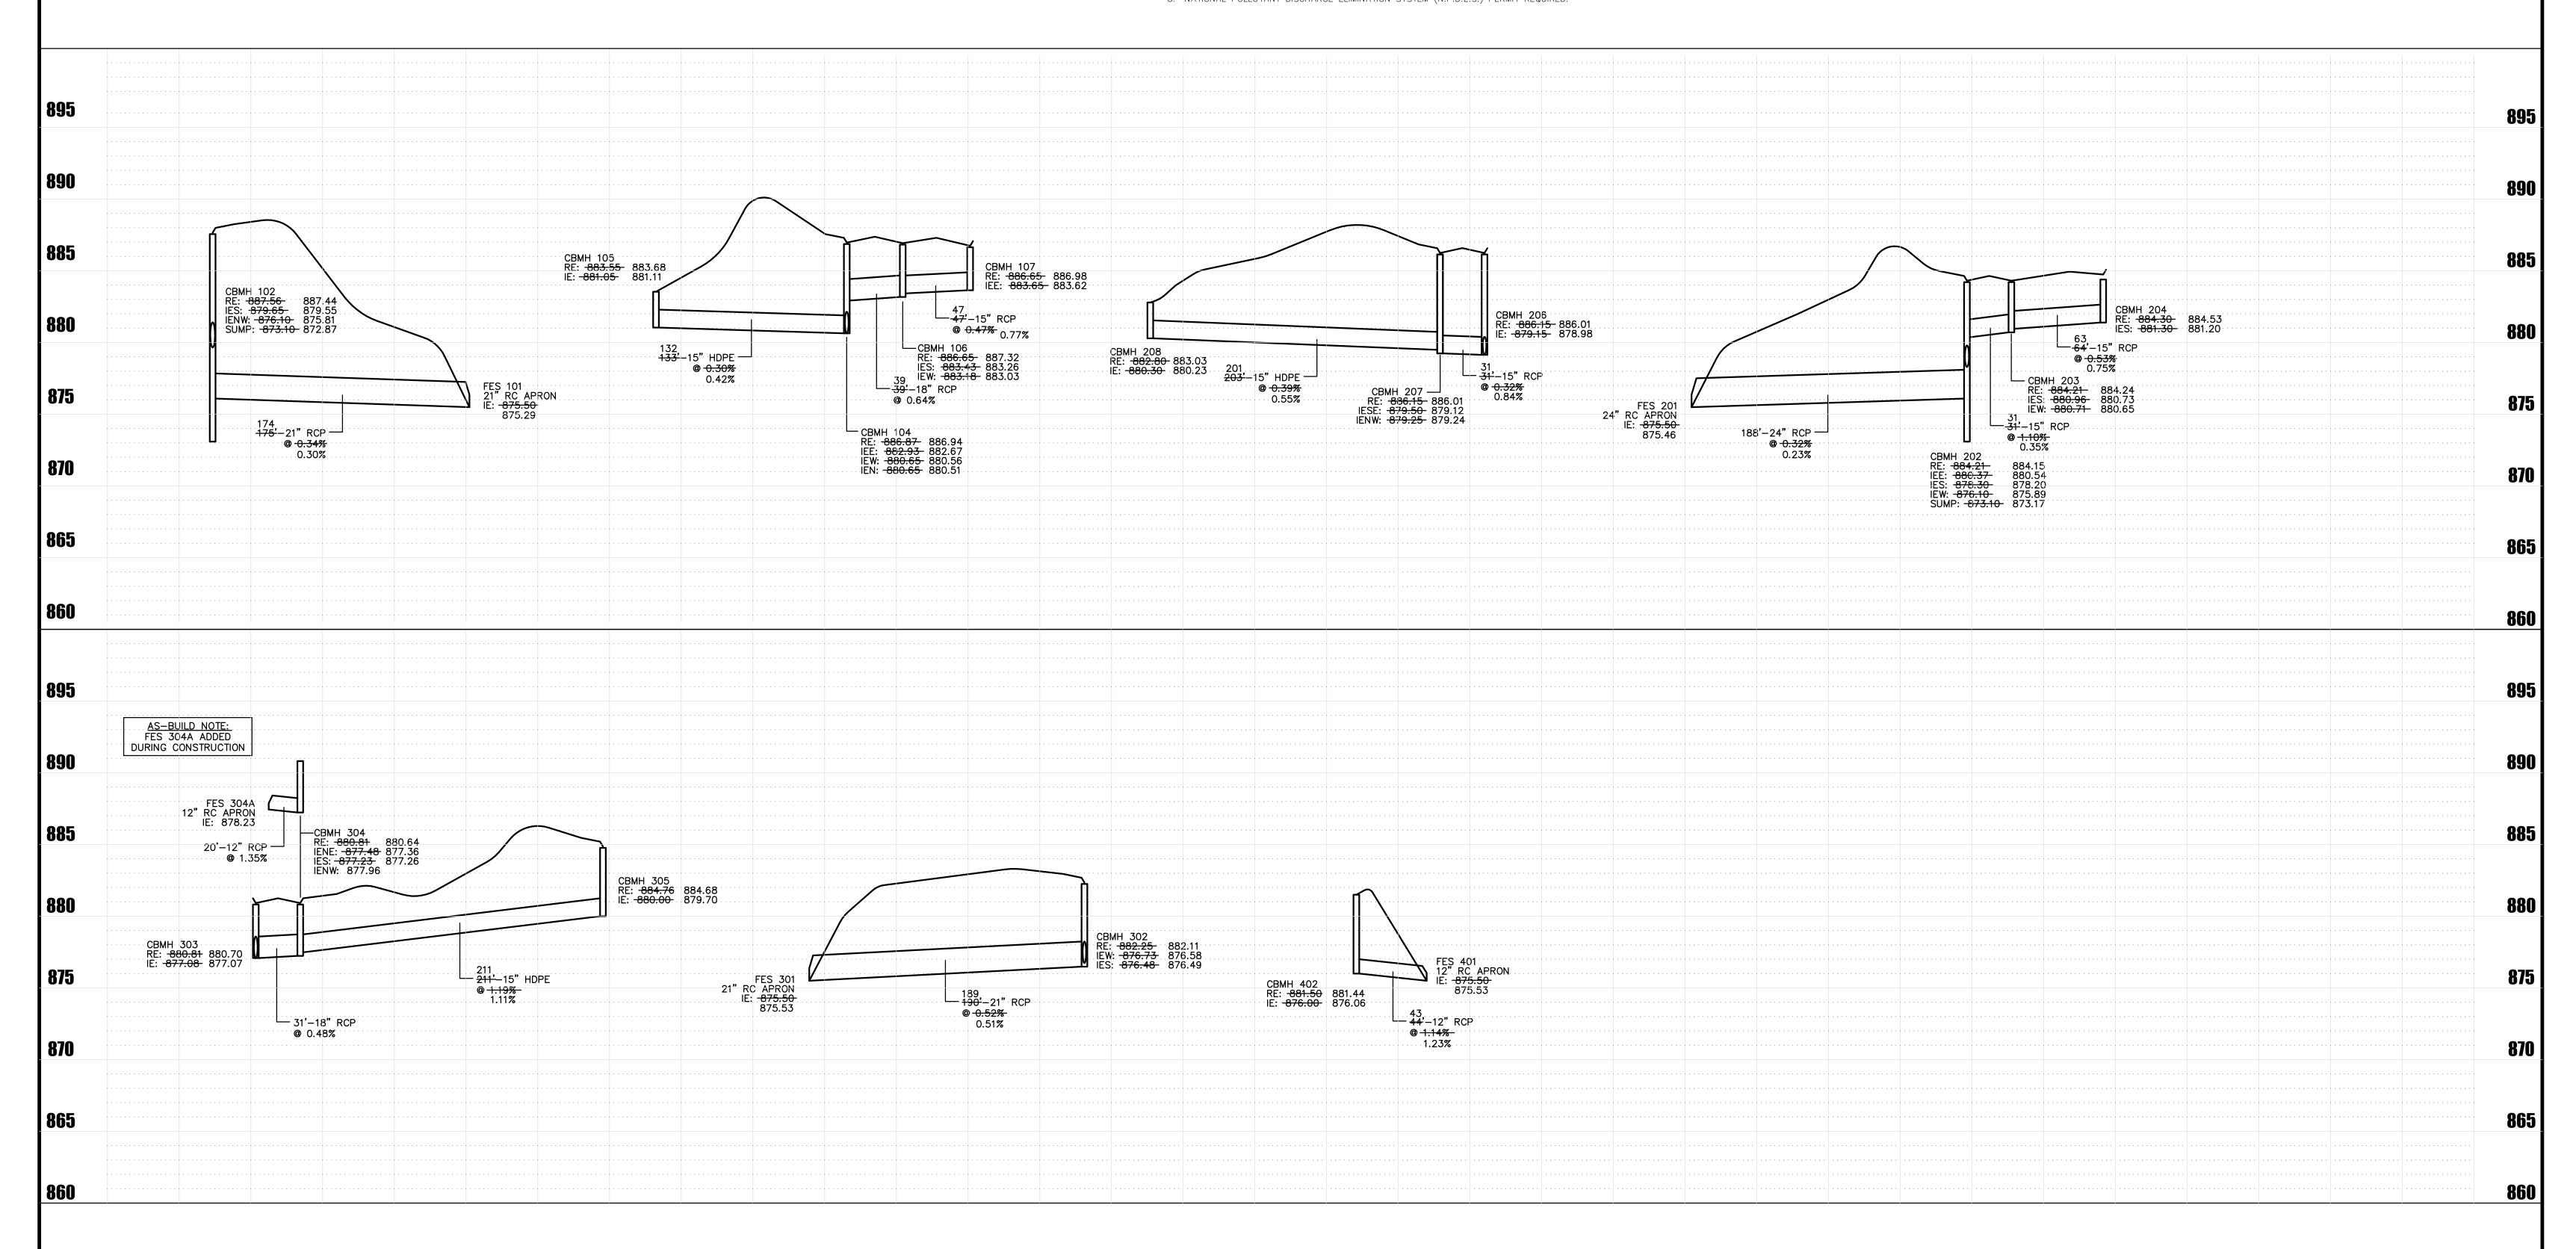





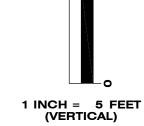

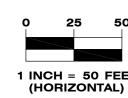



**ELK RIVER, MINNESOTA** 

PLAN/PROFILE STORM SEWER & STREETS

I AM A DULY LICENSED PROFESSIONAL ENGINE
UNDER THE LAWS OF THE STATE OF MINNESOT
$\sim$ $\Omega a$
(selam) Tinket

DATE: 07.29.2020

I HEREBY CERTIFY THAT THIS PLAN WAS PREPARED BY ME OR UNDER MY DIRECT SUPERVISION AND THAT	DATE	REVISION DESCRIPTION
I AM A DULY LICENSED PROFESSIONAL ENGINEER	6-15-18	CITY REVIEW COMMENTS; CONSTRUCTION PLANS
UNDER THE LAWS OF THE STATE OF MINNESOTA.	7-11-18	FINAL PLAT SUBMITTAL
$\sim$ $\Omega$	8-7-18	GRADES ADJ.
	7-11-19	FINAL PLANS
	7-29-20	RECORD DRAWINGS
ADAM SINKEL		
<i> </i>		

CHCKD BY: PROJ. NO. C.W.P. 18-1747