


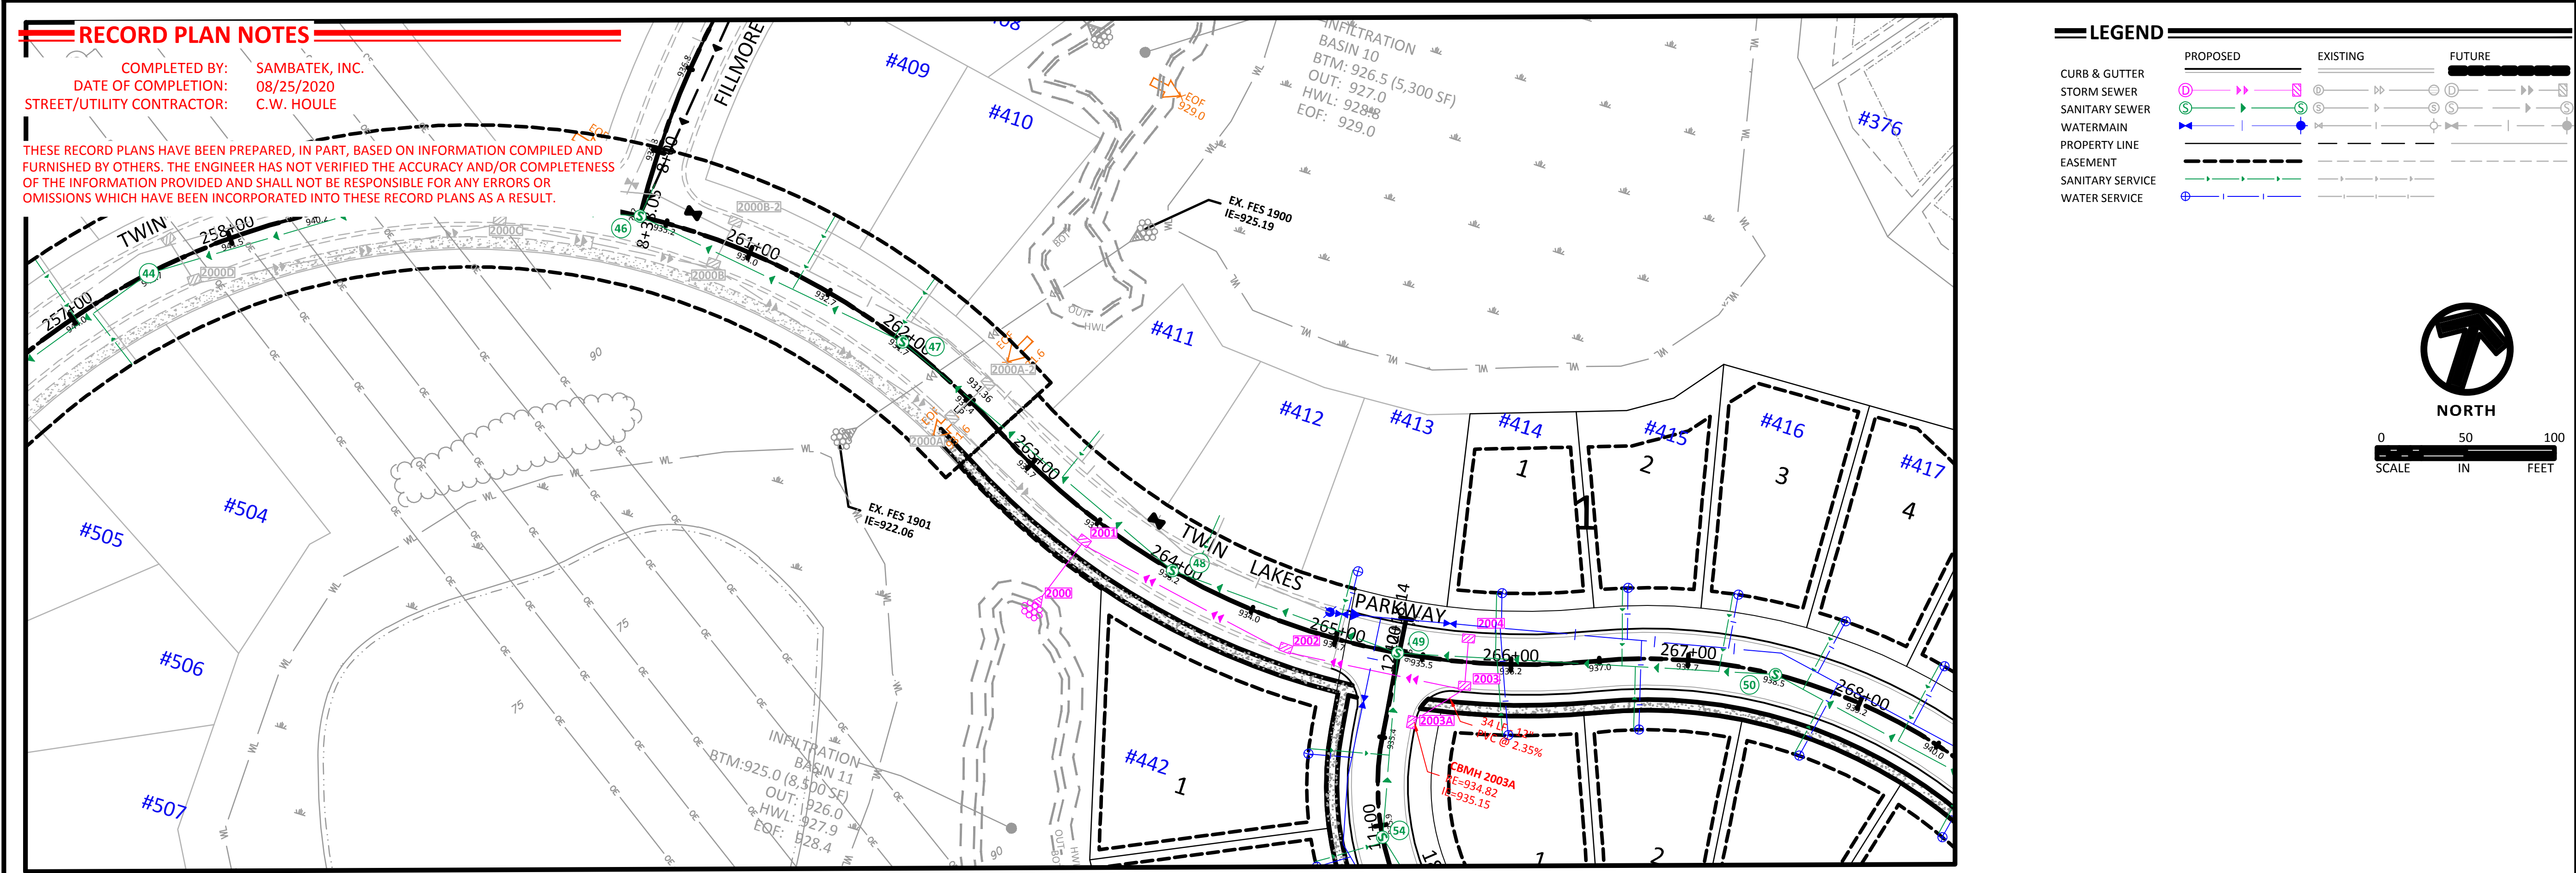

Sambatek

www.sambatek.com

12800 Whitewater Drive, Suite 300

Minnetonka, MN 55343

763.476.6010 telephone

763.476.8532 facsimile

Engineering | Surveying | Planning | Environmental

Client
PAXMAR, LLC.

2850 CUTTERS GROVE AVE
SUITE 207
ANOKA, MN 55303

Project
MISKE
MEADOWS
SIXTH ADDITION

Location
ELK RIVER, MN

Certification

I hereby certify that this plan, specification or report was prepared by me or under my direct supervision and that I am a duly licensed professional ENGINEER under the laws of the state of Minnesota.

Eric T. Luth

Registration No. 50475 Date: ##/##/2020

If applicable, contact us for a wet signed copy of this plan which is available upon request at Sambatek's, Minnetonka, MN office.

Summary

Designed: ETL Drawn: CIS
Approved: ETL Initial Issue: ##/##/2020
Phase: RECORD PLANS

Revision History

No.	Date By	Submittal / Revision
##/##/2020	RECORD PLANS	

Sheet Title

STORM SEWER
PLAN & PROFILE
2000

RECORD PLAN

Sheet No. Revision

C7.01

Project No.

20460.07