



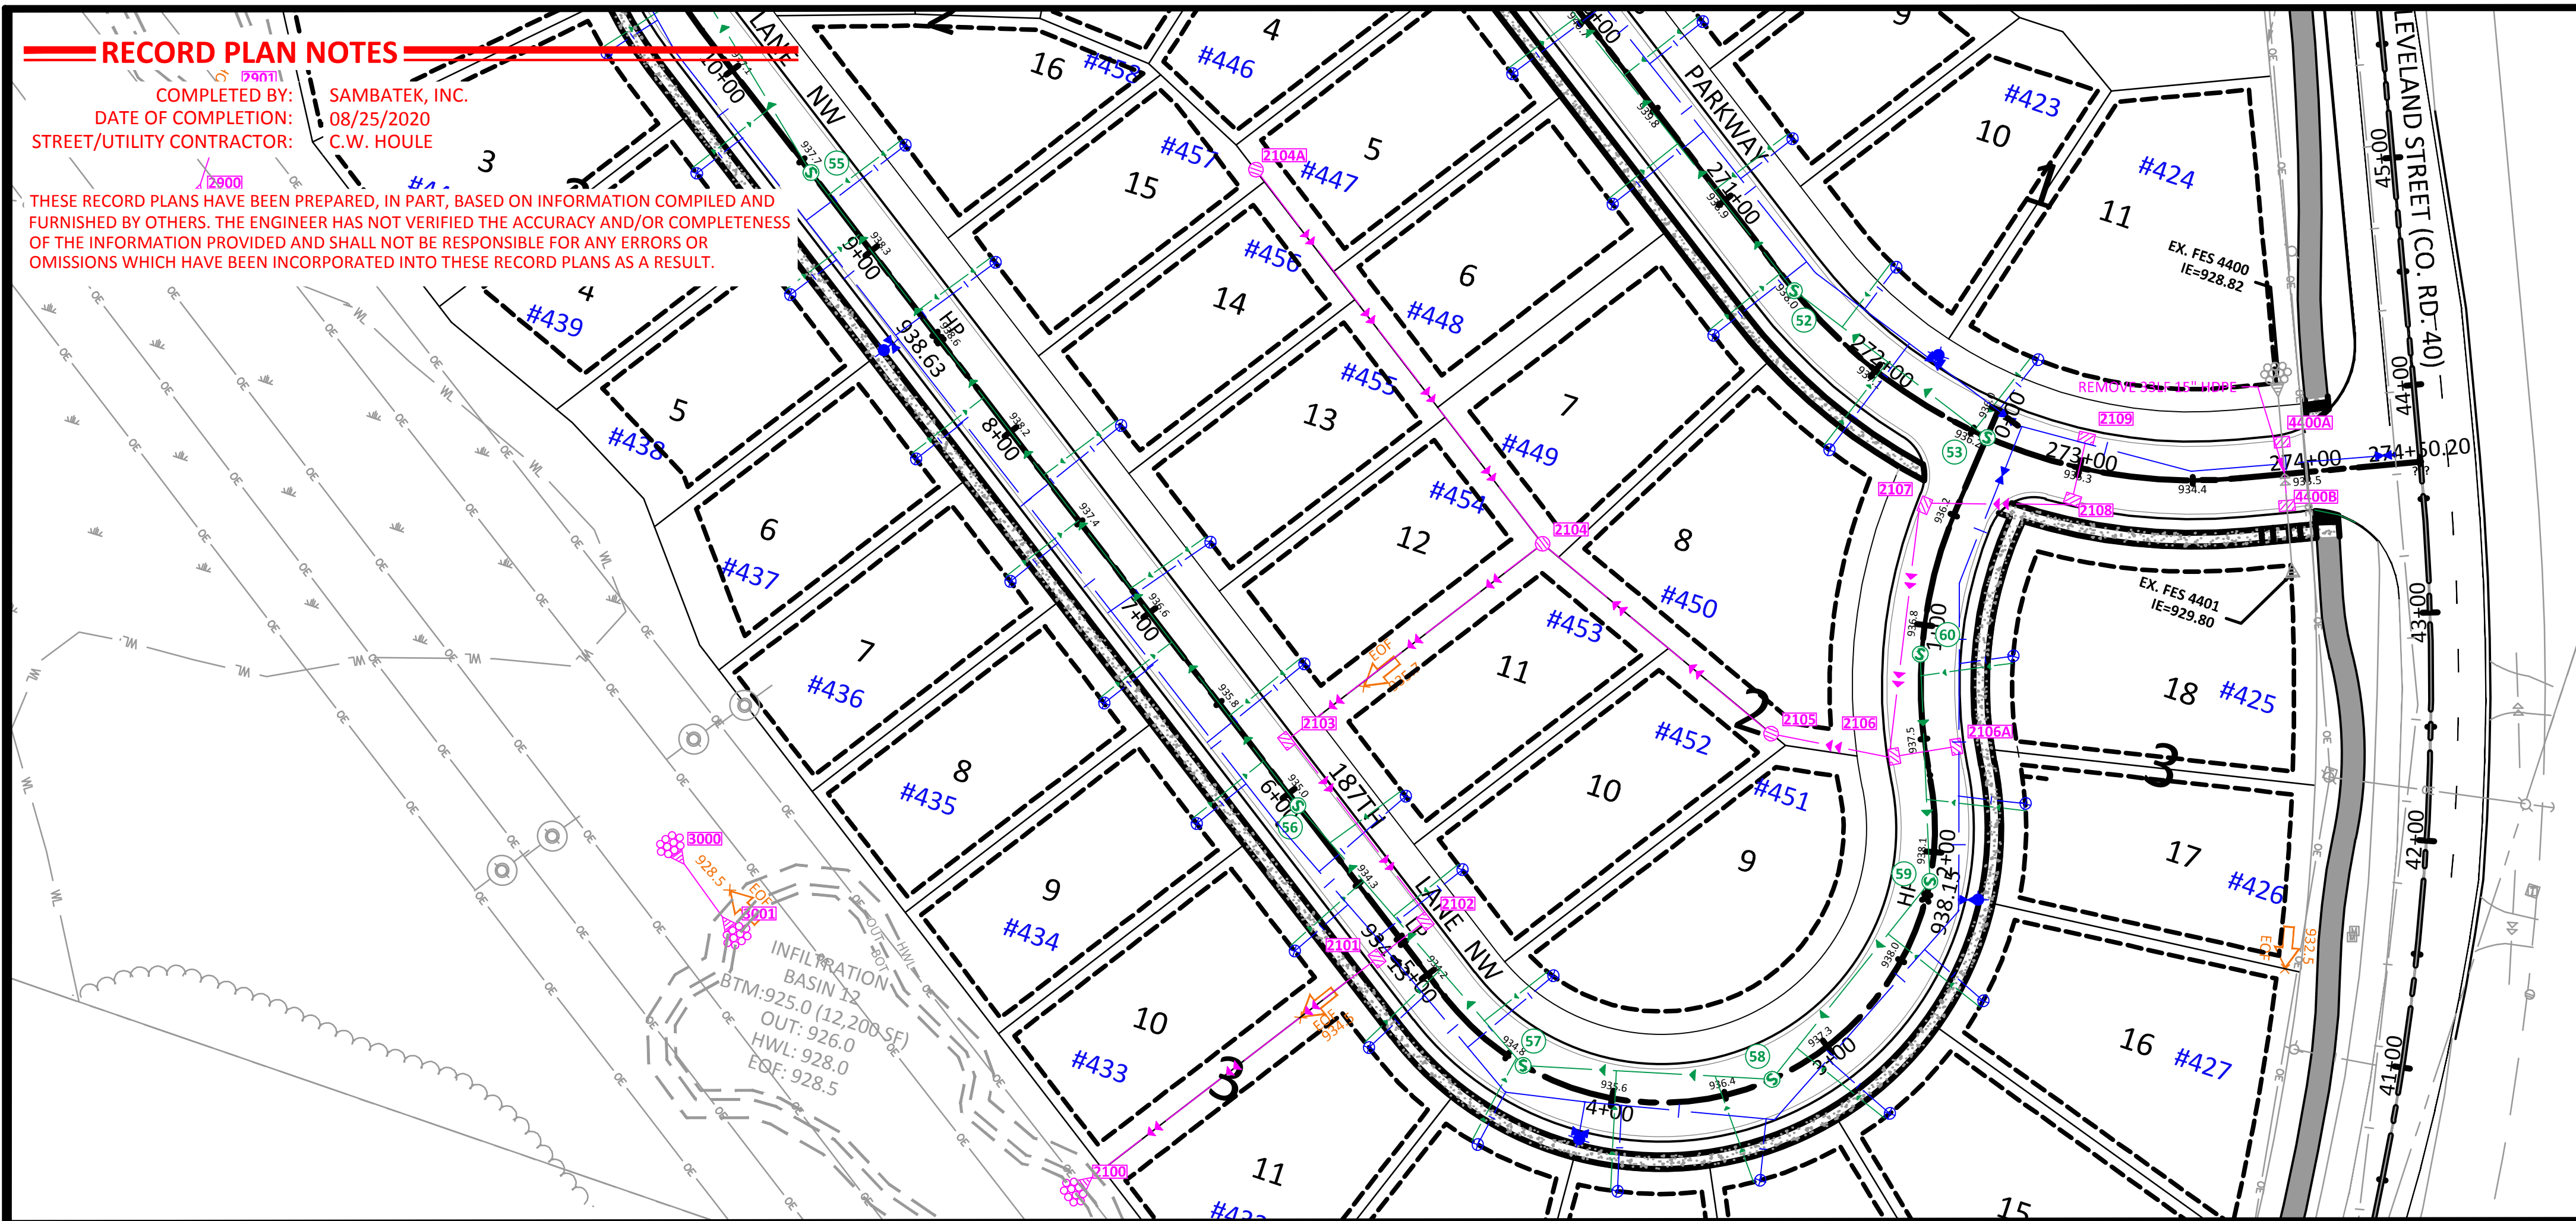

LEGEND

	PROPOSED	EXISTING	FUTURE
CURB & GUTTER			
STORM SEWER			
SANITARY SEWER			
WATERMAIN			
PROPERTY LINE			
EASEMENT			
SANITARY SERVICE			
WATER SERVICE			

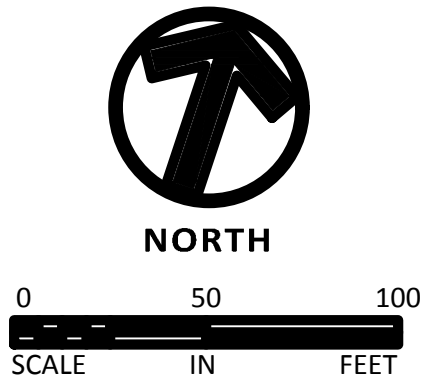

SCALE
HORIZONTAL: 1"=50'
VERTICAL: 1"=10'

Sambatek
www.sambatek.com
12800 Whitewater Drive, Suite 300
Minnetonka, MN 55343
763.476.6010 telephone
763.476.8532 facsimile
Engineering | Surveying | Planning | Environmental

Client
PAXMAR, LLC.

2850 CUTTERS GROVE AVE
SUITE 207
ANOKA, MN 55303

Project
MISKE
MEADOWS
SIXTH ADDITION

Location
ELK RIVER, MN

Certification
I hereby certify that this plan, specification or report was prepared by me or under my direct supervision and that I am a duly licensed professional ENGINEER under the laws of the state of Minnesota.

Eric T. Luth
Eric T. Luth
Registration No. 50475 Date: ##/##/2020
If applicable, contact us for a wet signed copy of this plan which is available upon request at Sambatek's, Minnetonka, MN office.

Summary
Designed: ETL Drawn: CIS
Approved: ETL Initial Issue: ##/##/2020
Phase: RECORD PLANS


Revision History
No. Date By Submittal / Revision
##/##/2020 RECORD PLANS

Structure Table						
STR. #	TYPE	DIA.	RIM	BLD	IE	CASTING
2100	FES	30"Ø			926.0	8 X 8
2101	CBMH	60"Ø	933.8	10.6	926.8	R-3067-VB
2102	CBMH	72"Ø	933.8	6.9	926.9	R-3067-VB
2103	CBMH	72"Ø	935.0	7.6	927.4	R-3067-V
2104	CBMH	60"Ø	931.2	3.1	928.1	R-4342
2105	CBMH	48"Ø	933.8	5.0	928.8	R-4342
2106	CBMH	60"Ø	937.3	8.3	929.0	R-3067-V
2107	CBMH	48"Ø	935.7	5.8	929.9	R-3067-V
2108	CBMH	48"Ø	935.2	4.6	930.6	R-3067-V
2109	CB	2' X 3'	935.0	4.1	930.9	R-3067-V

FES Table					
STR.	TYPE	DIA.	IE	BLD	CASTING
3000	FES	24"	925.8	8 X 8	
3001	FES	24"	926.0	8 X 8	

FES Table					
STR. LBL	TYPE	DIA.	IE	FLEX	AMAT
2900	FES	24"	922.8	8 X 8	

Structure Table						
STR. #	TYPE	DIA.	RIM	BLD	IE	CASTING
2104A	CBMH	27"Ø	932.4	3.2	929.2	R-4342
2106A	CB	2' X 3'	937.3	4.0	933.3	R-3067-V
4400A	CBMH	48"Ø	932.9	7.2	932.9	R-3067-VB
4400B	CBMH	48"Ø	933.6	4.0	933.6	R-3067-VB

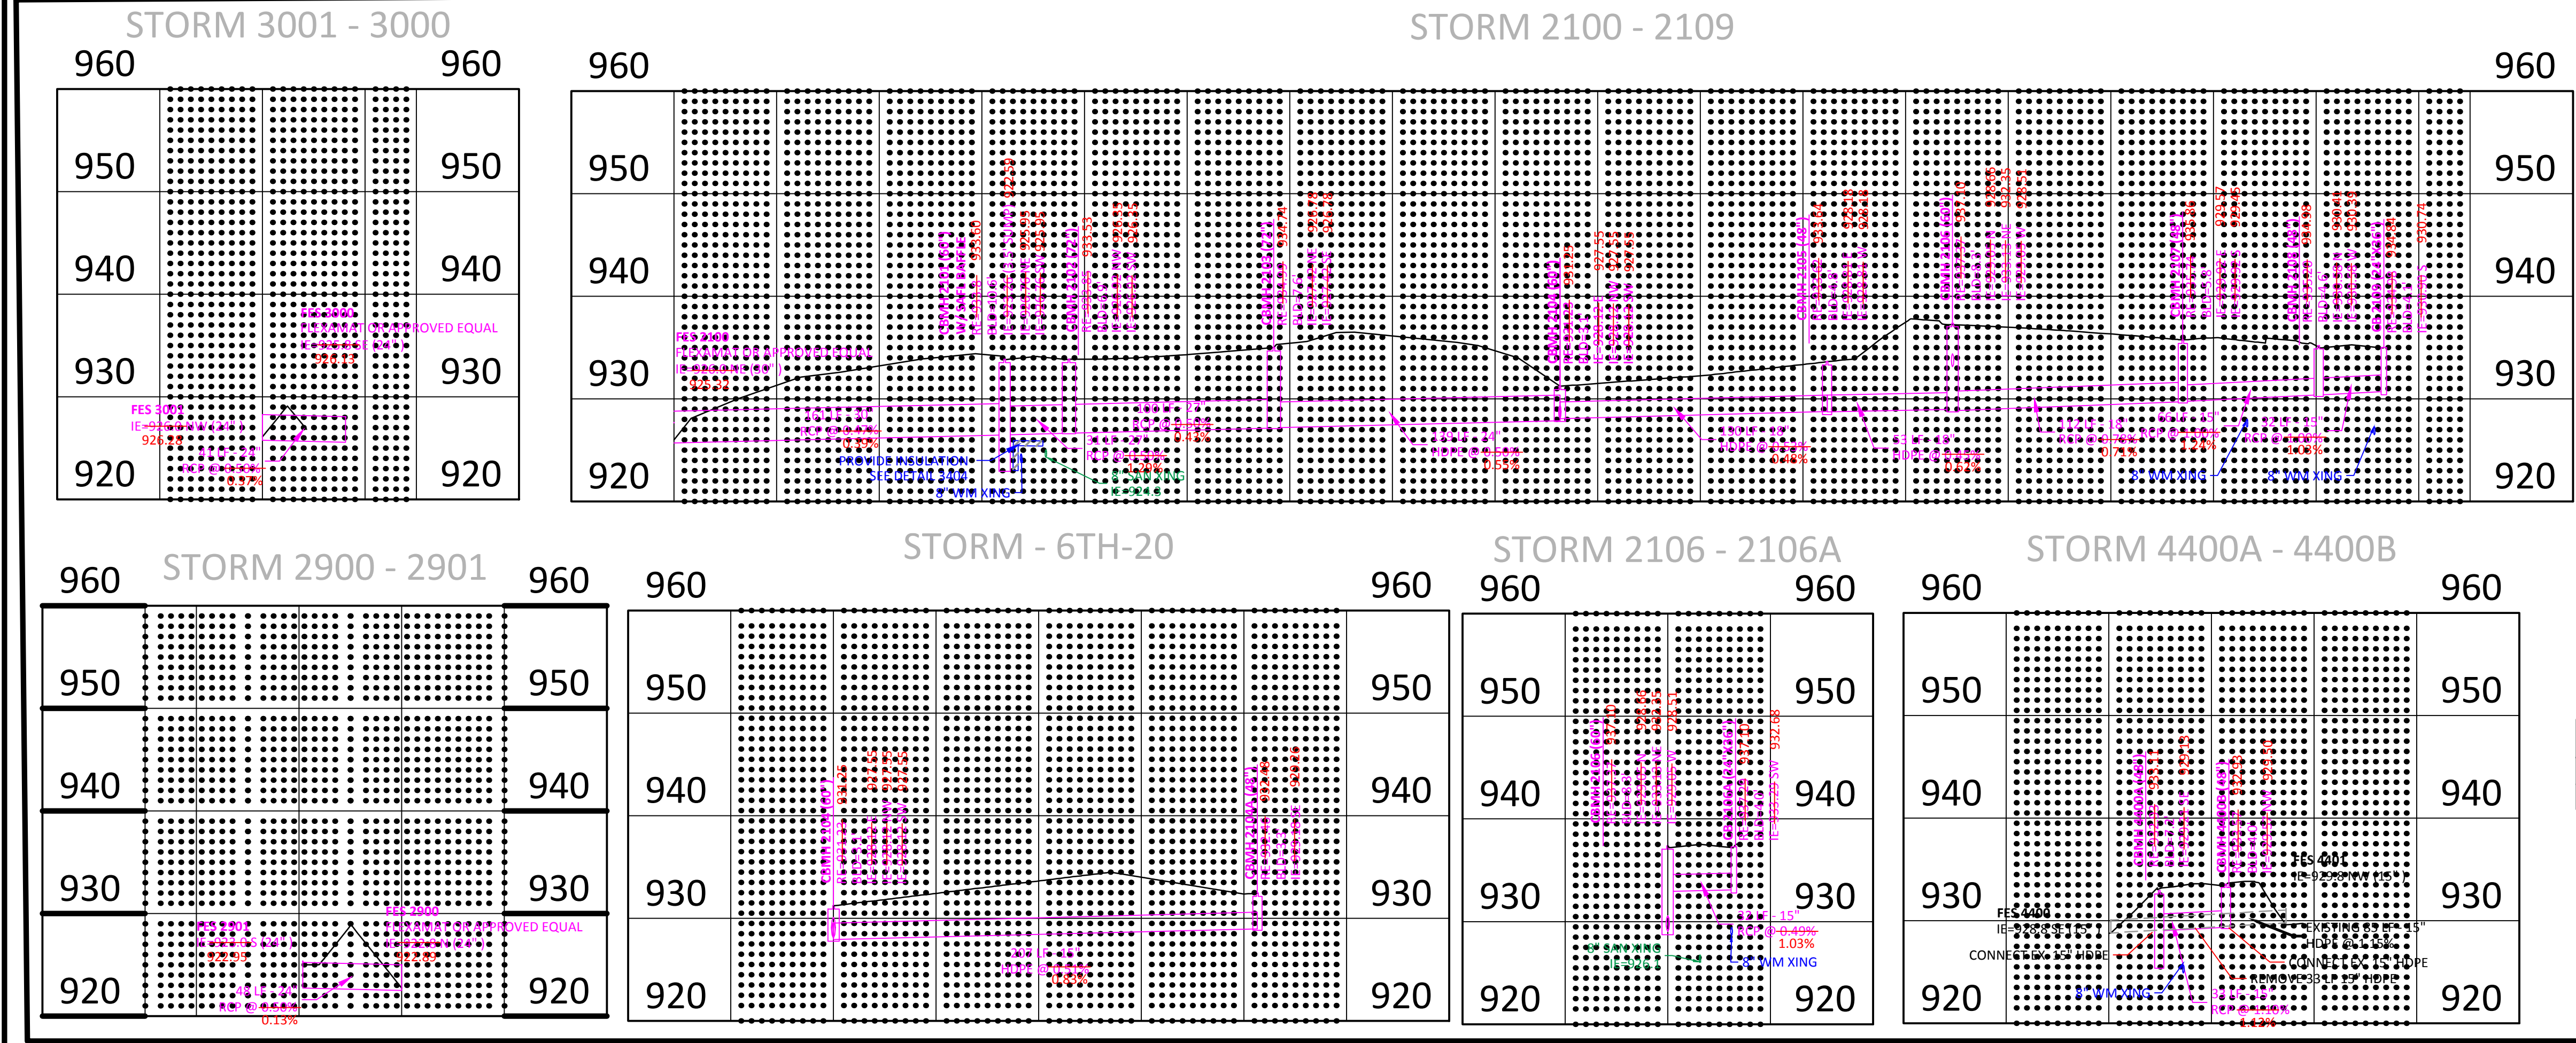

Sheet Title
STORM SEWER
PLAN & PROFILE
(MISC)

RECORD PLAN
Sheet No. Revision
C7.02

Project No. 20460.07