


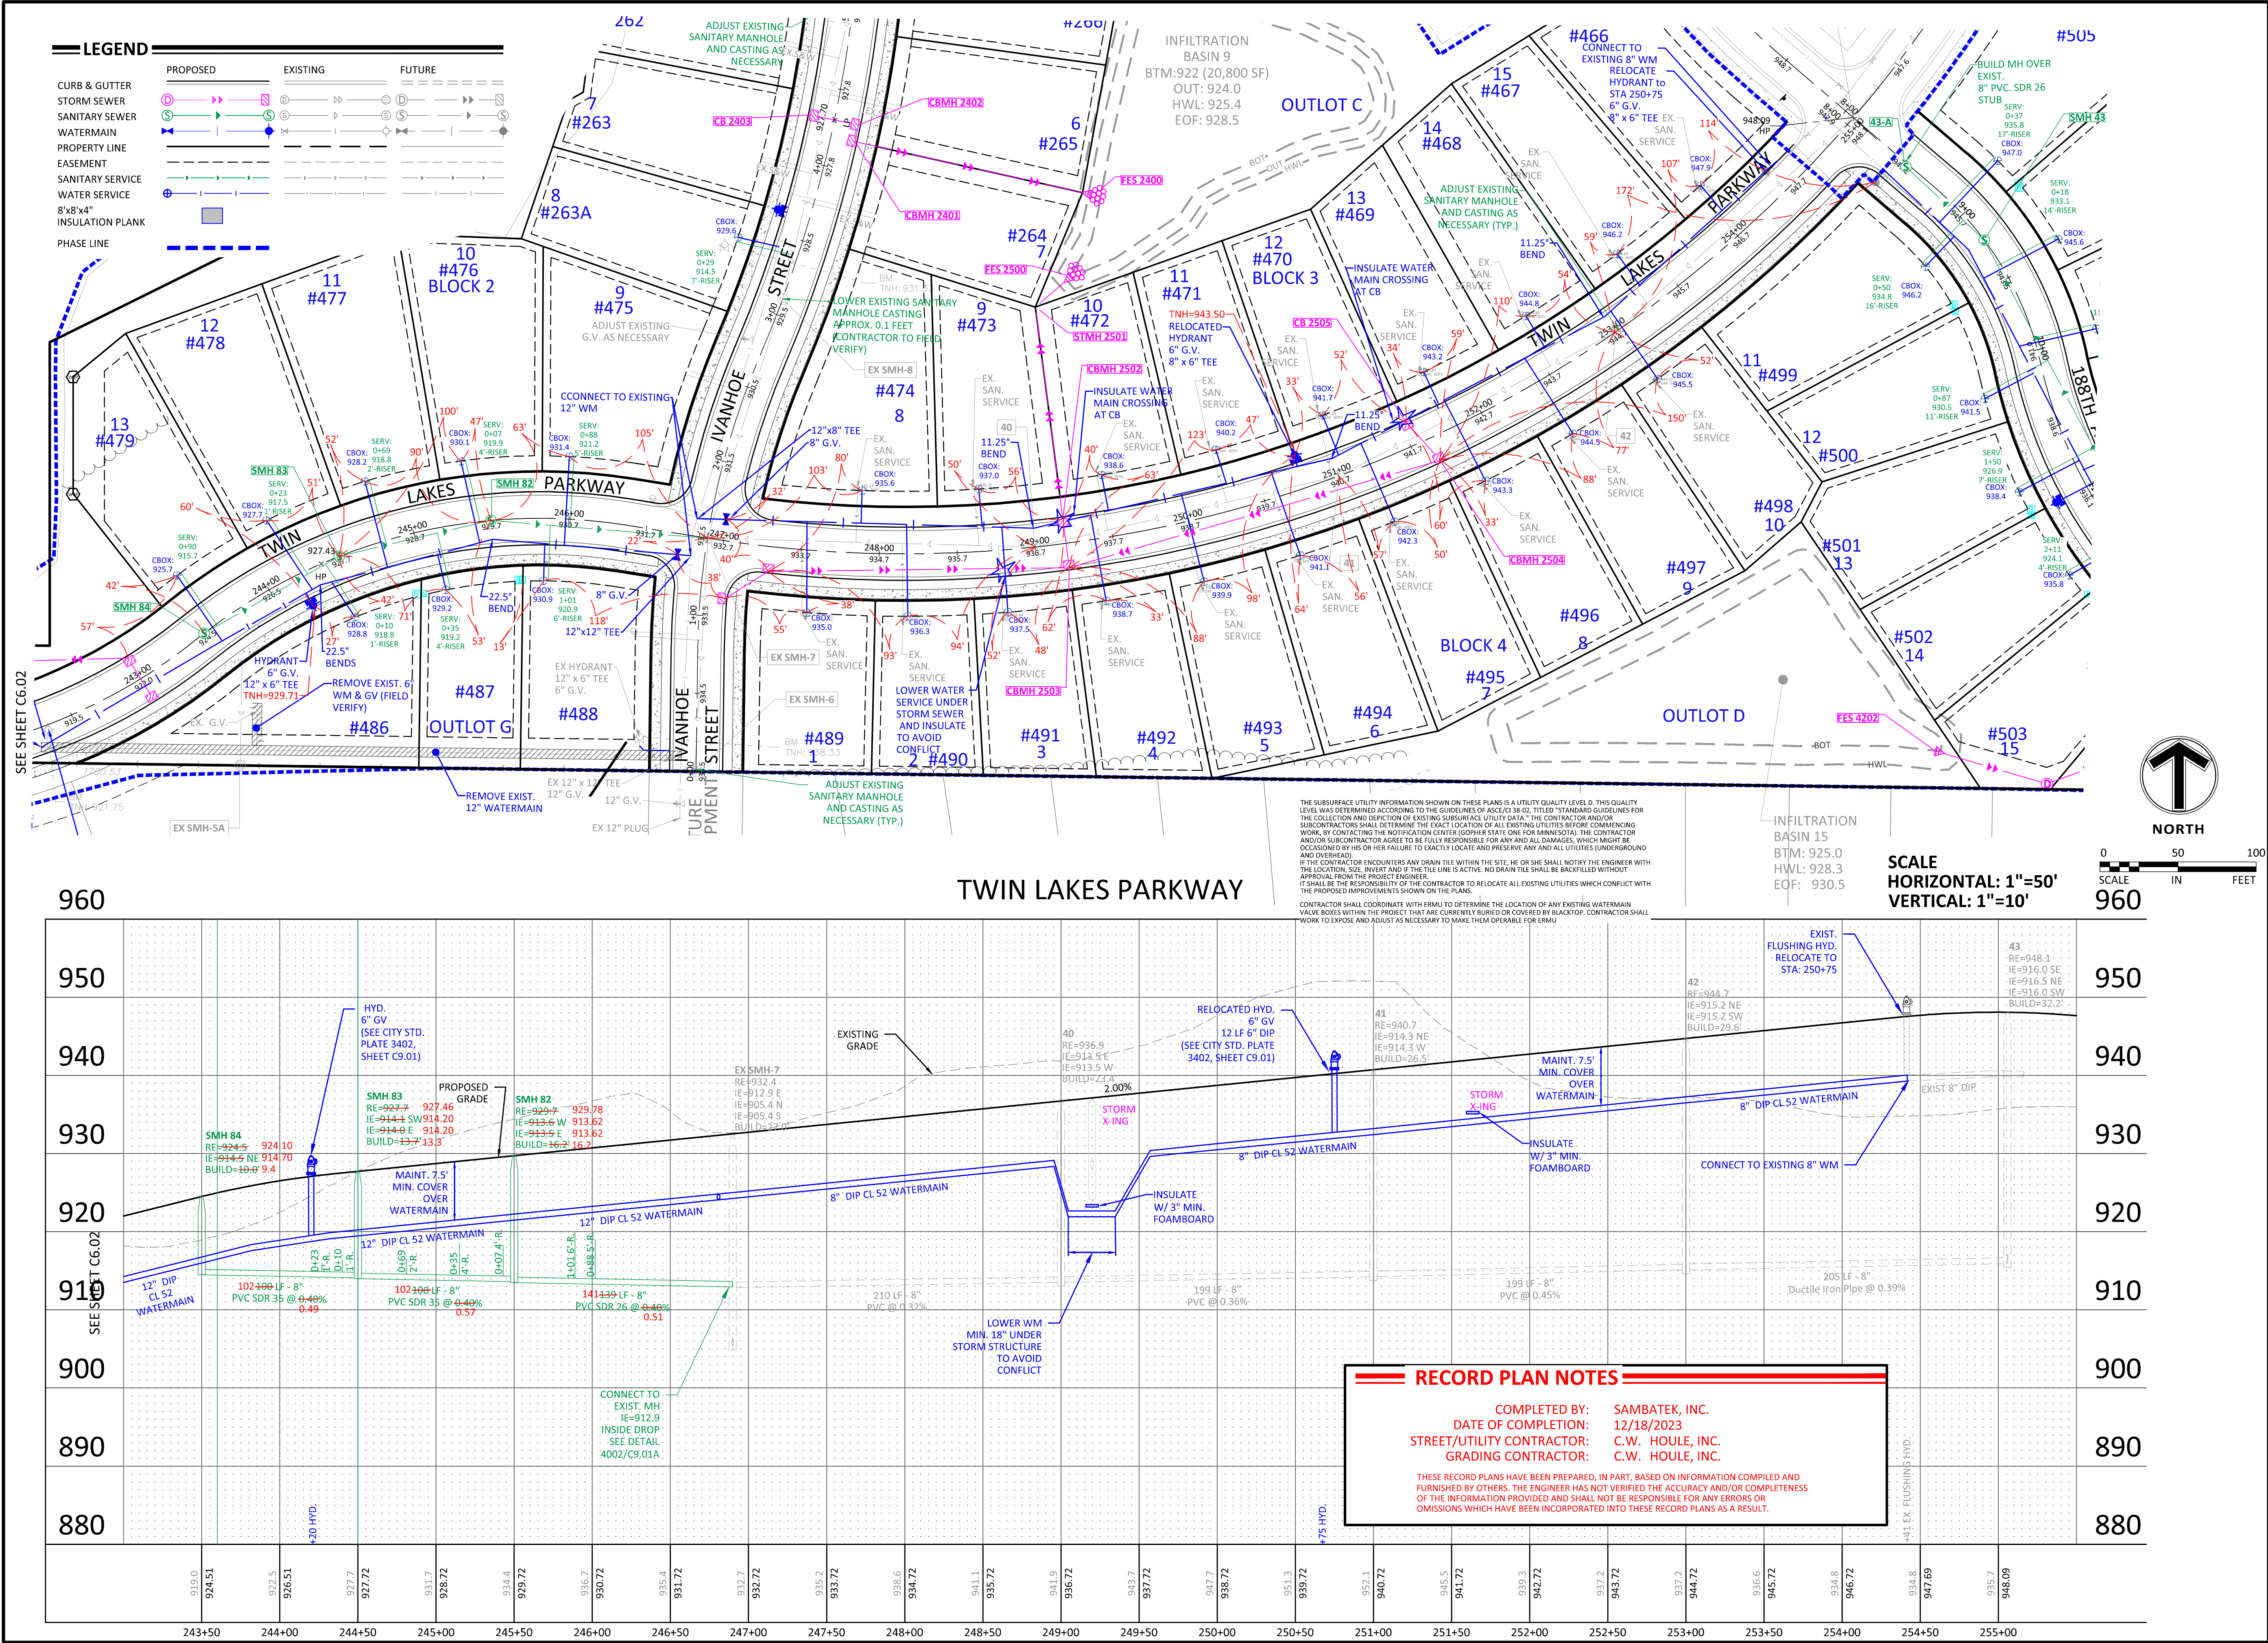

Client
LGI HOMES-
Minnesota, LLC

2850 CUTTERS GROVE AVENUE
SUITE 207
ANOKA, MN 55303

Project
MISKE
MEADOWS
EIGHTH
ADDITION

Location
ELK RIVER, MN

Certification
I hereby certify that this plan, specification or report was prepared by me or under my direct supervision and that I am a duly licensed professional ENGINEER under the laws of the state of Minnesota.

Eric T. Luth
Registration No. 50475 Date: 06/30/2022
If applicable, contact us for a wet signed copy of this plan which is available upon request at Sambatek's, Minnetonka, MN office.

Summary
Designed: JEB Drawn: TPK/CE/JLB
Approved: ETL Initial Issue: 06/30/2022
Phase: CONSTRUCTION

Revision History
No. Date By Submittal / Revision
06/30/2022 CONSTRUCTION DOCUMENTS
6/08/2023 RECORD PLANS

Sheet Title
UTILITY PLAN -
TWIN LAKES
PARKWAY

Sheet No. Revision
C6.03

Project No. 20460.80