




248 Railroad Drive  
 Elk River, MN 55330  
 Phone: 763-635-1170

<b>Owner</b> City of Elk River	<b>Pipe Number</b> P27	<b>Upstream MH</b> MH63	<b>Downstream MH</b> MH58	<b>Date</b> 30-Nov-2023
<b>Surveyor</b> Andy and Tyler	<b>Street</b> Concord		<b>City</b> Elk River	<b>Time</b> 2:10 PM
<b>Size</b> 8	<b>Material</b> PVC	<b>Sewer Use</b> Sanitary	<b>Purpose</b> Annual Review	<b>Length</b> 299.095 4
			<b>(TV'd)</b> 291.1	<b>Pre-Clean</b> No Pre-Cleaning
				<b>Weather</b> Dry

**Comments**

P27

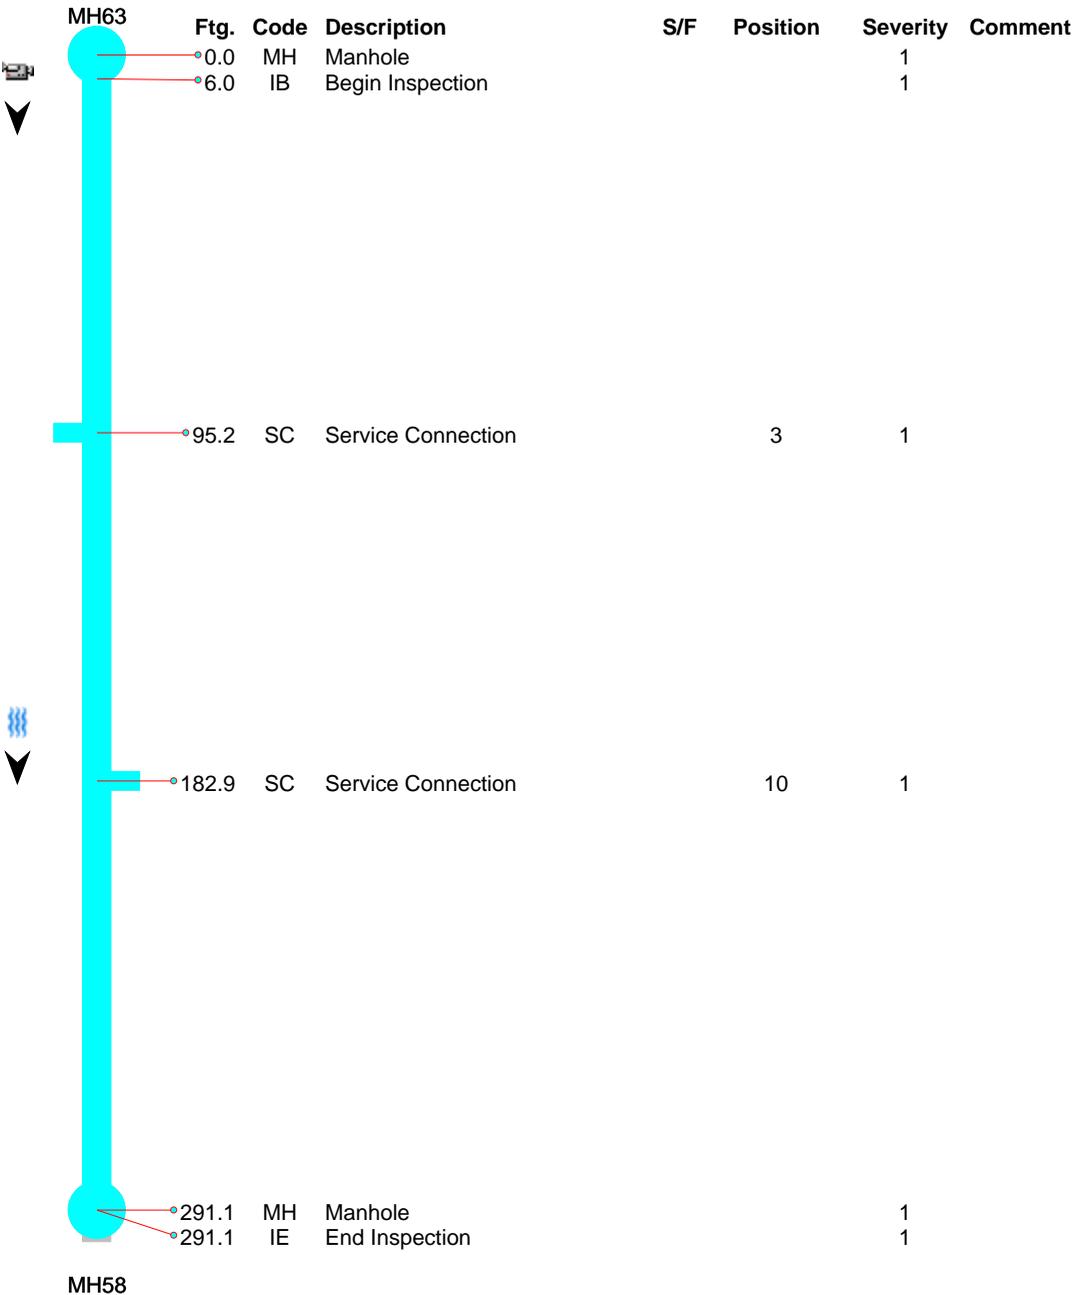



248 Railroad Drive  
Elk River, MN 55330  
Phone: 763-635-1170

<b>Owner</b> City of Elk River	<b>Pipe Number</b> P27	<b>Upstream MH</b> MH63	<b>Downstream MH</b> MH58	<b>Date</b> 30-Nov-2023
<b>Surveyor</b> Andy and Tyler	<b>Street</b> Concord		<b>City</b> Elk River	<b>Time</b> 2:10 PM
<b>Size</b> 8	<b>Material</b> PVC	<b>Sewer Use</b> Sanitary	<b>Purpose</b> Annual Review	<b>Length</b> 299.095 4
			<b>(TV'd)</b> 291.1	<b>Pre-Clean</b> No Pre-Cleaning
				<b>Weather</b> Dry

**Comments**

P27



MH - Manhole @ 0.0 ft.



248 Railroad Drive  
Elk River, MN 55330  
Phone: 763-635-1170

<b>Owner</b> City of Elk River	<b>Pipe Number</b> P27	<b>Upstream MH</b> MH63	<b>Downstream MH</b> MH58	<b>Date</b> 30-Nov-2023			
<b>Surveyor</b> Andy and Tyler	<b>Street</b> Concord		<b>City</b> Elk River	<b>Time</b> 2:10 PM			
<b>Size</b> 8	<b>Material</b> PVC	<b>Sewer Use</b> Sanitary	<b>Purpose</b> Annual Review	<b>Length</b> 299.095 4	<b>(TV'd)</b> 291.1	<b>Pre-Clean</b> No Pre-Cleaning	<b>Weather</b> Dry

**Comments**

P27



IB - Begin Inspection @ 6.0 ft.



248 Railroad Drive  
Elk River, MN 55330  
Phone: 763-635-1170

<b>Owner</b> City of Elk River	<b>Pipe Number</b> P27	<b>Upstream MH</b> MH63	<b>Downstream MH</b> MH58	<b>Date</b> 30-Nov-2023			
<b>Surveyor</b> Andy and Tyler	<b>Street</b> Concord		<b>City</b> Elk River	<b>Time</b> 2:10 PM			
<b>Size</b> 8	<b>Material</b> PVC	<b>Sewer Use</b> Sanitary	<b>Purpose</b> Annual Review	<b>Length</b> 299.095 4	<b>(TV'd)</b> 291.1	<b>Pre-Clean</b> No Pre-Cleaning	<b>Weather</b> Dry

**Comments**

P27



SC - Service Connection @ 95.2 ft.




248 Railroad Drive  
Elk River, MN 55330  
Phone: 763-635-1170

<b>Owner</b> City of Elk River	<b>Pipe Number</b> P27	<b>Upstream MH</b> MH63	<b>Downstream MH</b> MH58	<b>Date</b> 30-Nov-2023			
<b>Surveyor</b> Andy and Tyler	<b>Street</b> Concord		<b>City</b> Elk River	<b>Time</b> 2:10 PM			
<b>Size</b> 8	<b>Material</b> PVC	<b>Sewer Use</b> Sanitary	<b>Purpose</b> Annual Review	<b>Length</b> 299.095 4	<b>(TV'd)</b> 291.1	<b>Pre-Clean</b> No Pre-Cleaning	<b>Weather</b> Dry

**Comments**

P27

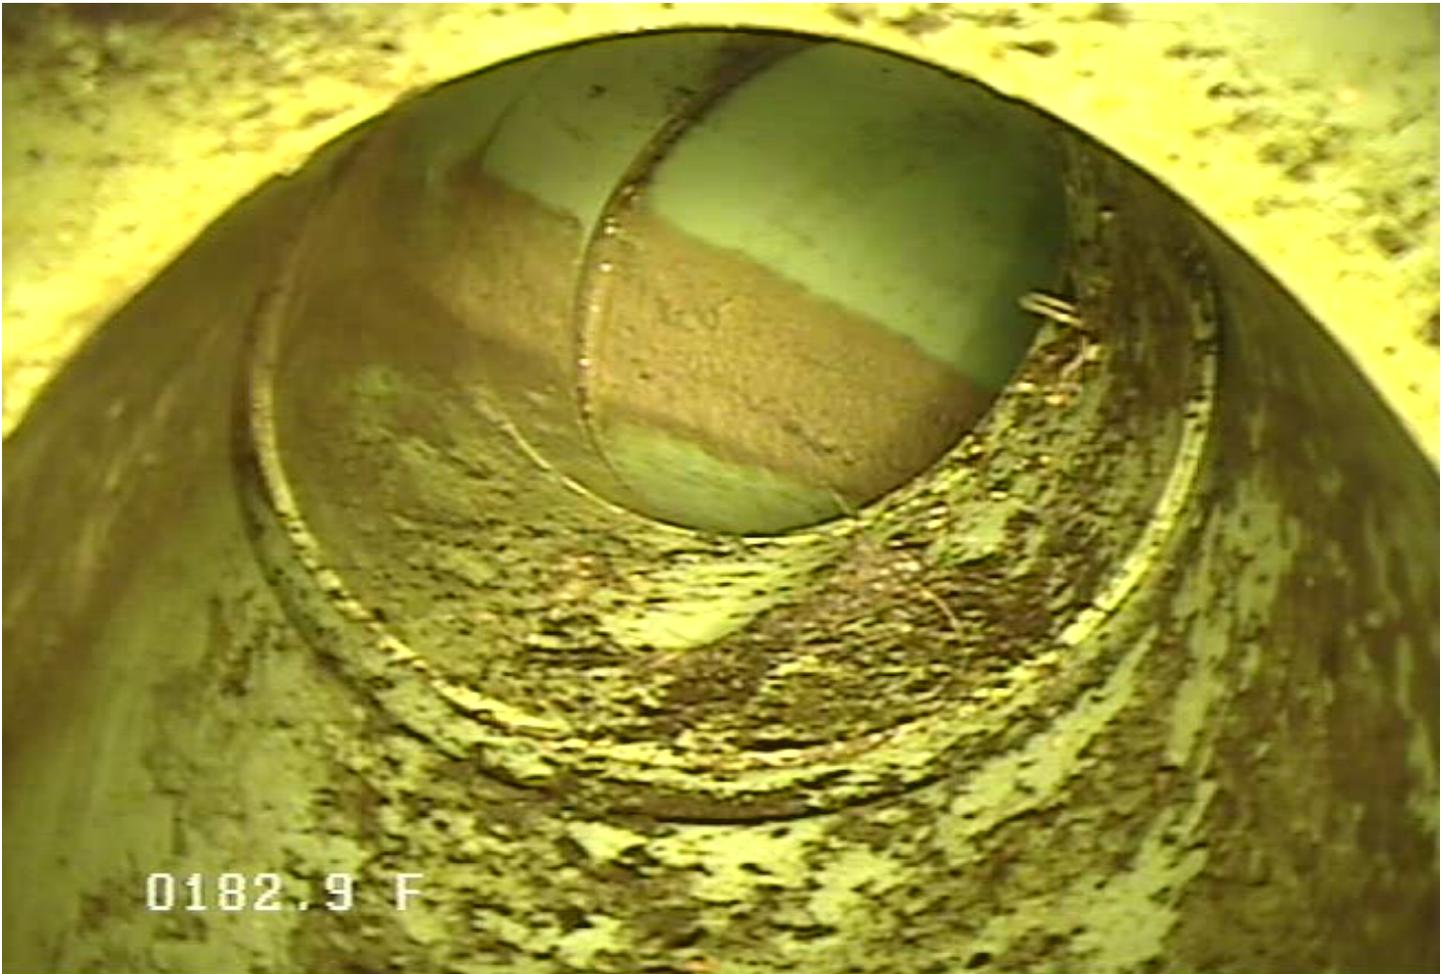

SC - Service Connection @ 182.9 ft.



248 Railroad Drive  
Elk River, MN 55330  
Phone: 763-635-1170

<b>Owner</b> City of Elk River	<b>Pipe Number</b> P27	<b>Upstream MH</b> MH63	<b>Downstream MH</b> MH58	<b>Date</b> 30-Nov-2023			
<b>Surveyor</b> Andy and Tyler	<b>Street</b> Concord		<b>City</b> Elk River	<b>Time</b> 2:10 PM			
<b>Size</b> 8	<b>Material</b> PVC	<b>Sewer Use</b> Sanitary	<b>Purpose</b> Annual Review	<b>Length</b> 299.095 4	<b>(TV'd)</b> 291.1	<b>Pre-Clean</b> No Pre-Cleaning	<b>Weather</b> Dry

**Comments**

P27



MH - Manhole @ 291.1 ft.



248 Railroad Drive  
Elk River, MN 55330  
Phone: 763-635-1170

<b>Owner</b> City of Elk River	<b>Pipe Number</b> P27	<b>Upstream MH</b> MH63	<b>Downstream MH</b> MH58	<b>Date</b> 30-Nov-2023			
<b>Surveyor</b> Andy and Tyler	<b>Street</b> Concord		<b>City</b> Elk River	<b>Time</b> 2:10 PM			
<b>Size</b> 8	<b>Material</b> PVC	<b>Sewer Use</b> Sanitary	<b>Purpose</b> Annual Review	<b>Length</b> 299.095 4	<b>(TV'd)</b> 291.1	<b>Pre-Clean</b> No Pre-Cleaning	<b>Weather</b> Dry

**Comments**

P27



IE - End Inspection @ 291.1 ft.



248 Railroad Drive  
Elk River, MN 55330  
Phone: 763-635-1170

<b>Owner</b> City of Elk River	<b>Pipe Number</b> P27	<b>Upstream MH</b> MH63	<b>Downstream MH</b> MH58	<b>Date</b> 30-Nov-2023			
<b>Surveyor</b> Andy and Tyler	<b>Street</b> Concord		<b>City</b> Elk River	<b>Time</b> 2:10 PM			
<b>Size</b> 8	<b>Material</b> PVC	<b>Sewer Use</b> Sanitary	<b>Purpose</b> Annual Review	<b>Length</b> 299.095 4	<b>(TV'd)</b> 291.1	<b>Pre-Clean</b> No Pre-Cleaning	<b>Weather</b> Dry

**Comments**

P27

