




248 Railroad Drive
Elk River, MN 55330
Phone: 763-635-1170

Owner City of Elk River	Pipe Number P481	Upstream MH 0548	Downstream MH 0549	Date 09-Jun-2021
Surveyor Andy	Street York/Medowvale		City Elk River	Time 10:38 AM
Size 8	Material PVC	Sewer Use Sanitary	Purpose Maintenance Related	Length 212.381 7
			(TV'd) 419.1	Pre-Clean Jetting
				Weather Dry

Comments

Medowvale inspection for replacement 6/9/21 #3

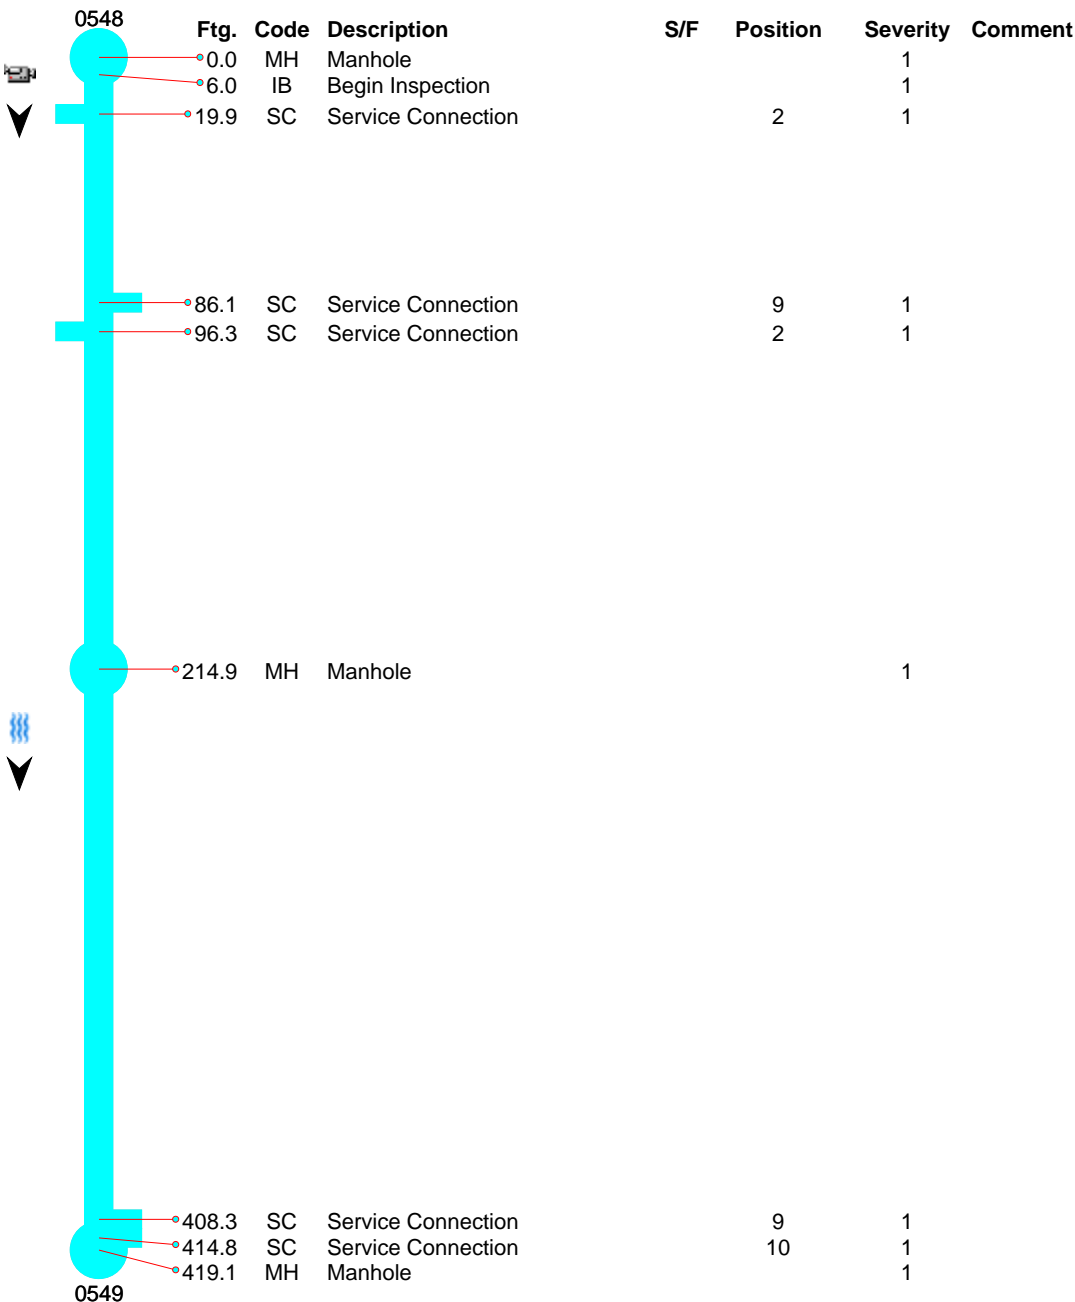




248 Railroad Drive
Elk River, MN 55330
Phone: 763-635-1170

Owner	Pipe Number	Upstream MH	Downstream MH	Date
City of Elk River	P481	0548	0549	09-Jun-2021
Surveyor	Street			City
Andy	York/Medowvale			Elk River
Time	Size	Material	Sewer Use	Purpose
10:38 AM	8	PVC	Sanitary	Maintenance Related
Length	(TV'd)	Pre-Clean	Weather	
212.381 7	419.1	Jetting	Dry	

Comments

Medowvale inspection for replacement 6/9/21 #3

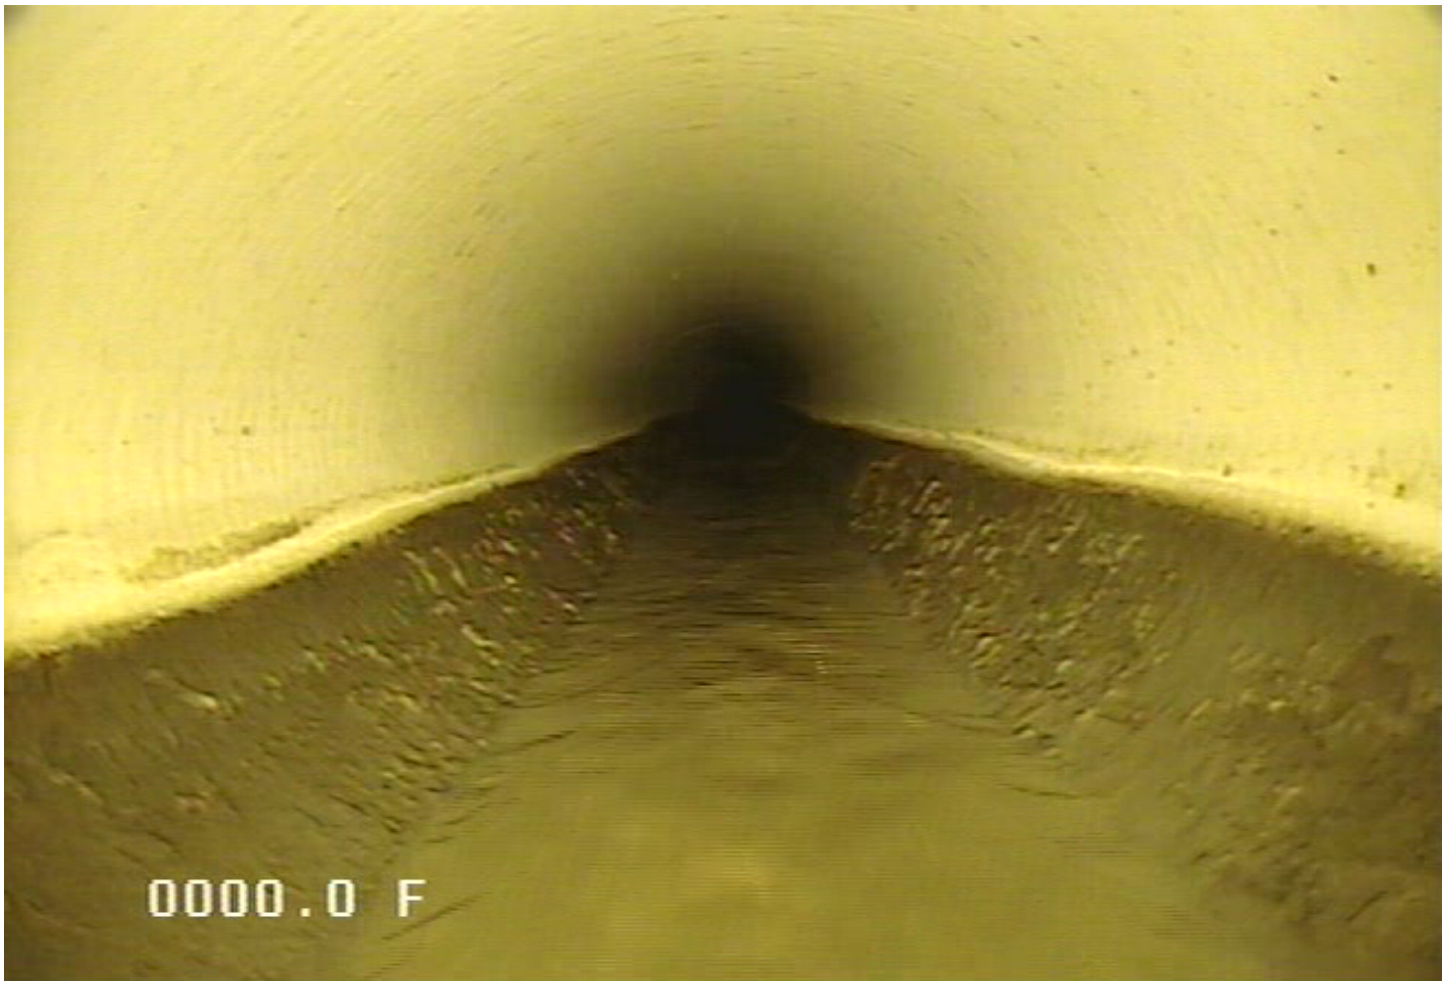

MH - Manhole @ 0.0 ft.




248 Railroad Drive
Elk River, MN 55330
Phone: 763-635-1170

Owner	Pipe Number	Upstream MH	Downstream MH	Date
City of Elk River	P481	0548	0549	09-Jun-2021
Surveyor	Street			City
Andy	York/Medowvale			Elk River
Time	Size	Material	Sewer Use	Purpose
10:38 AM	8	PVC	Sanitary	Maintenance Related
Length	(TV'd)	Pre-Clean	Weather	
212.381 7	419.1	Jetting	Dry	

Comments

Medowvale inspection for replacement 6/9/21 #3

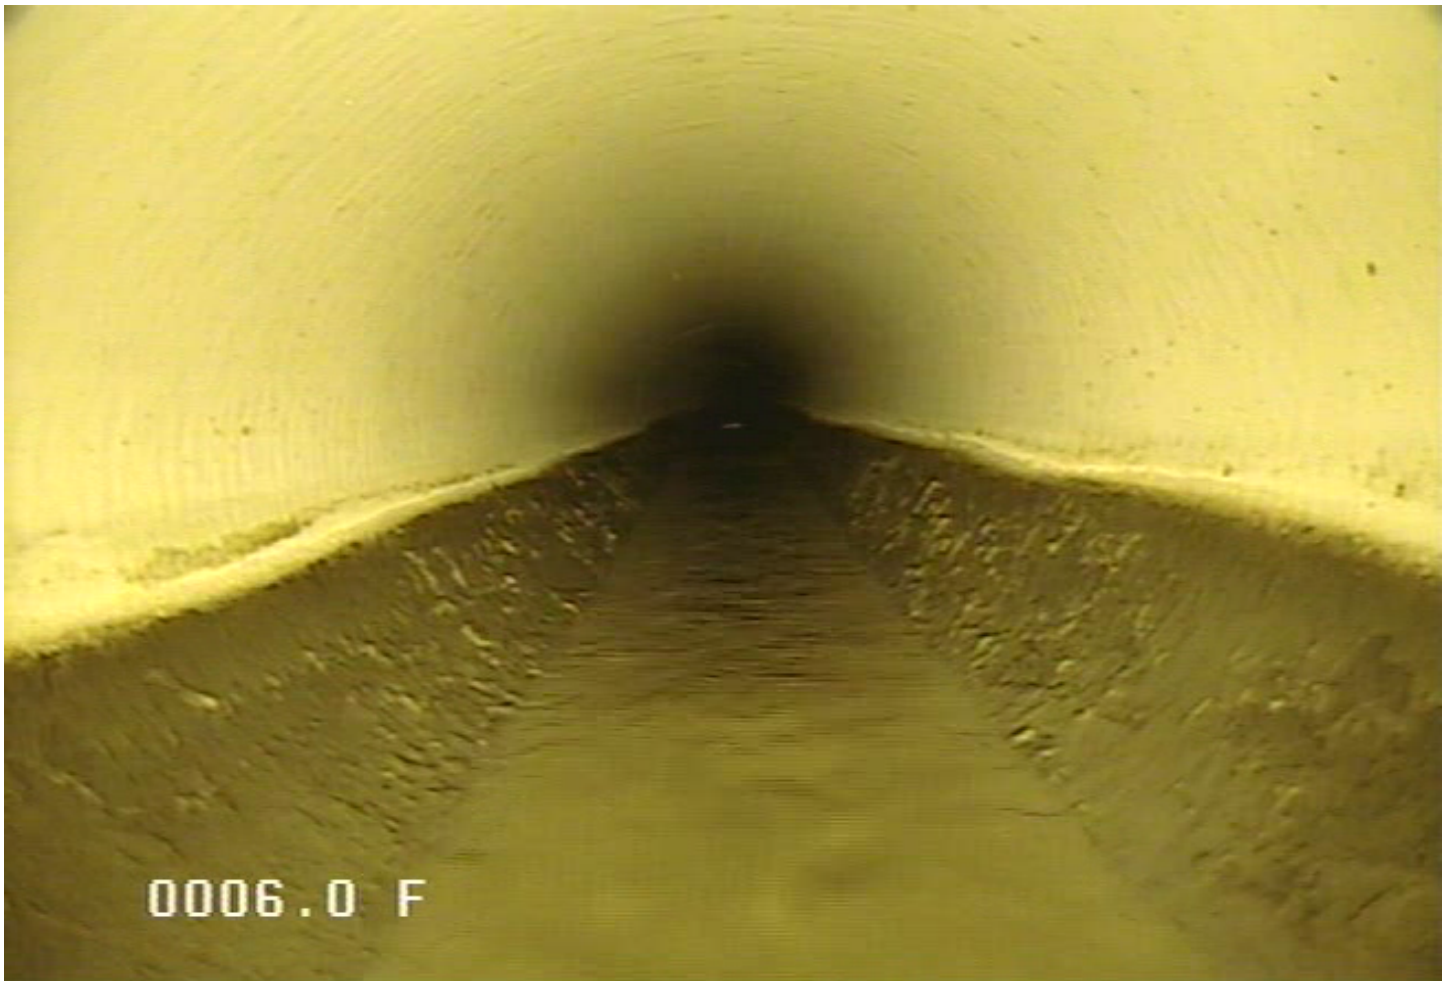

IB - Begin Inspection @ 6.0 ft.




248 Railroad Drive
Elk River, MN 55330
Phone: 763-635-1170

Owner	Pipe Number	Upstream MH	Downstream MH	Date			
City of Elk River	P481	0548	0549	09-Jun-2021			
Surveyor	Street	City	Time				
Andy	York/Medowvale	Elk River	10:38 AM				
Size	Material	Sewer Use	Purpose	Length	(TV'd)	Pre-Clean	Weather
8	PVC	Sanitary	Maintenance Related	212.381 7	419.1	Jetting	Dry

Comments

Medowvale inspection for replacement 6/9/21 #3

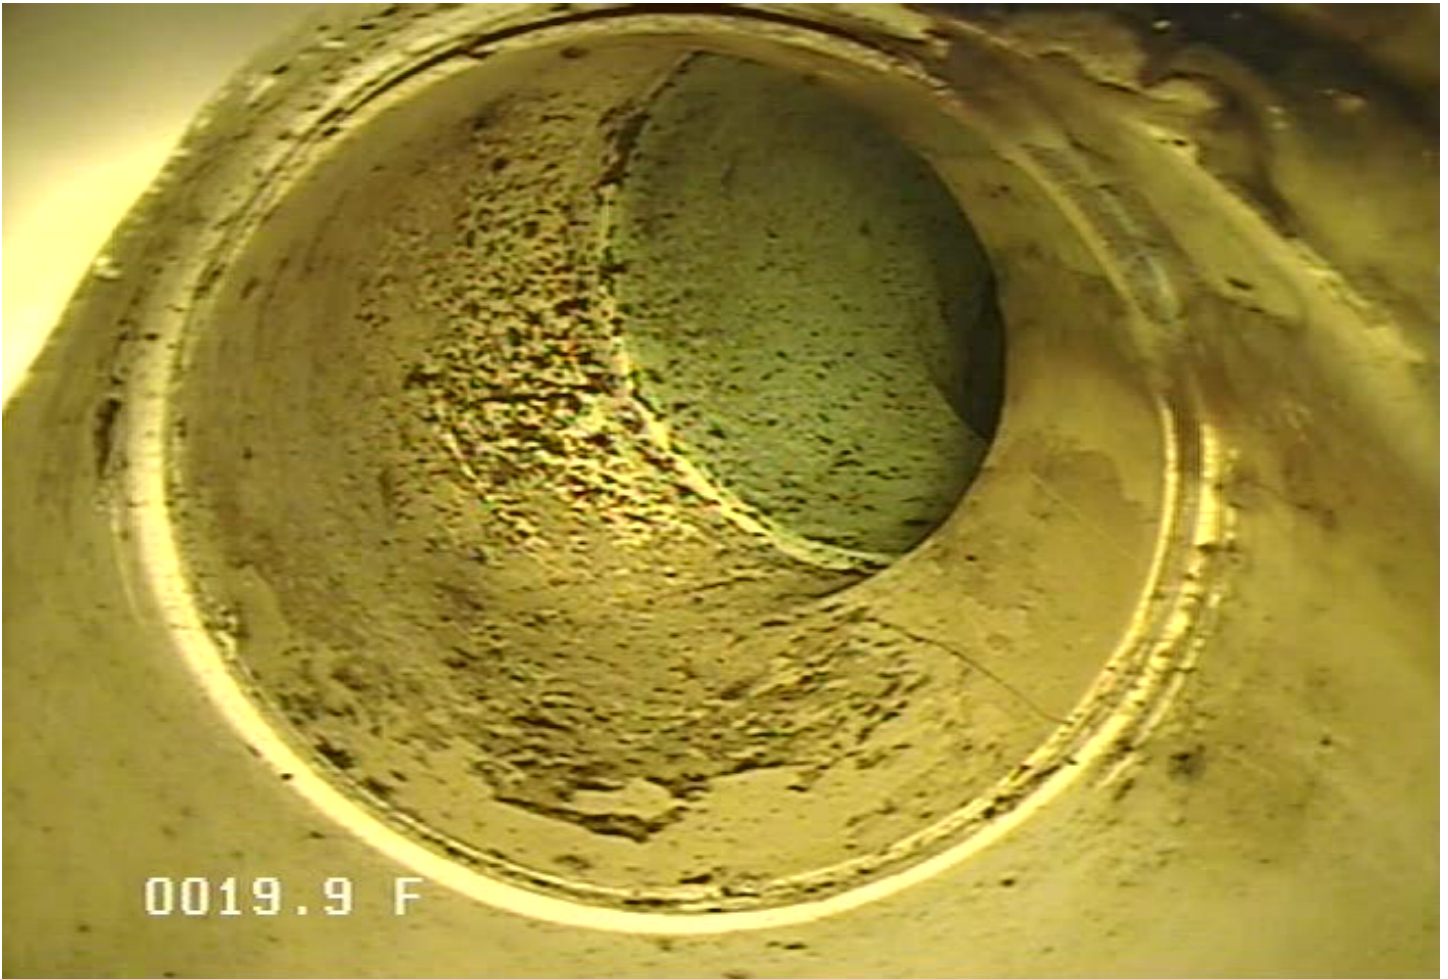

SC - Service Connection @ 19.9 ft.



248 Railroad Drive
Elk River, MN 55330
Phone: 763-635-1170

Owner	Pipe Number	Upstream MH	Downstream MH	Date			
City of Elk River	P481	0548	0549	09-Jun-2021			
Surveyor	Street	City	Time				
Andy	York/Medowvale	Elk River	10:38 AM				
Size	Material	Sewer Use	Purpose	Length	(TV'd)	Pre-Clean	Weather
8	PVC	Sanitary	Maintenance Related	212.381 7	419.1	Jetting	Dry

Comments

Medowvale inspection for replacement 6/9/21 #3



SC - Service Connection @ 86.1 ft.



248 Railroad Drive
Elk River, MN 55330
Phone: 763-635-1170

Owner	Pipe Number	Upstream MH	Downstream MH	Date
City of Elk River	P481	0548	0549	09-Jun-2021
Surveyor	Street			City
Andy	York/Medowvale			Elk River
Time	Size	Material	Sewer Use	Purpose
10:38 AM	8	PVC	Sanitary	Maintenance Related
				Length
				212.381
				7
				(TV'd)
				419.1
				Pre-Clean
				Jetting
				Weather
				Dry

Comments

Medowvale inspection for replacement 6/9/21 #3



SC - Service Connection @ 96.3 ft.




248 Railroad Drive
Elk River, MN 55330
Phone: 763-635-1170

Owner	Pipe Number	Upstream MH	Downstream MH	Date
City of Elk River	P481	0548	0549	09-Jun-2021
Surveyor	Street			City
Andy	York/Medowvale			Elk River
Time	Size	Material	Sewer Use	Purpose
10:38 AM	8	PVC	Sanitary	Maintenance Related
Length	(TV'd)	Pre-Clean	Weather	
212.381 7	419.1	Jetting	Dry	

Comments

Medowvale inspection for replacement 6/9/21 #3

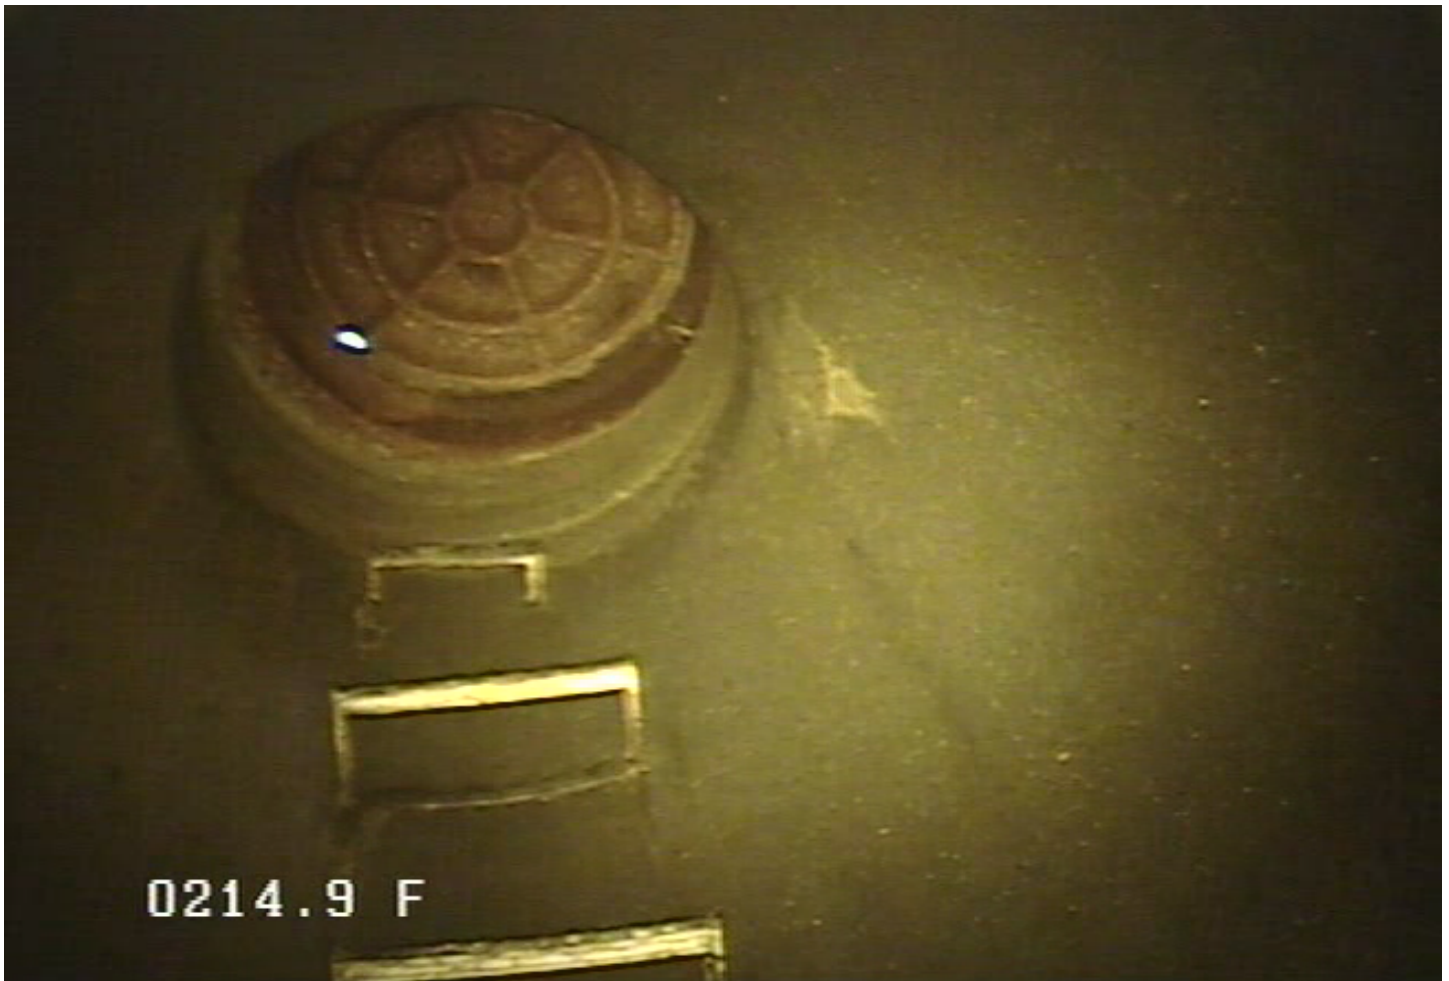

MH - Manhole @ 214.9 ft.



248 Railroad Drive
Elk River, MN 55330
Phone: 763-635-1170

Owner	Pipe Number	Upstream MH	Downstream MH	Date			
City of Elk River	P481	0548	0549	09-Jun-2021			
Surveyor	Street	City	Time				
Andy	York/Medowvale	Elk River	10:38 AM				
Size	Material	Sewer Use	Purpose	Length	(TV'd)	Pre-Clean	Weather
8	PVC	Sanitary	Maintenance Related	212.381 7	419.1	Jetting	Dry

Comments

Medowvale inspection for replacement 6/9/21 #3



SC - Service Connection @ 408.3 ft.




248 Railroad Drive
Elk River, MN 55330
Phone: 763-635-1170

Owner	Pipe Number	Upstream MH	Downstream MH	Date			
City of Elk River	P481	0548	0549	09-Jun-2021			
Surveyor	Street	City	Time				
Andy	York/Medowvale	Elk River	10:38 AM				
Size	Material	Sewer Use	Purpose	Length	(TV'd)	Pre-Clean	Weather
8	PVC	Sanitary	Maintenance Related	212.381 7	419.1	Jetting	Dry

Comments

Medowvale inspection for replacement 6/9/21 #3

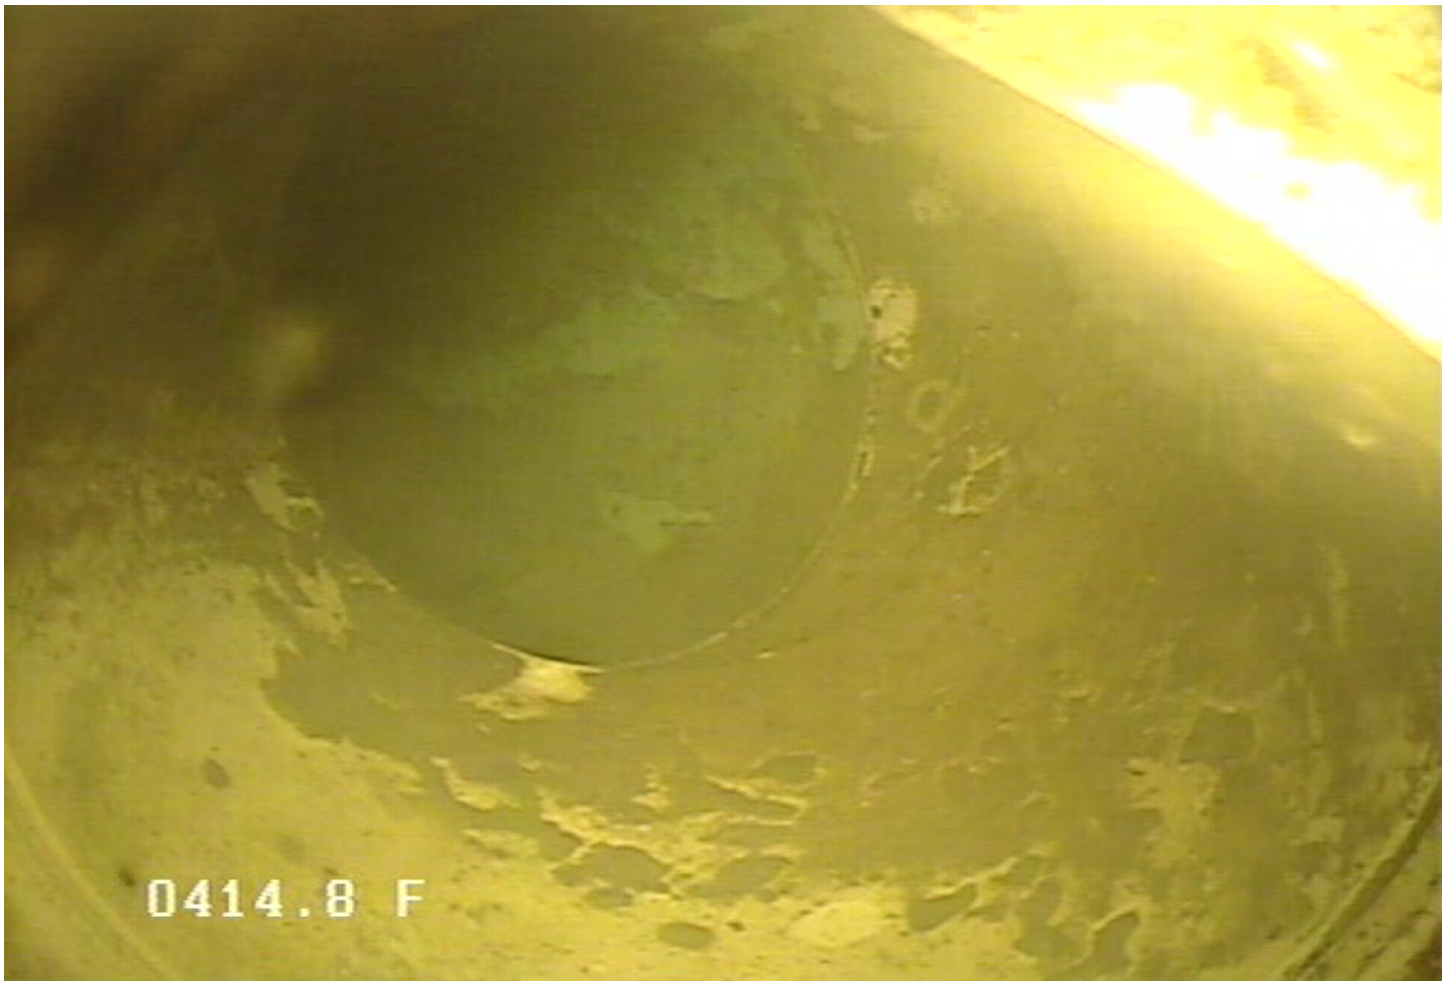

SC - Service Connection @ 414.8 ft.




248 Railroad Drive
Elk River, MN 55330
Phone: 763-635-1170

Owner	Pipe Number	Upstream MH	Downstream MH	Date			
City of Elk River	P481	0548	0549	09-Jun-2021			
Surveyor	Street	City	Time				
Andy	York/Medowvale	Elk River	10:38 AM				
Size	Material	Sewer Use	Purpose	Length	(TV'd)	Pre-Clean	Weather
8	PVC	Sanitary	Maintenance Related	212.381 7	419.1	Jetting	Dry

Comments

Medowvale inspection for replacement 6/9/21 #3

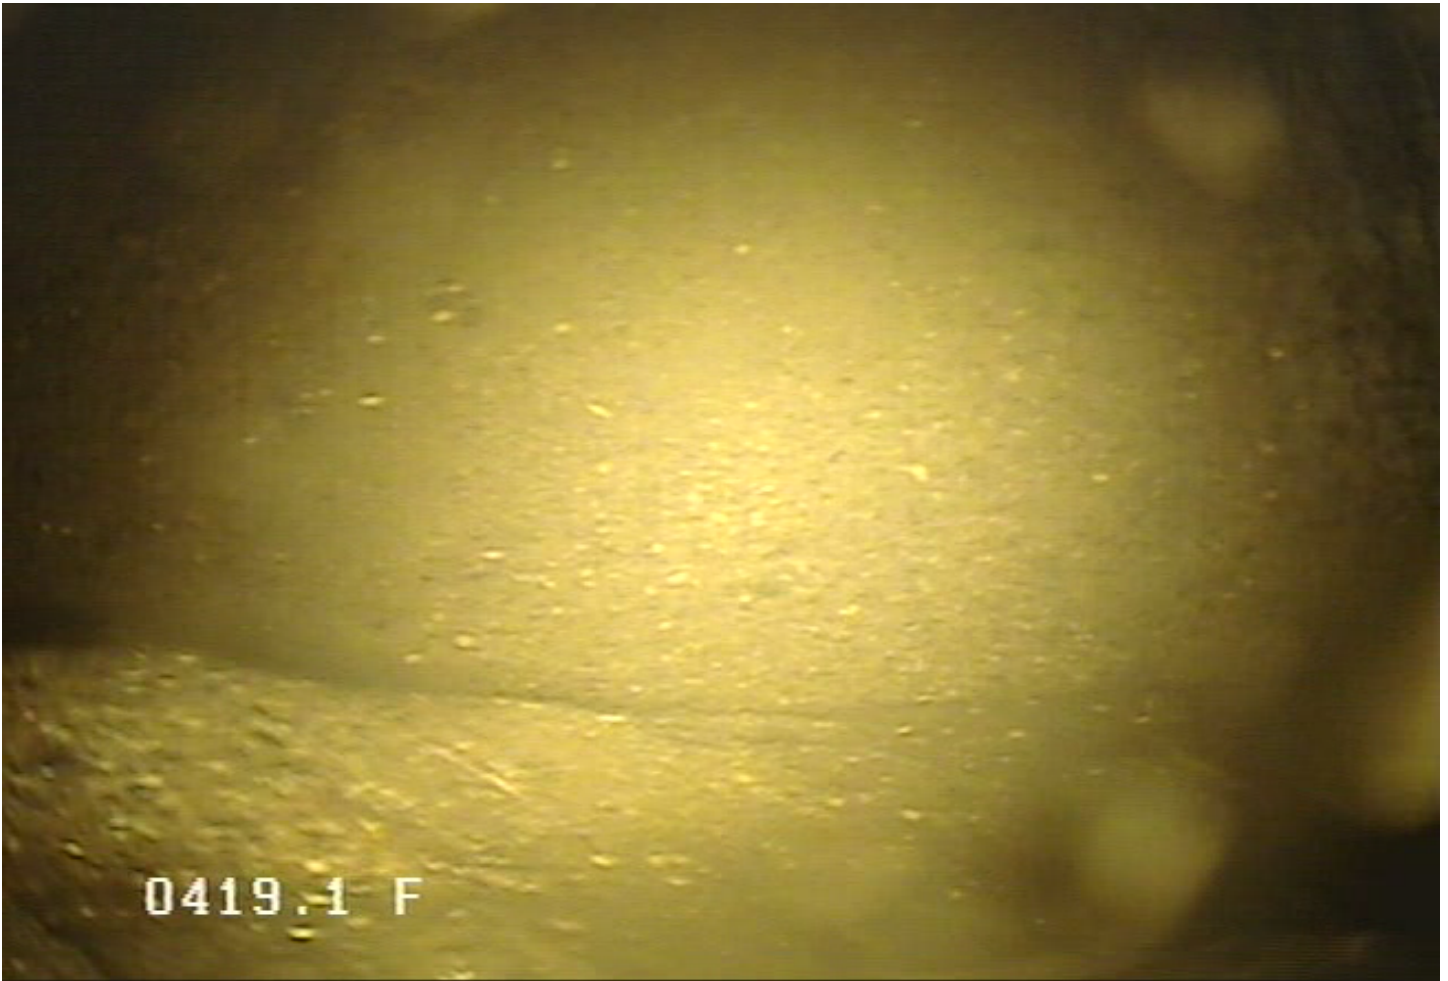

MH - Manhole @ 419.1 ft.



248 Railroad Drive
Elk River, MN 55330
Phone: 763-635-1170

Owner City of Elk River	Pipe Number P481	Upstream MH 0548	Downstream MH 0549	Date 09-Jun-2021
Surveyor Andy	Street York/Medowvale		City Elk River	Time 10:38 AM
Size 8	Material PVC	Sewer Use Sanitary	Purpose Maintenance Related	Length 212.381 7
			(TV'd) 419.1	Pre-Clean Jetting
				Weather Dry

Comments

Medowvale inspection for replacement 6/9/21 #3

