




248 Railroad Drive
Elk River, MN 55330
Phone: 763-635-1170

Owner City of Elk River	Pipe Number P51	Upstream MH 86	Downstream MH 85	Date 07-Aug-2013
Surveyor chris c	Street lions park drive		City Elk River	Time 9:06 AM
Size 8	Material PVC	Sewer Use Sanitary	Purpose Maintenance Related	Length 285.013 3
			(TV'd) 277.7	Pre-Clean Jetting
				Weather Dry

Comments

check for heavy grit and roots

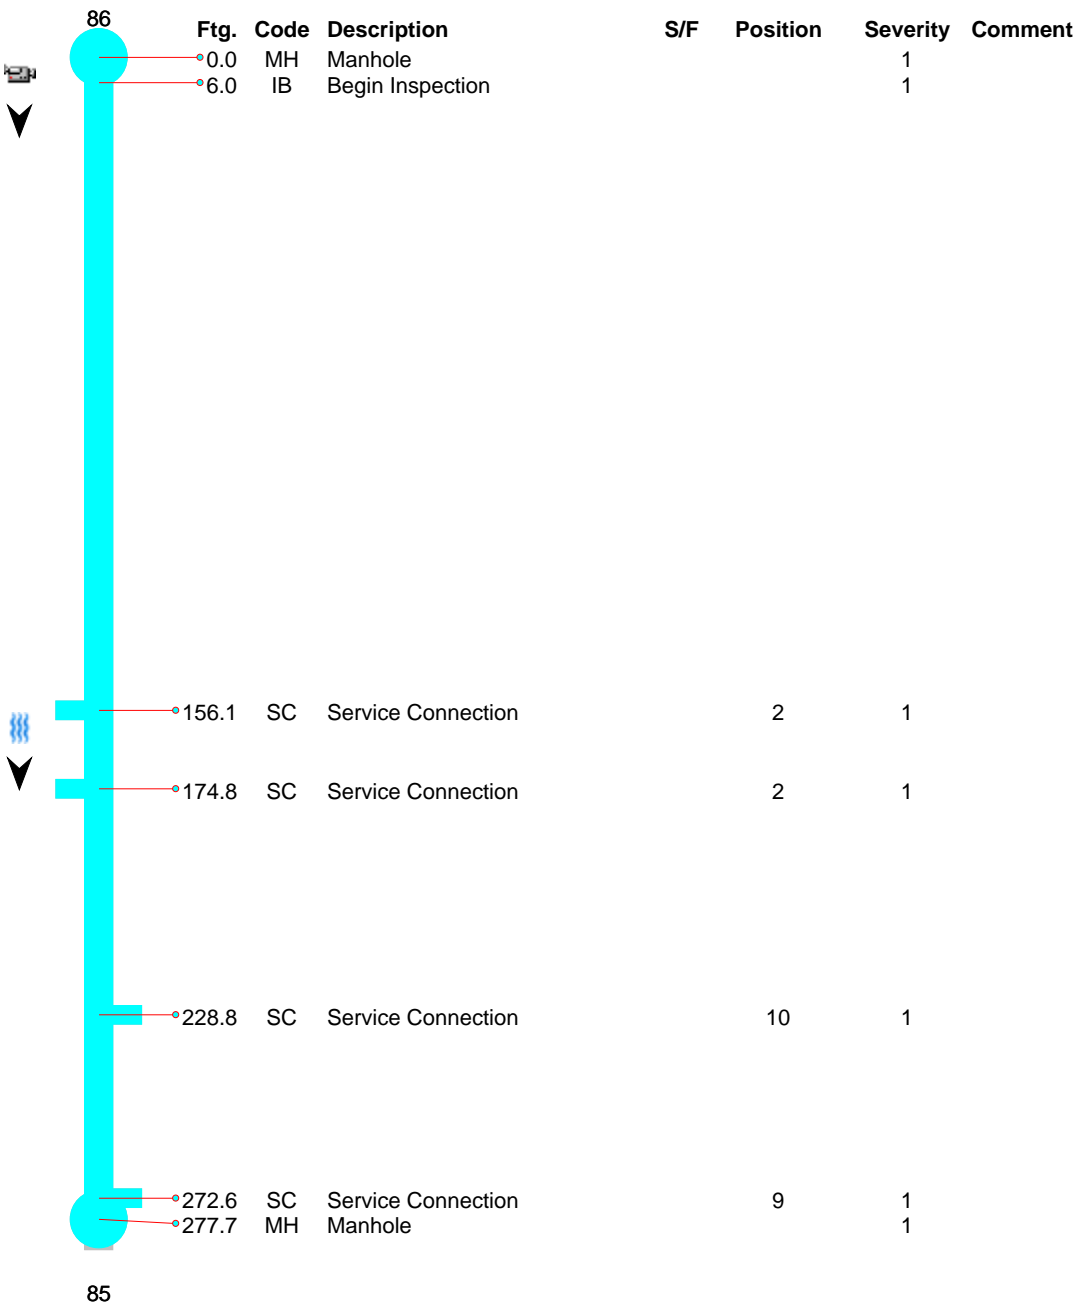



248 Railroad Drive
Elk River, MN 55330
Phone: 763-635-1170

Owner City of Elk River	Pipe Number P51	Upstream MH 86	Downstream MH 85	Date 07-Aug-2013			
Surveyor chris c	Street lions park drive		City Elk River	Time 9:06 AM			
Size 8	Material PVC	Sewer Use Sanitary	Purpose Maintenance Related	Length 285.013 3	(TV'd) 277.7	Pre-Clean Jetting	Weather Dry

Comments

check for heavy grit and roots



MH - Manhole @ 0.0 ft.



248 Railroad Drive
Elk River, MN 55330
Phone: 763-635-1170

Owner	Pipe Number	Upstream MH	Downstream MH	Date			
City of Elk River	P51	86	85	07-Aug-2013			
Surveyor	Street			Time			
chris c	lions park drive			9:06 AM			
City							
Elk River							
Size	Material	Sewer Use	Purpose	Length	(TV'd)	Pre-Clean	Weather
8	PVC	Sanitary	Maintenance Related	285.013 3	277.7	Jetting	Dry

Comments

check for heavy grit and roots



IB - Begin Inspection @ 6.0 ft.




248 Railroad Drive
Elk River, MN 55330
Phone: 763-635-1170

Owner	Pipe Number	Upstream MH	Downstream MH	Date			
City of Elk River	P51	86	85	07-Aug-2013			
Surveyor	Street		City	Time			
chris c	lions park drive		Elk River	9:06 AM			
Size	Material	Sewer Use	Purpose	Length	(TV'd)	Pre-Clean	Weather
8	PVC	Sanitary	Maintenance Related	285.013 3	277.7	Jetting	Dry

Comments

check for heavy grit and roots

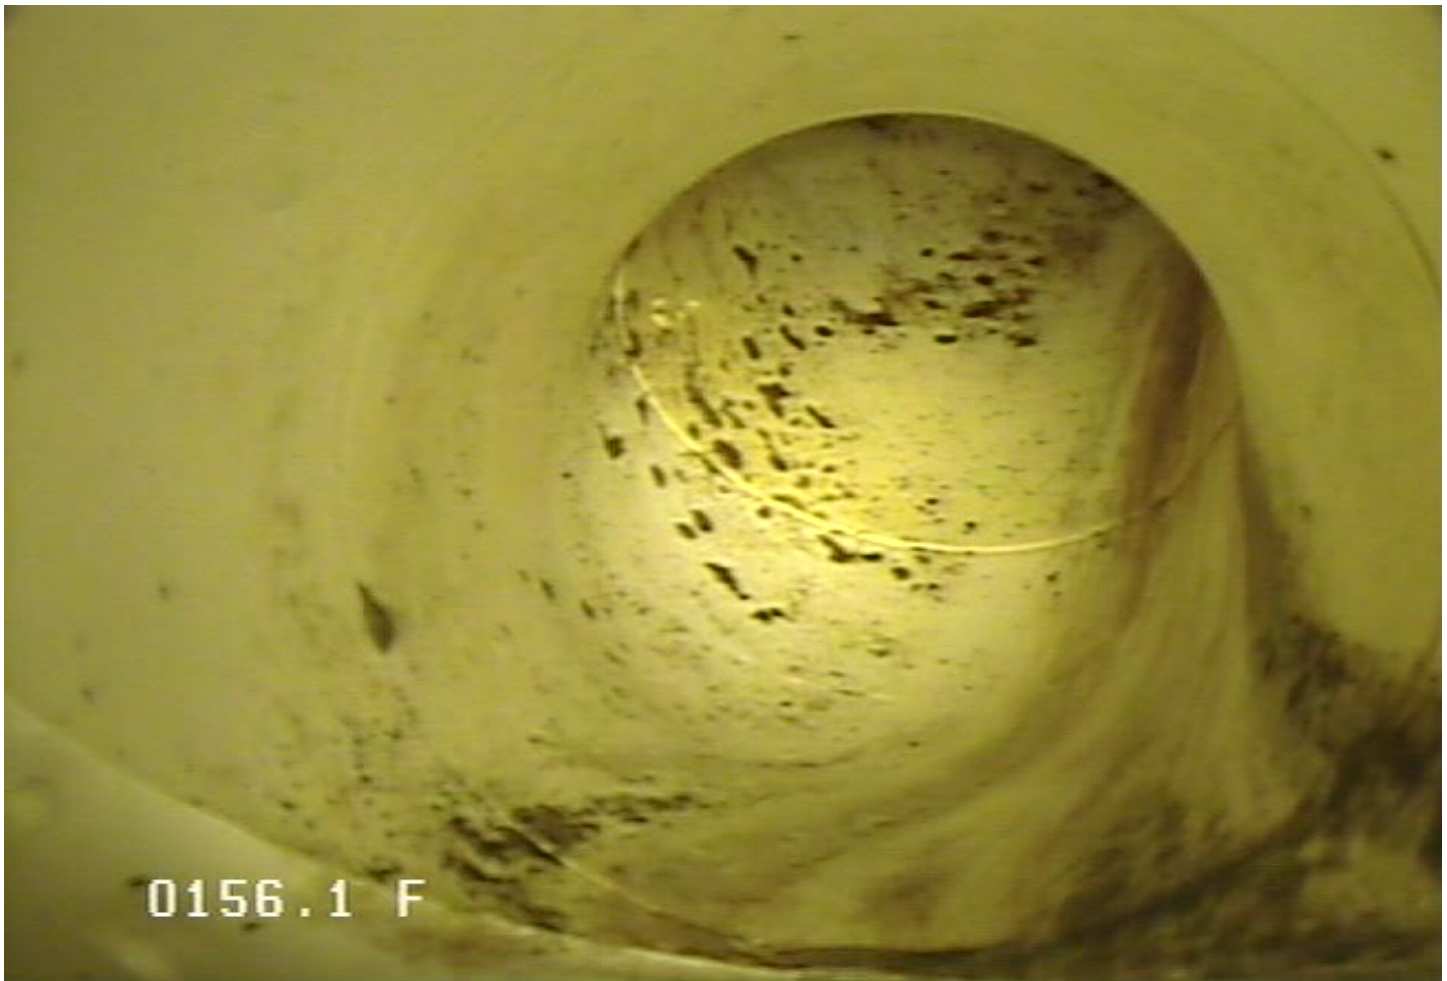

SC - Service Connection @ 156.1 ft.



248 Railroad Drive
Elk River, MN 55330
Phone: 763-635-1170

Owner	Pipe Number	Upstream MH	Downstream MH	Date			
City of Elk River	P51	86	85	07-Aug-2013			
Surveyor	Street		City	Time			
chris c	lions park drive		Elk River	9:06 AM			
Size	Material	Sewer Use	Purpose	Length	(TV'd)	Pre-Clean	Weather
8	PVC	Sanitary	Maintenance Related	285.013 3	277.7	Jetting	Dry

Comments

check for heavy grit and roots



SC - Service Connection @ 174.8 ft.



248 Railroad Drive
Elk River, MN 55330
Phone: 763-635-1170

Owner	Pipe Number	Upstream MH	Downstream MH	Date			
City of Elk River	P51	86	85	07-Aug-2013			
Surveyor	Street	City	Time				
chris c	lions park drive	Elk River	9:06 AM				
Size	Material	Sewer Use	Purpose	Length	(TV'd)	Pre-Clean	Weather
8	PVC	Sanitary	Maintenance Related	285.013 3	277.7	Jetting	Dry

Comments

check for heavy grit and roots



SC - Service Connection @ 228.8 ft.




248 Railroad Drive
Elk River, MN 55330
Phone: 763-635-1170

Owner	Pipe Number	Upstream MH	Downstream MH	Date			
City of Elk River	P51	86	85	07-Aug-2013			
Surveyor	Street		City	Time			
chris c	lions park drive		Elk River	9:06 AM			
Size	Material	Sewer Use	Purpose	Length	(TV'd)	Pre-Clean	Weather
8	PVC	Sanitary	Maintenance Related	285.013 3	277.7	Jetting	Dry

Comments

check for heavy grit and roots

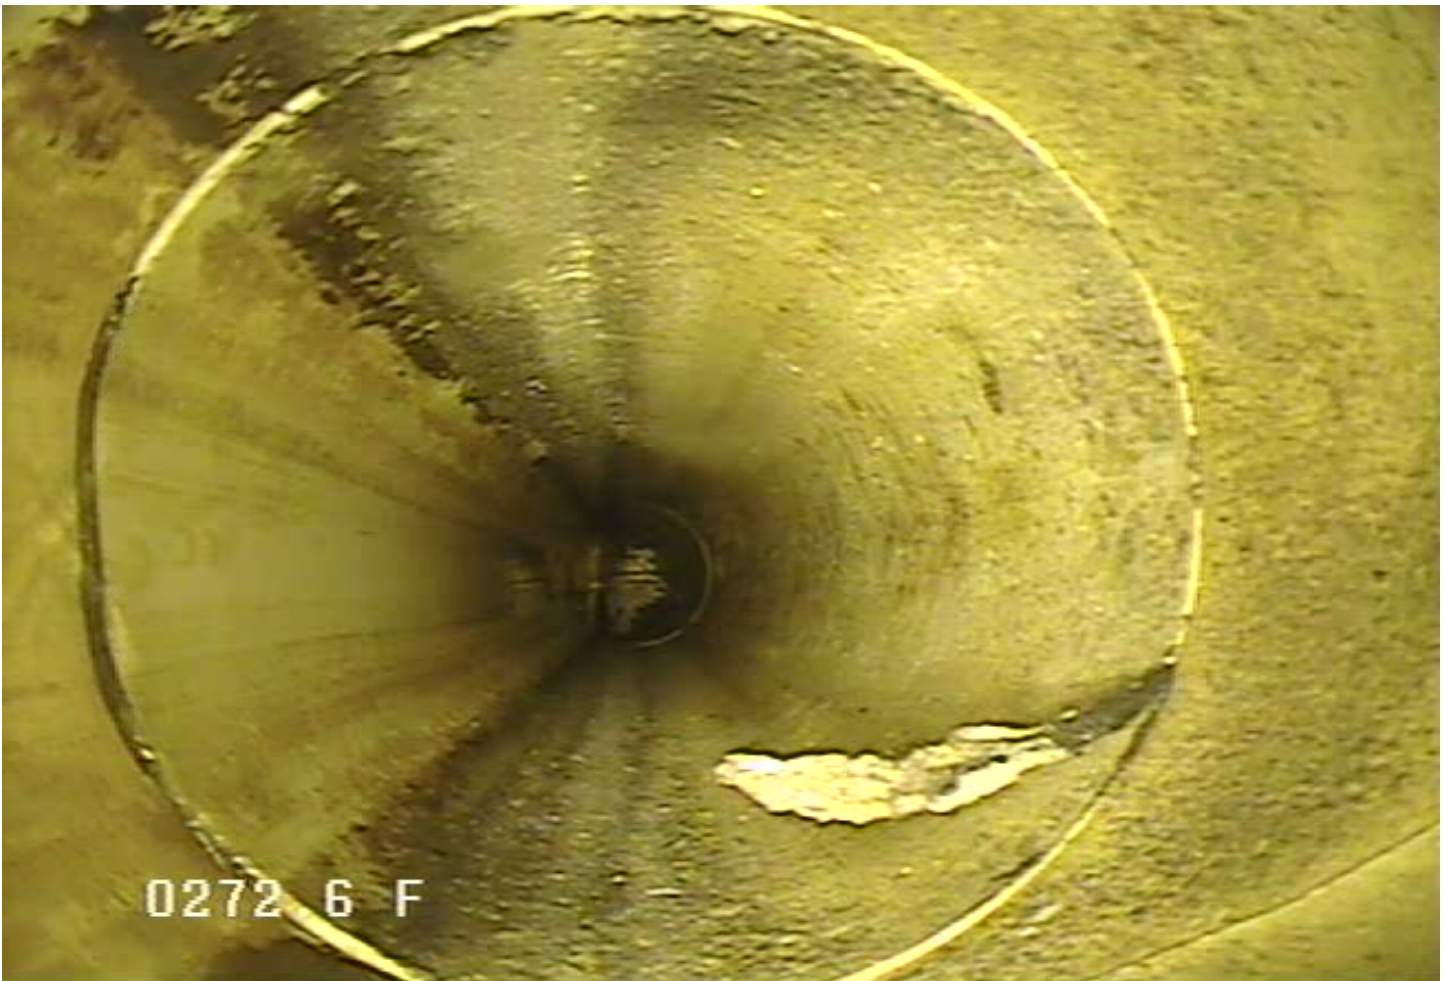

SC - Service Connection @ 272.6 ft.



248 Railroad Drive
Elk River, MN 55330
Phone: 763-635-1170

Owner	Pipe Number	Upstream MH	Downstream MH	Date			
City of Elk River	P51	86	85	07-Aug-2013			
Surveyor	Street	City	Time				
chris c	lions park drive	Elk River	9:06 AM				
Size	Material	Sewer Use	Purpose	Length	(TV'd)	Pre-Clean	Weather
8	PVC	Sanitary	Maintenance Related	285.013 3	277.7	Jetting	Dry

Comments

check for heavy grit and roots



MH - Manhole @ 277.7 ft.



248 Railroad Drive
Elk River, MN 55330
Phone: 763-635-1170

Owner City of Elk River	Pipe Number P51	Upstream MH 86	Downstream MH 85	Date 07-Aug-2013			
Surveyor chris c	Street lions park drive		City Elk River	Time 9:06 AM			
Size 8	Material PVC	Sewer Use Sanitary	Purpose Maintenance Related	Length 285.013 3	(TV'd) 277.7	Pre-Clean Jetting	Weather Dry

Comments

check for heavy grit and roots

