


FOURTH STREET




0 20
0 5
VERT.

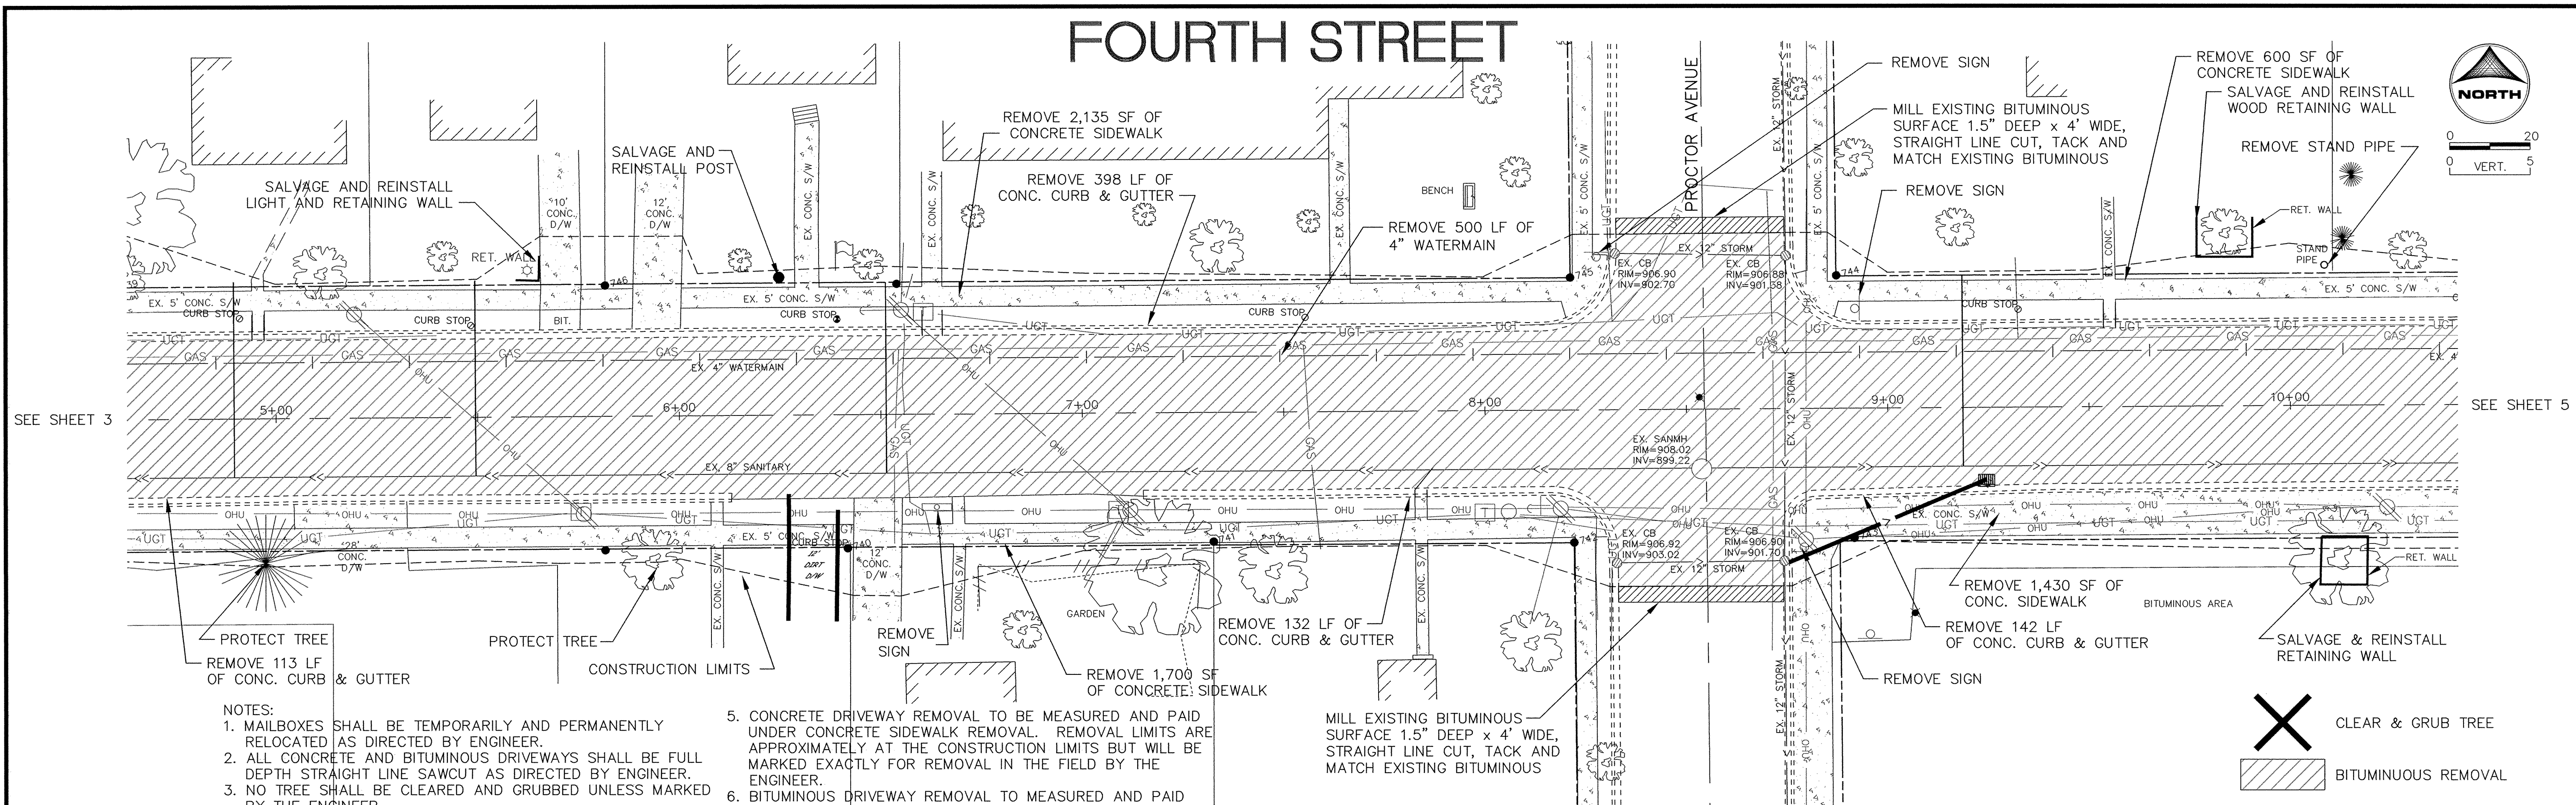

- NOTES:
1. MAILBOXES SHALL BE TEMPORARILY AND PERMANENTLY RELOCATED AS DIRECTED BY ENGINEER.
 2. ALL CONCRETE AND BITUMINOUS DRIVEWAYS SHALL BE FULL DEPTH STRAIGHT LINE SAWCUT AS DIRECTED BY ENGINEER.
 3. NO TREE SHALL BE CLEARED AND GRUBBED UNLESS MARKED BY THE ENGINEER.
 4. ALL PRIVATE UTILITY RELOCATION TO BE COORDINATED BETWEEN THE CONTRACTOR AND UTILITY COMPANY.
 5. CONCRETE DRIVEWAY REMOVAL TO BE MEASURED AND PAID UNDER CONCRETE SIDEWALK REMOVAL. REMOVAL LIMITS ARE APPROXIMATELY AT THE CONSTRUCTION LIMITS BUT WILL BE MARKED EXACTLY FOR REMOVAL IN THE FIELD BY THE ENGINEER.
 6. BITUMINOUS DRIVEWAY REMOVAL TO MEASURED AND PAID UNDER BITUMINOUS REMOVAL. REMOVAL LIMITS ARE APPROXIMATELY AT THE CONSTRUCTION LIMITS BUT WILL BE MARKED EXACTLY FOR REMOVAL IN THE FIELD BY THE ENGINEER.

WEST OF PROCTOR:
TOTAL BIT. REMOVAL (4TH ST.) = 3,848.7 SY
TOTAL CONC. S/W REMOVAL (4TH ST.) = 10,562 SF

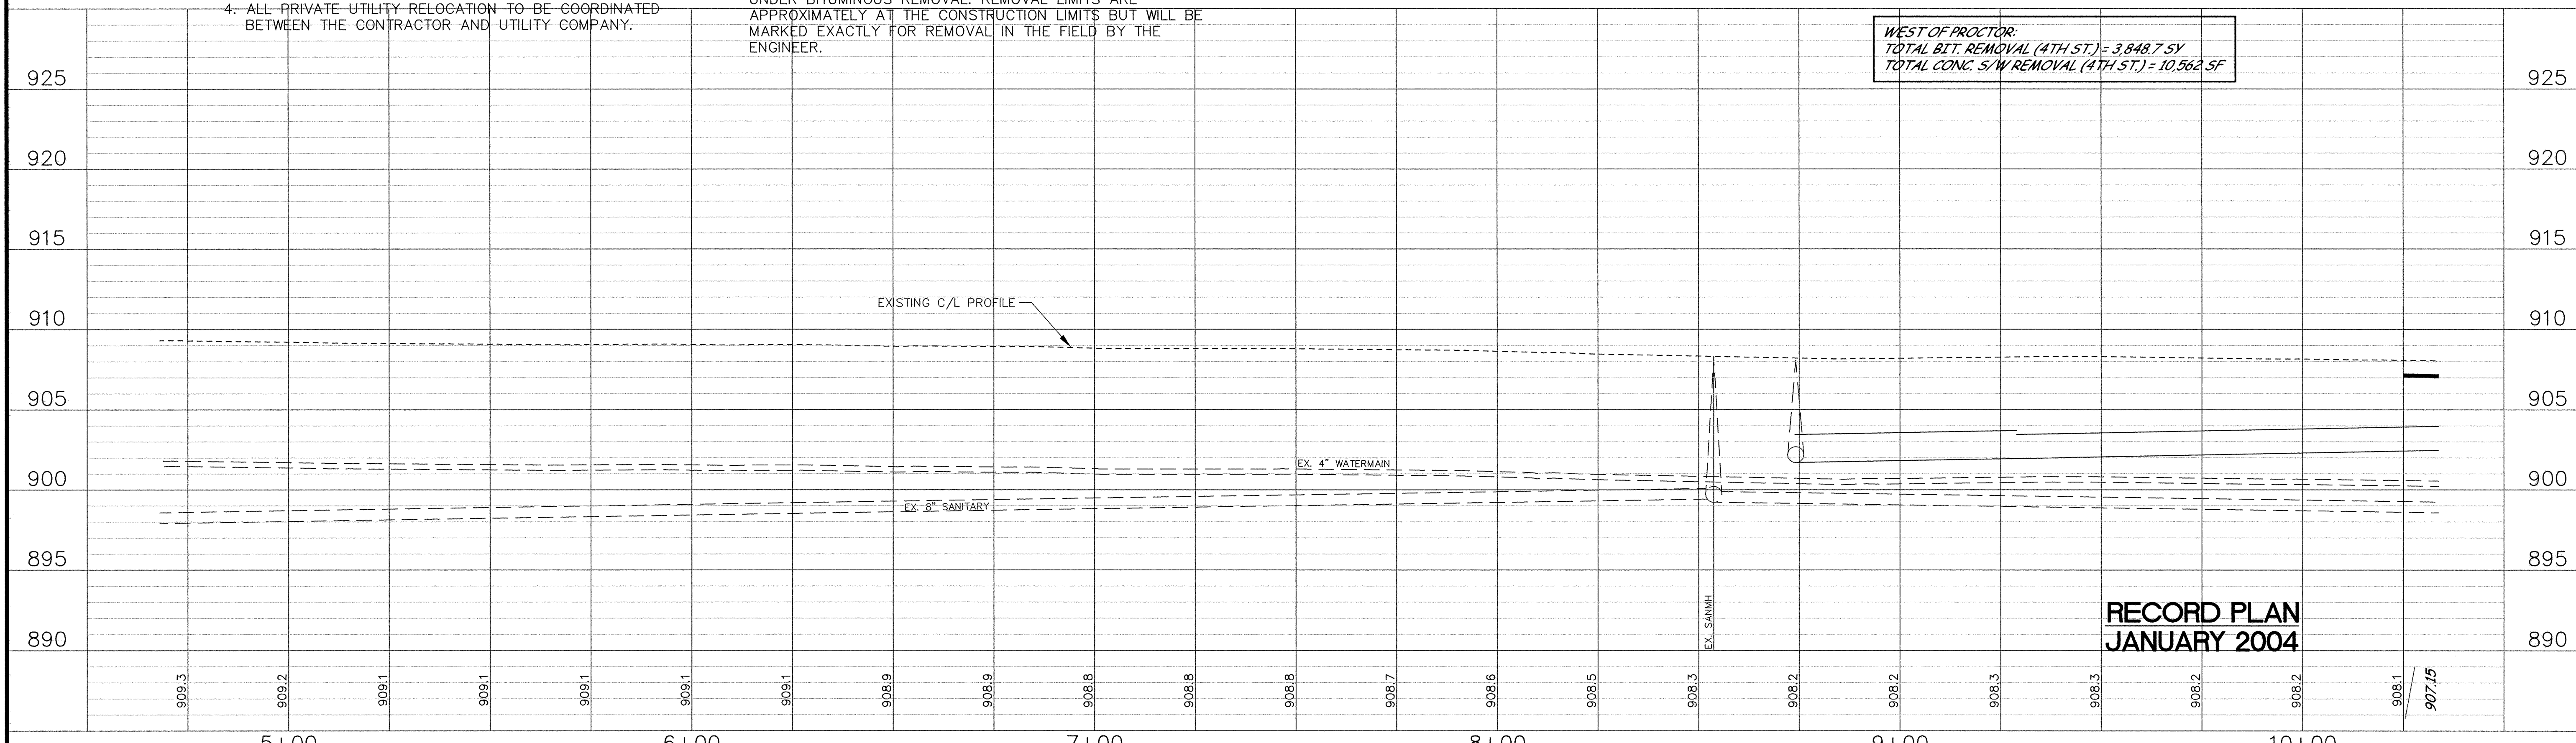

**RECORD PLAN
JANUARY 2004**

DESIGNED BY: ME DRAWN BY: RKM
APPROVED BY: KJT JOB NUMBER 818980J
CAD DATE: February 11, 2004 11:59:22 a.m.
CAD FILE: 818980J\As-built\C\CS-E02.DWG (RMONJEA)

I HEREBY CERTIFY THAT THIS PLAN, SPECIFICATION, OR REPORT WAS PREPARED BY ME OR UNDER MY DIRECT SUPERVISION AND THAT I AM A DULY LICENSED PROFESSIONAL ENGINEER UNDER THE LAWS OF THE STATE OF MINNESOTA.
SIGNATURE: *Kristina J. Thompson* DATE: 4/21/04
PRINTED NAME: KRISTINA J. THOMPSON LIC. NO. 42350

| NO. | DATE | BY | REVISION DESCRIPTION |
|-----|------|----|----------------------|
| | | | |
| | | | |
| | | | |

1326 ENERGY PARK DRIVE
ST. PAUL, MINNESOTA 55108
(651) 644-4389
Howard R. Green Company

**2003 STREET IMPROVEMENTS
CITY OF ELK RIVER**

EXISTING TOPOGRAPHY AND REMOVALS
FOURTH STREET
5+00 TO 10+00

SHEET NO.
4

DRAWING NUMBER 03IMPR 04
SARGO PRODUCTS • NEW HOPE, MINNESOTA
REORDER BY PART NUMBER 8532
PRINTED DATE: 02/11/04 11:59:22 AM