



NORFOLK AVENUE

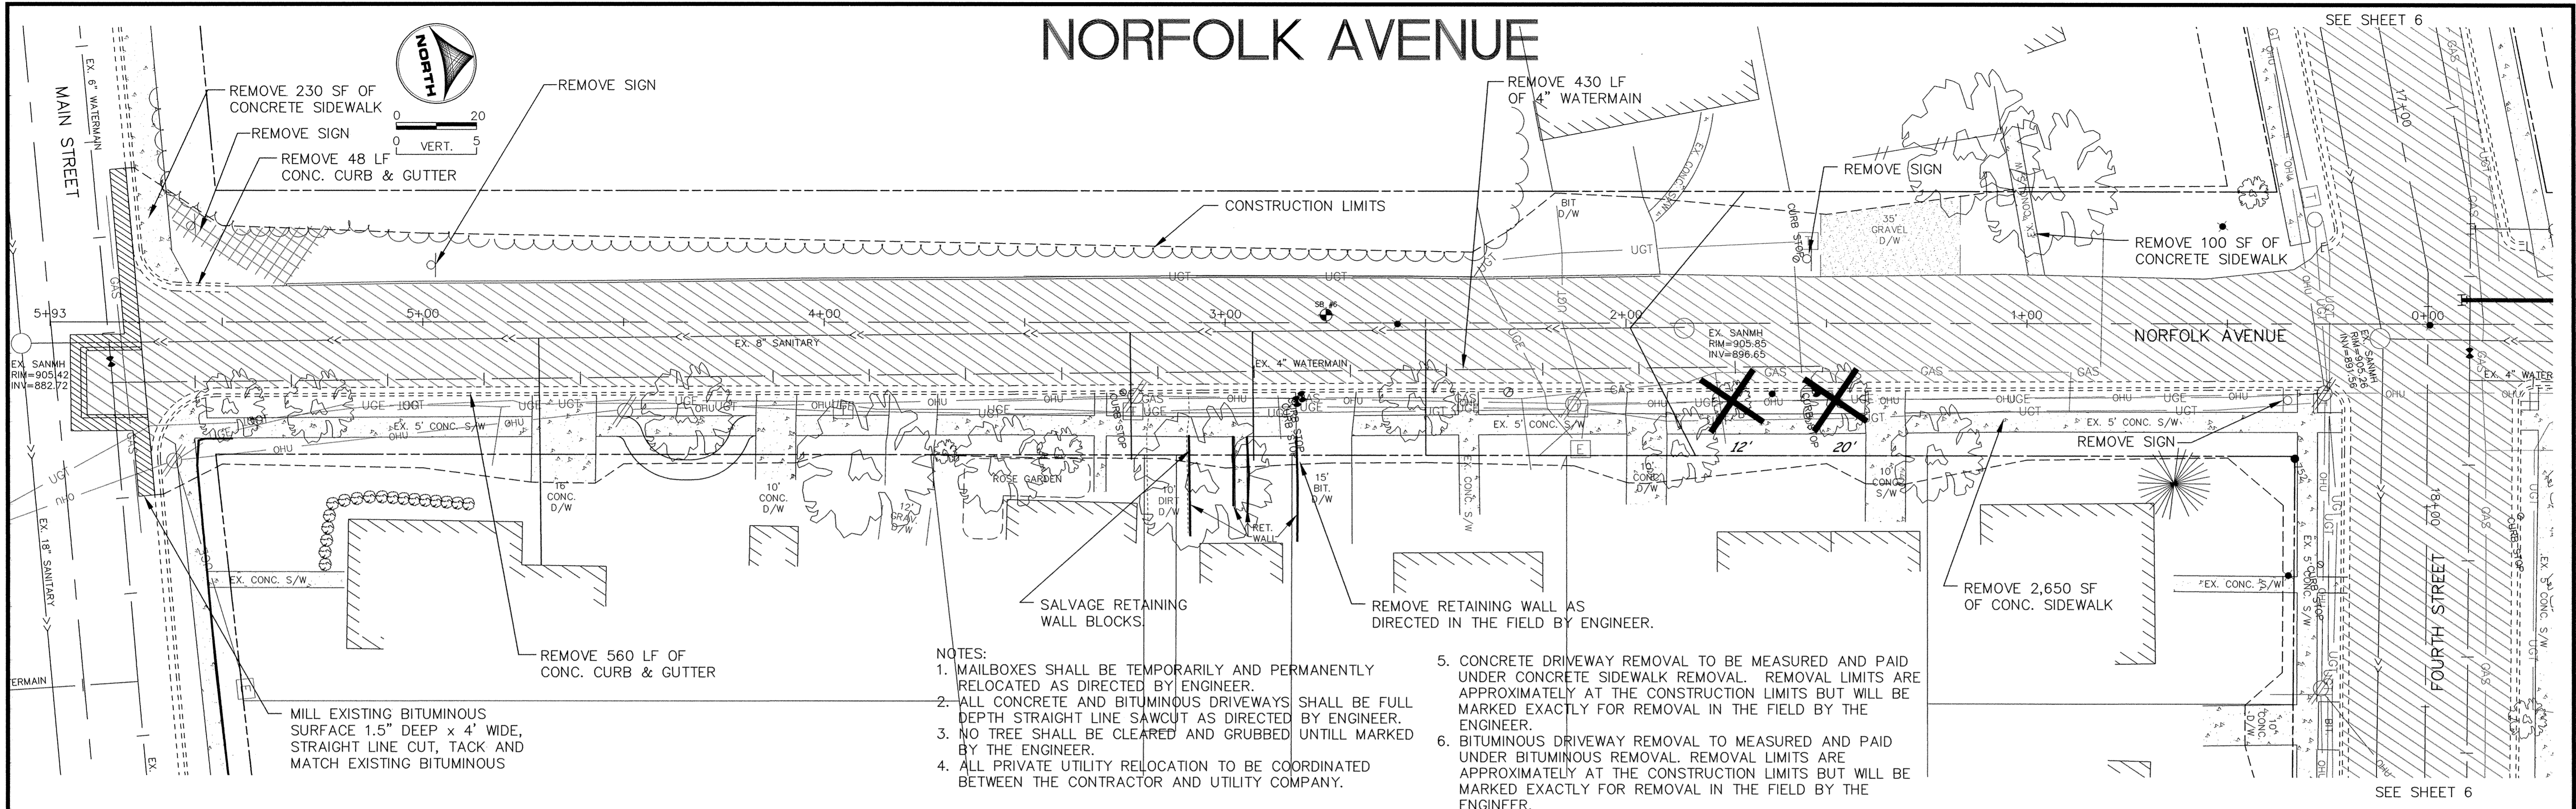

- NOTES:
1. MAILBOXES SHALL BE TEMPORARILY AND PERMANENTLY RELOCATED AS DIRECTED BY ENGINEER.
 2. ALL CONCRETE AND BITUMINOUS DRIVEWAYS SHALL BE FULL DEPTH STRAIGHT LINE SAWCUT AS DIRECTED BY ENGINEER.
 3. NO TREE SHALL BE CLEARED AND GRUBBED UNTILL MARKED BY THE ENGINEER.
 4. ALL PRIVATE UTILITY RELOCATION TO BE COORDINATED BETWEEN THE CONTRACTOR AND UTILITY COMPANY.
 5. CONCRETE DRIVEWAY REMOVAL TO BE MEASURED AND PAID UNDER CONCRETE SIDEWALK REMOVAL. REMOVAL LIMITS ARE APPROXIMATELY AT THE CONSTRUCTION LIMITS BUT WILL BE MARKED EXACTLY FOR REMOVAL IN THE FIELD BY THE ENGINEER.
 6. BITUMINOUS DRIVEWAY REMOVAL TO MEASURED AND PAID UNDER BITUMINOUS REMOVAL. REMOVAL LIMITS ARE APPROXIMATELY AT THE CONSTRUCTION LIMITS BUT WILL BE MARKED EXACTLY FOR REMOVAL IN THE FIELD BY THE ENGINEER.

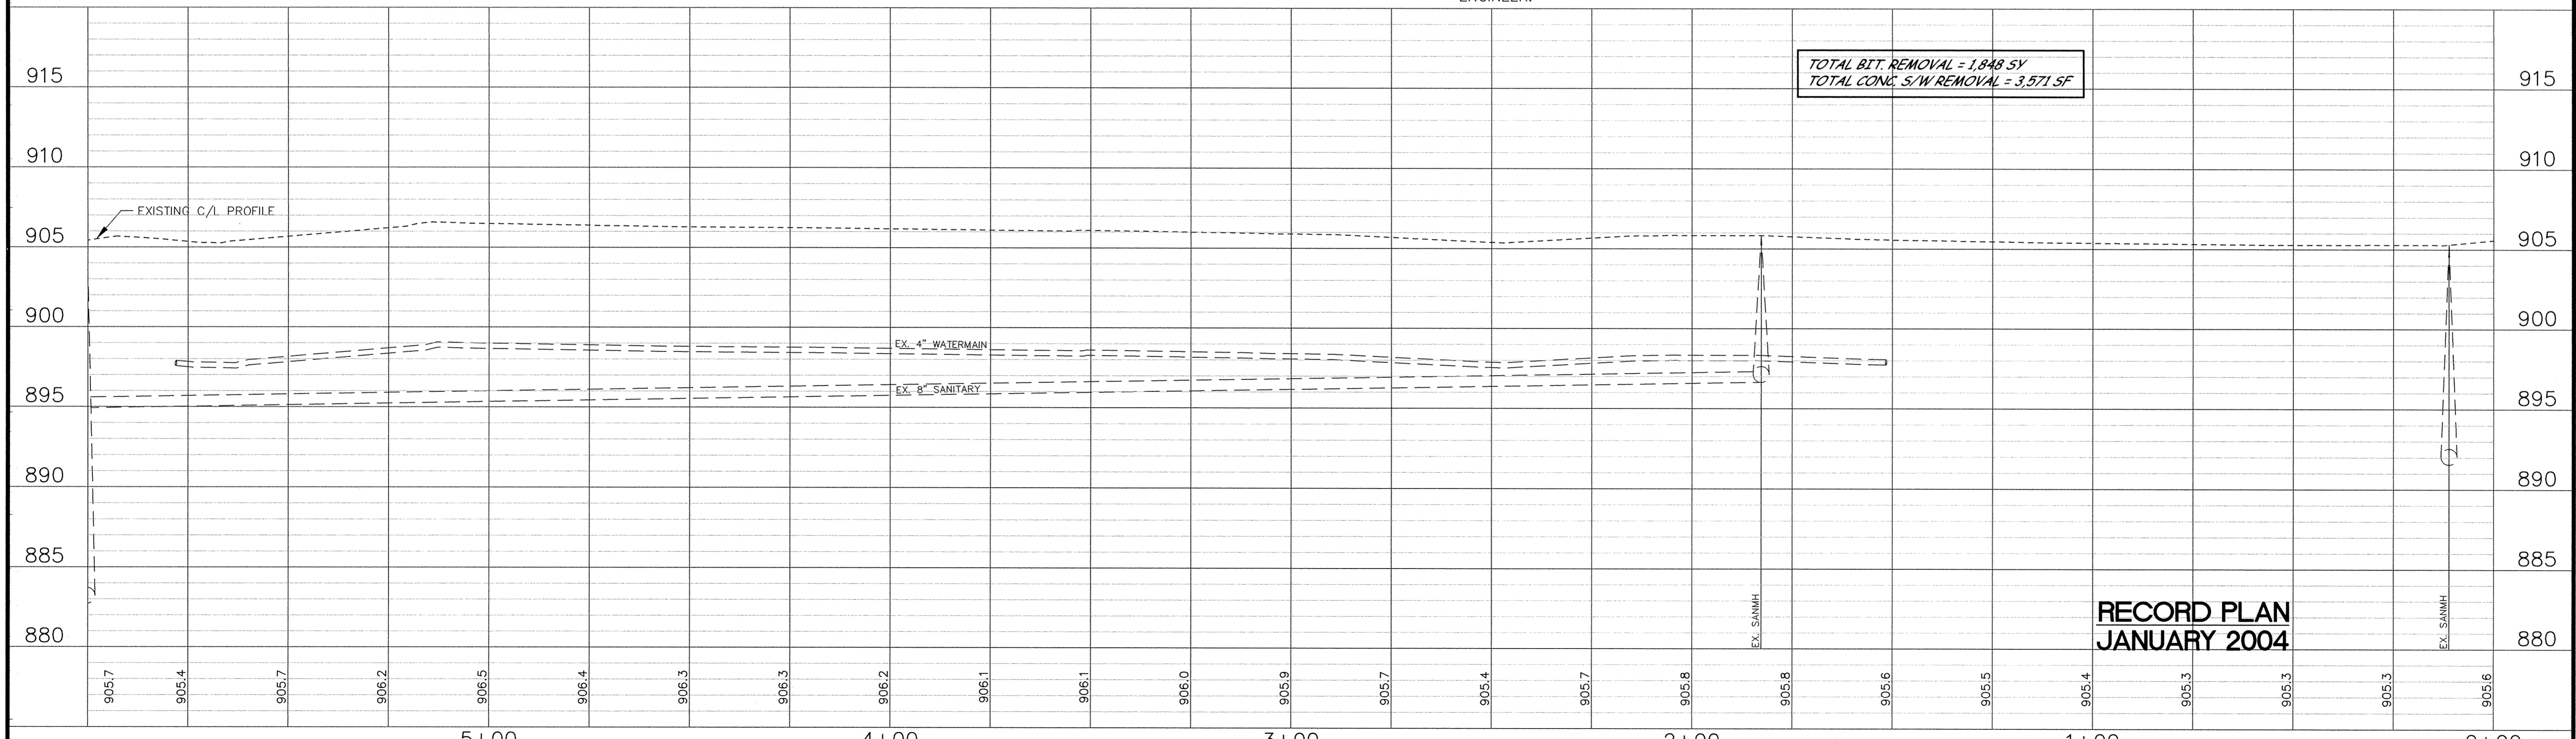

TOTAL BIT. REMOVAL = 1,848 SY
TOTAL CONC. S/W REMOVAL = 3,571 SF

**RECORD PLAN
JANUARY 2004**

DESIGNED BY: DESIGNED BY DRAWN BY: RKM
APPROVED BY: APPROVED BY JOB NUMBER 818980J
CAD DATE: February 11, 2004 1:15:14 p.m.
CAD FILE: 818980J\As-built\VC\CS-E09.DWG (RMONJEA)

I HEREBY CERTIFY THAT THIS PLAN, SPECIFICATION, OR REPORT WAS PREPARED BY ME OR UNDER MY DIRECT SUPERVISION AND THAT I AM A DULY LICENSED PROFESSIONAL ENGINEER UNDER THE LAWS OF THE STATE OF MINNESOTA.
SIGNATURE: *Kristina Thompson* DATE: 4/21/04
PRINTED NAME: KRISTINA J. THOMPSON LIC. NO. 42350

NO.	DATE	BY	REVISION DESCRIPTION

1326 ENERGY PARK DRIVE
ST. PAUL, MINNESOTA 55108
(651) 644-4389
Howard R. Green Company

**2003 STREET IMPROVEMENTS
CITY OF ELK RIVER**

**EXISTING TOPOGRAPHY AND REMOVALS
NORFOLK AVENUE
0+00 TO 5+93**

SHEET NO.
11