
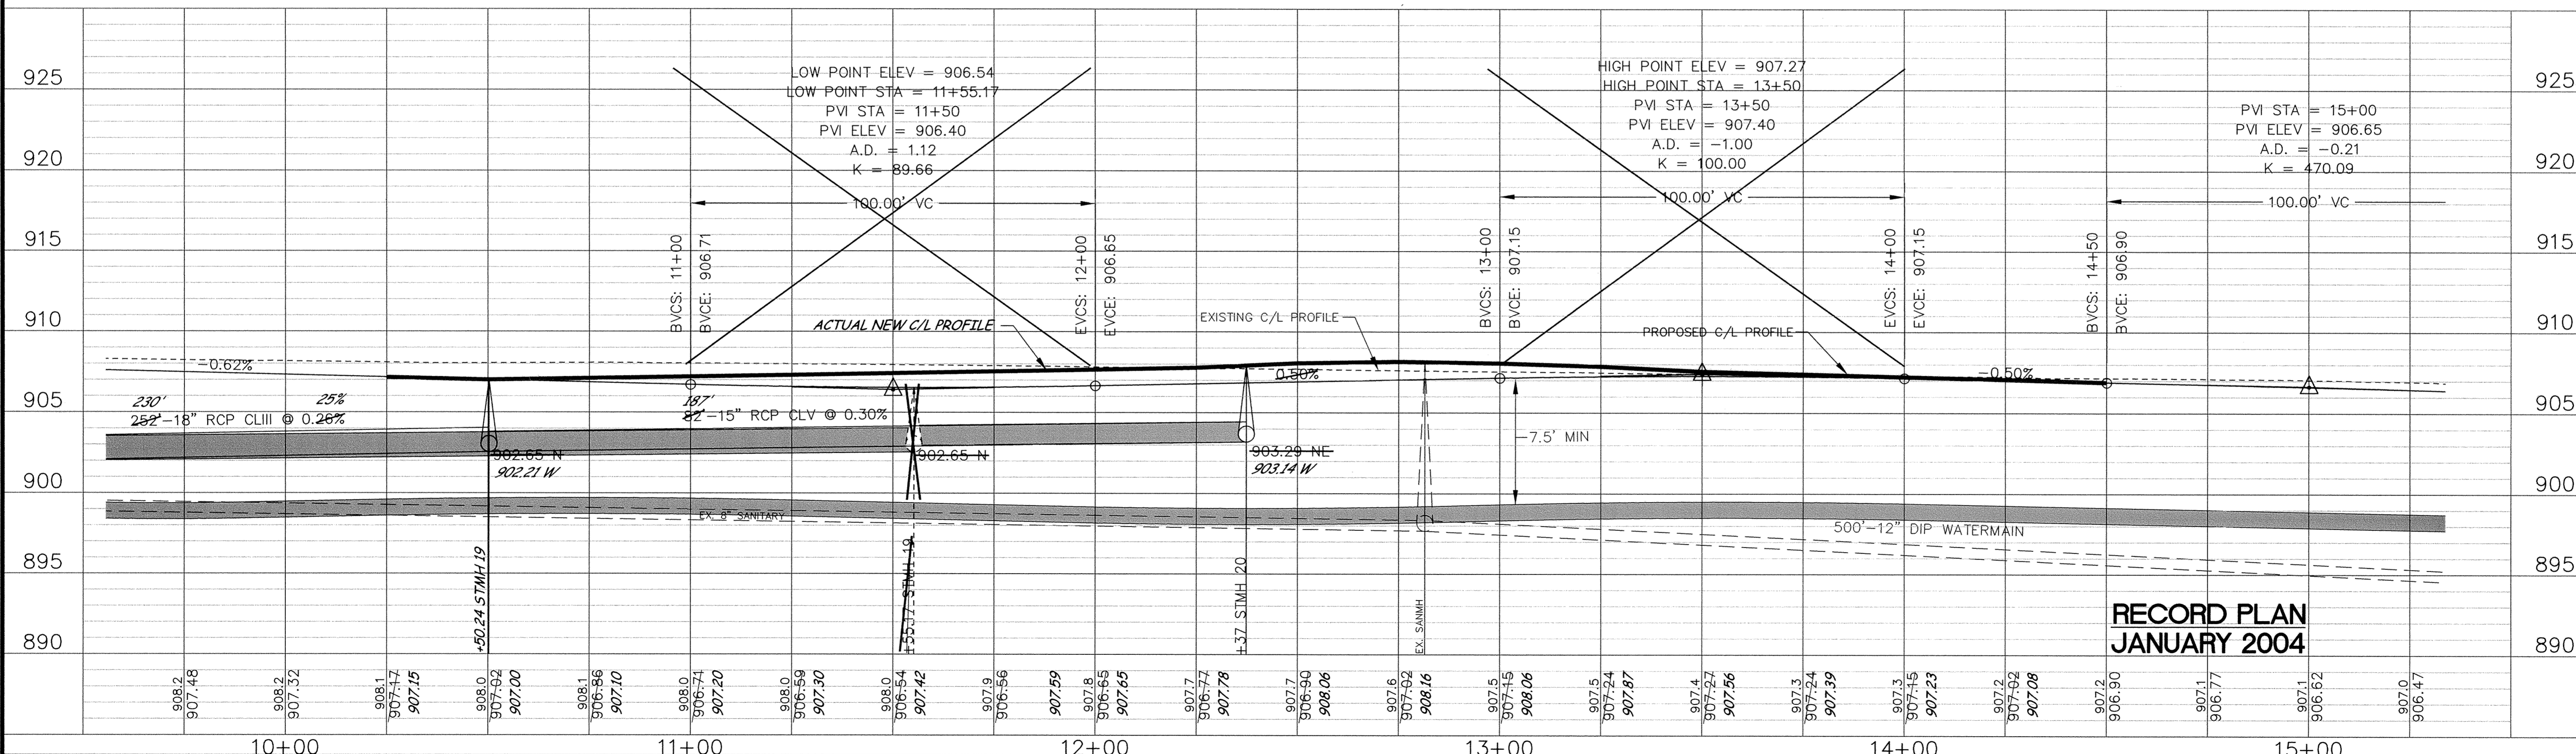


FOURTH STREET

SEE SHEET 21

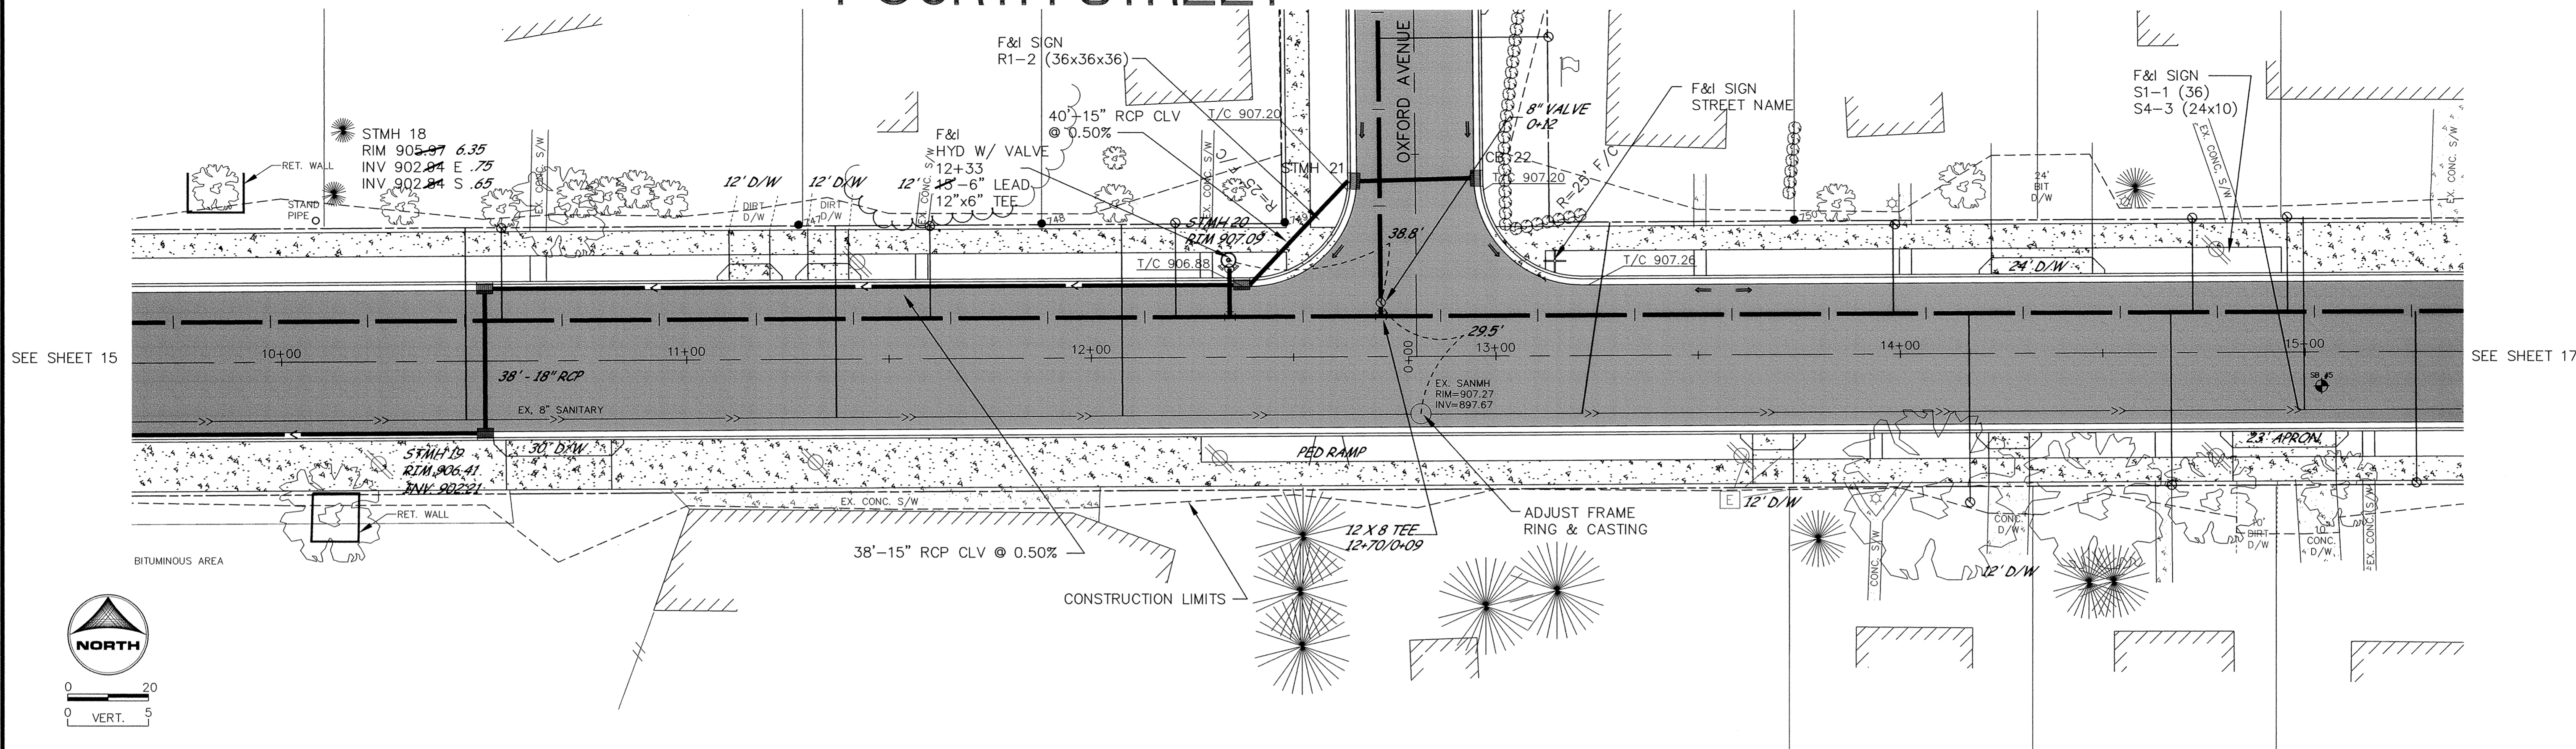

**RECORD PLAN
JANUARY 2004**

DESIGNED BY: DESIGNED BY: DRAWN BY: RKM
 APPROVED BY: APPROVED BY: JOB NUMBER 818980J
 CAD DATE: March 05, 2004 10:15:03 a.m.
 CAD FILE: 818980J_As-built\C\CT-D03.DWG (TELGAAR)

I HEREBY CERTIFY THAT THIS PLAN, SPECIFICATION, OR REPORT WAS PREPARED BY ME OR UNDER MY DIRECT SUPERVISION AND THAT I AM A DULY LICENSED PROFESSIONAL ENGINEER UNDER THE LAWS OF THE STATE OF MINNESOTA.
 SIGNATURE: *Kristina Thompson* DATE: 4/2/04
 PRINTED NAME: KRISTINA J. THOMPSON LIC. NO.: 42350

NO.	DATE	BY	REVISION DESCRIPTION

1326 ENERGY PARK DRIVE
 ST. PAUL, MINNESOTA 55108
 (651) 644-4389

Howard R. Green Company

2003 STREET IMPROVEMENTS
 CITY OF ELK RIVER

PLAN AND PROFILE
 FOURTH STREET
 10+00 TO 15+00

SHEET NO.
16

DRAWING NUMBER
 03IMPR.04
 16
 DRAWING NUMBER
 16
 DRAWING NUMBER
 16
 S&CO PRODUCTS • NEW HARBOR, MINNESOTA
 REQUESTED BY: PART NUMBER 8558
 PREPARED BY: PART NUMBER 8558
 PROJECT NUMBER: 03IMPR.04