
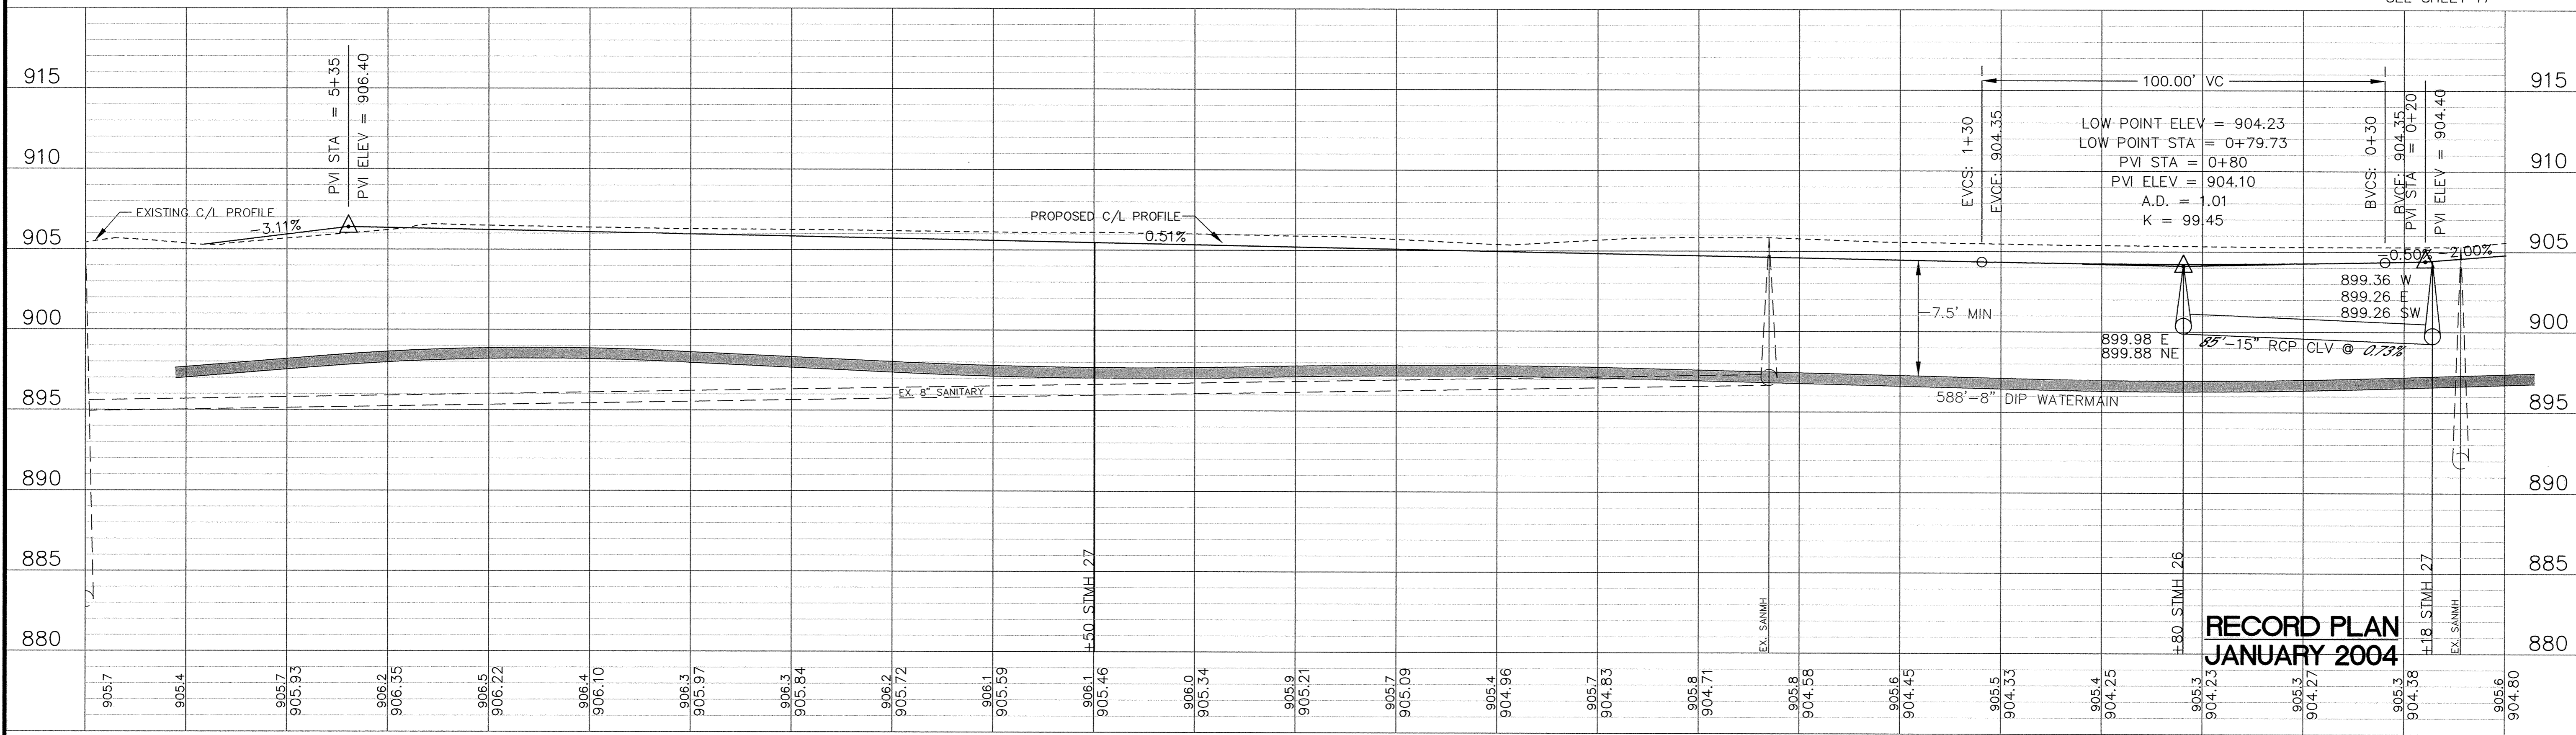


NORFOLK AVENUE

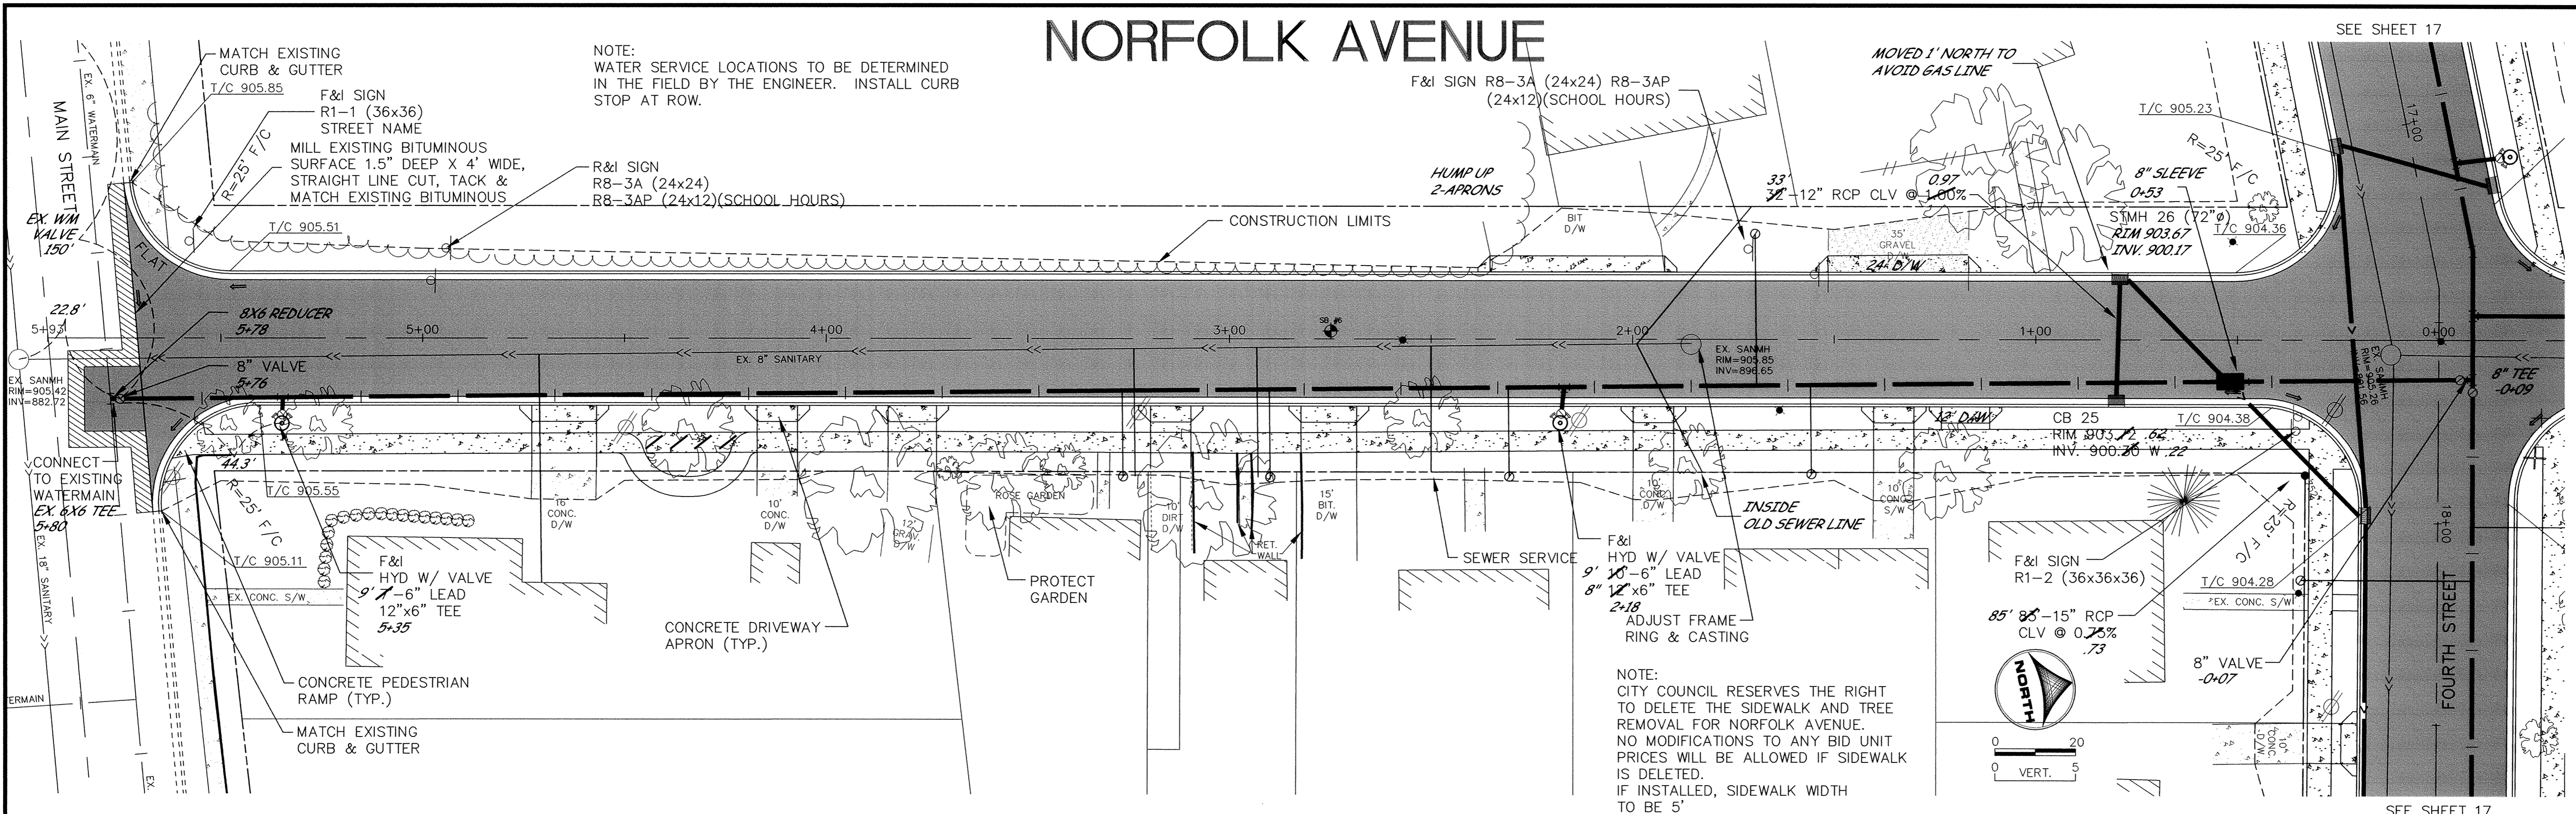

DESIGNED BY: DESIGNED BY DRAWN BY: RKM
 APPROVED BY: APPROVED BY JOB NUMBER 818980J
 CAD DATE: March 08, 2004 10:24:53 a.m.
 CAD FILE: 818980J\As-built\CT-D09.DWG (TELGAAR)

I HEREBY CERTIFY THAT THIS PLAN, SPECIFICATION, OR REPORT WAS PREPARED BY ME OR UNDER MY DIRECT SUPERVISION AND THAT I AM A DULY LICENSED PROFESSIONAL ENGINEER UNDER THE LAWS OF THE STATE OF MINNESOTA.
 SIGNATURE: *Kristina J. Thompson* DATE: 4/21/04
 PRINTED NAME: KRISTINA J. THOMPSON LIC. NO. 42350

NO.	DATE	BY	REVISION DESCRIPTION

1326 ENERGY PARK DRIVE
 ST. PAUL, MINNESOTA 55108
 (651) 644-4389
Howard R. Green Company

2003 STREET IMPROVEMENTS
 CITY OF ELK RIVER

PLAN AND PROFILE
 NORFOLK AVENUE
 0+00 TO 5+93

SHEET NO.
22

DRAWING NUMBER
 03IMPR.04
 22
 SARGO PRODUCTS • NEW HART, MINNESOTA
 REVISION BY PART NUMBER 6582
 PREPARED BY PART NUMBER 6582
 PRINTED DATE OF PAPER OR FILE NAME