


SACCO PRODUCTS • NEW HOPE, MINNESOTA
REVISION BY PART NUMBER 0532
REVISION DATE OF PART NUMBER 05/01


MORTON AVENUE

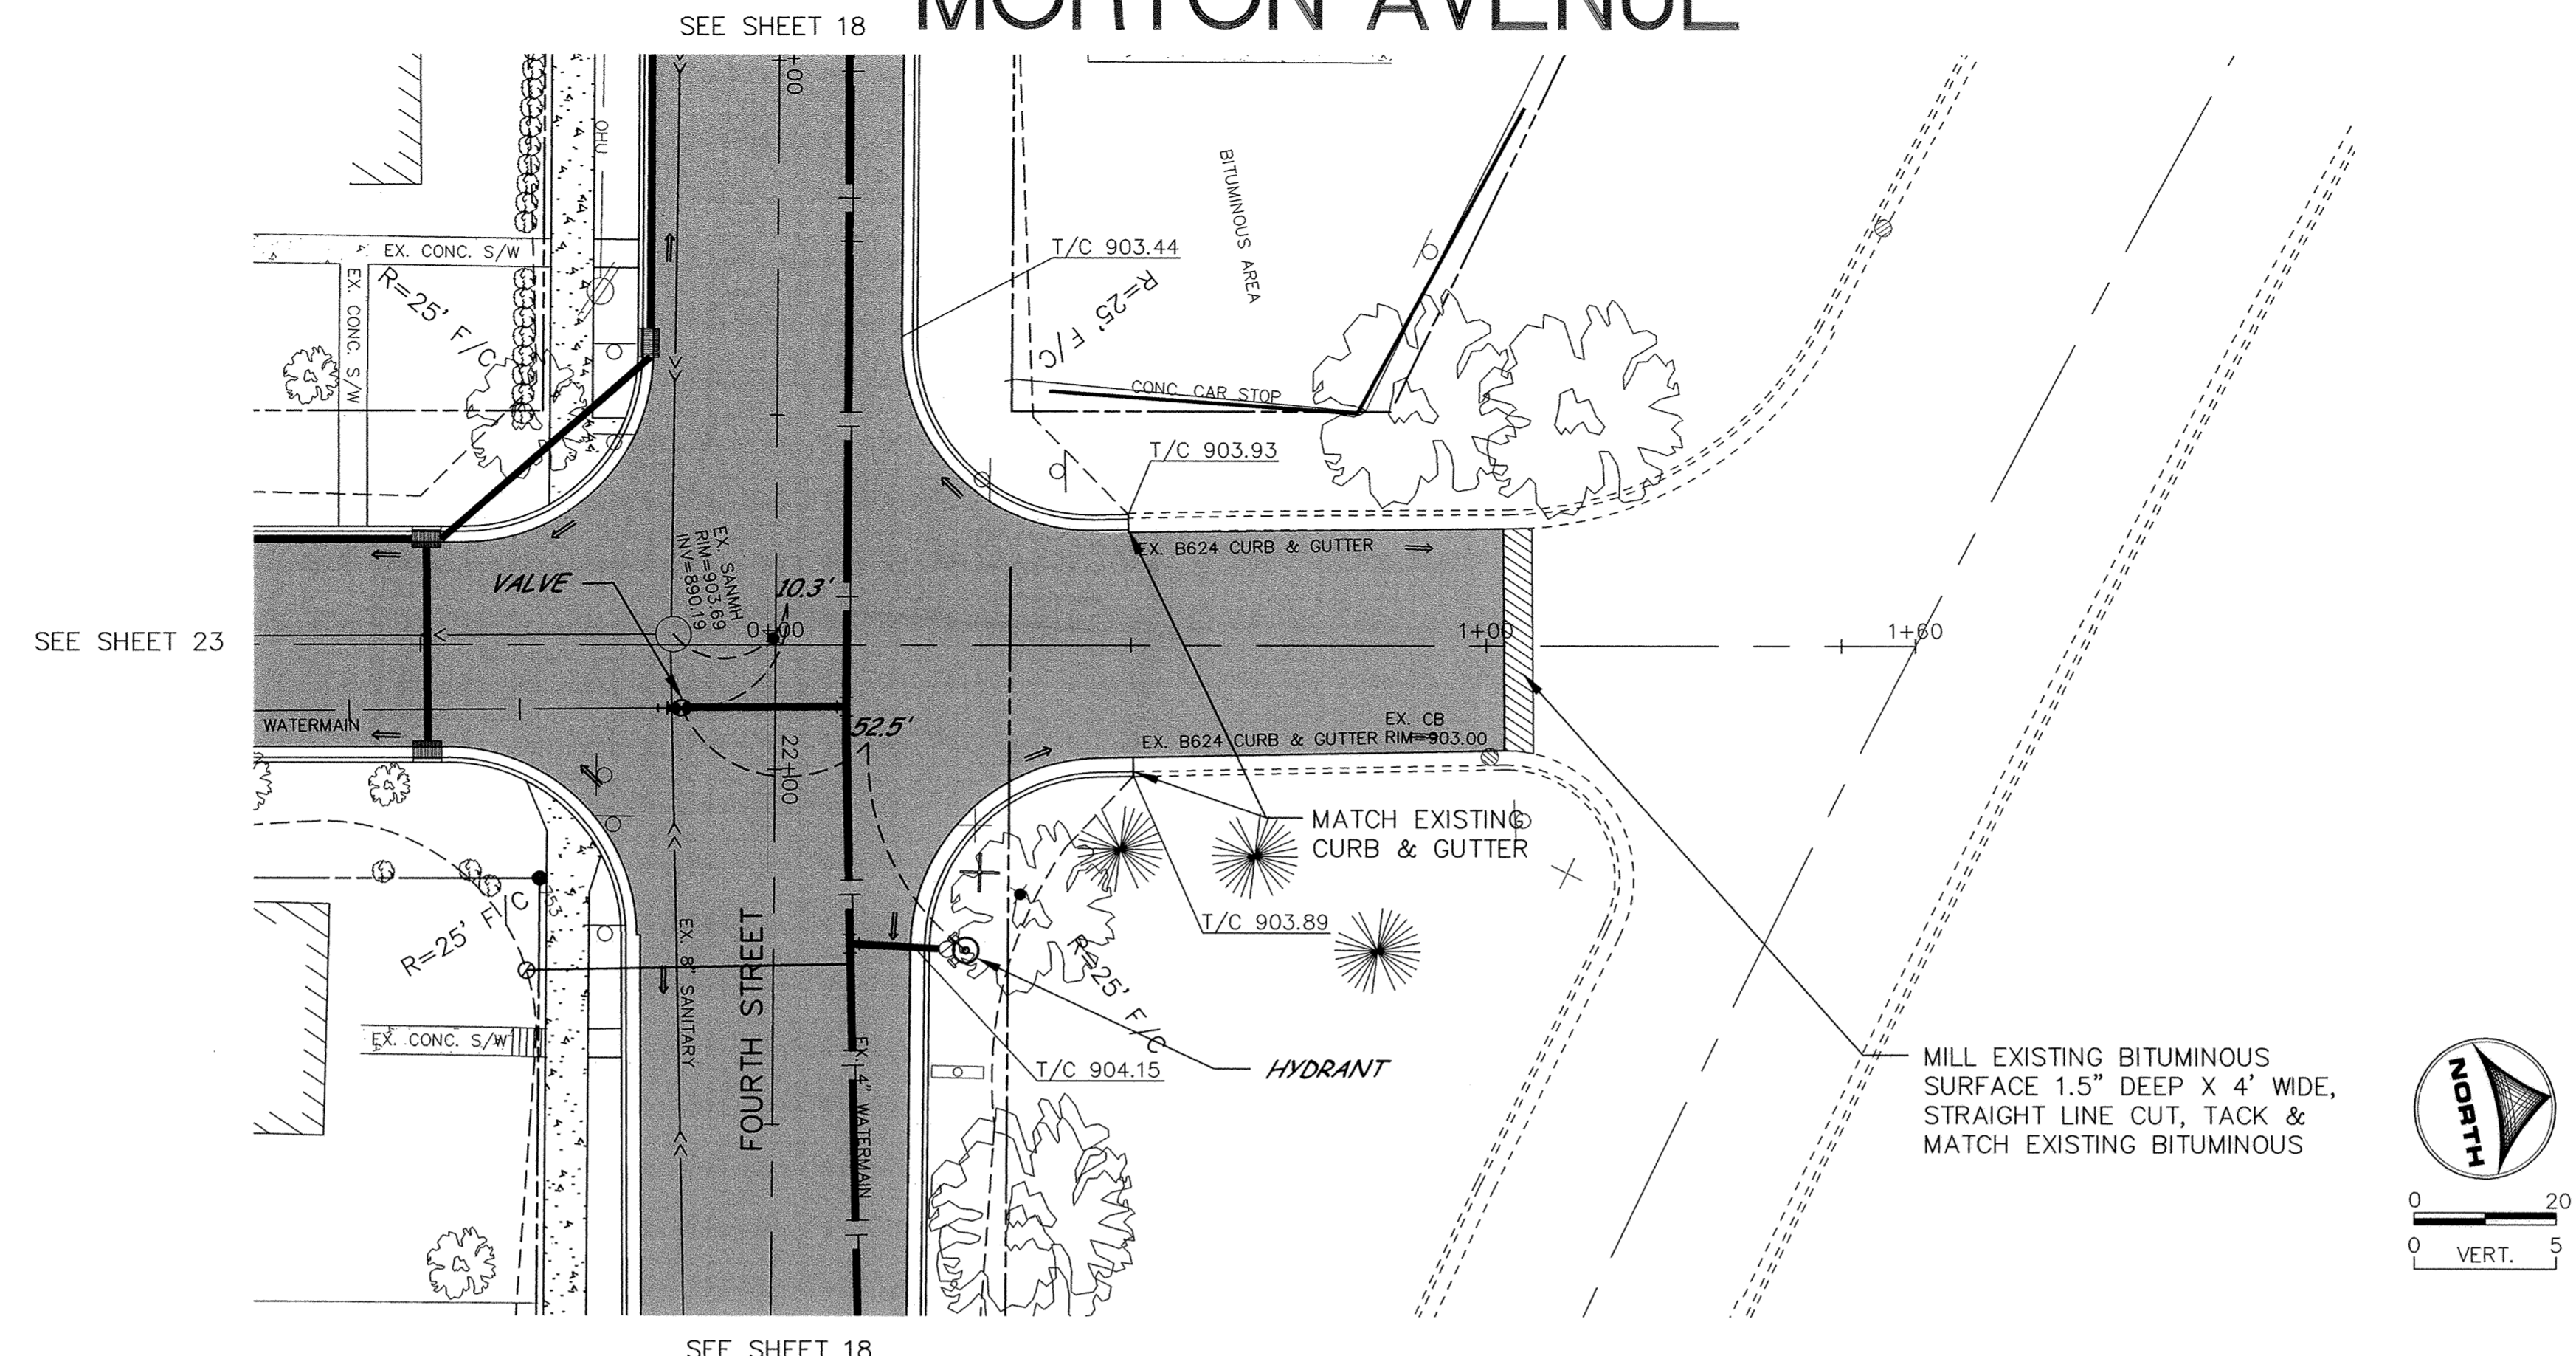

SEE SHEET 18

SEE SHEET 23

SEE SHEET 18

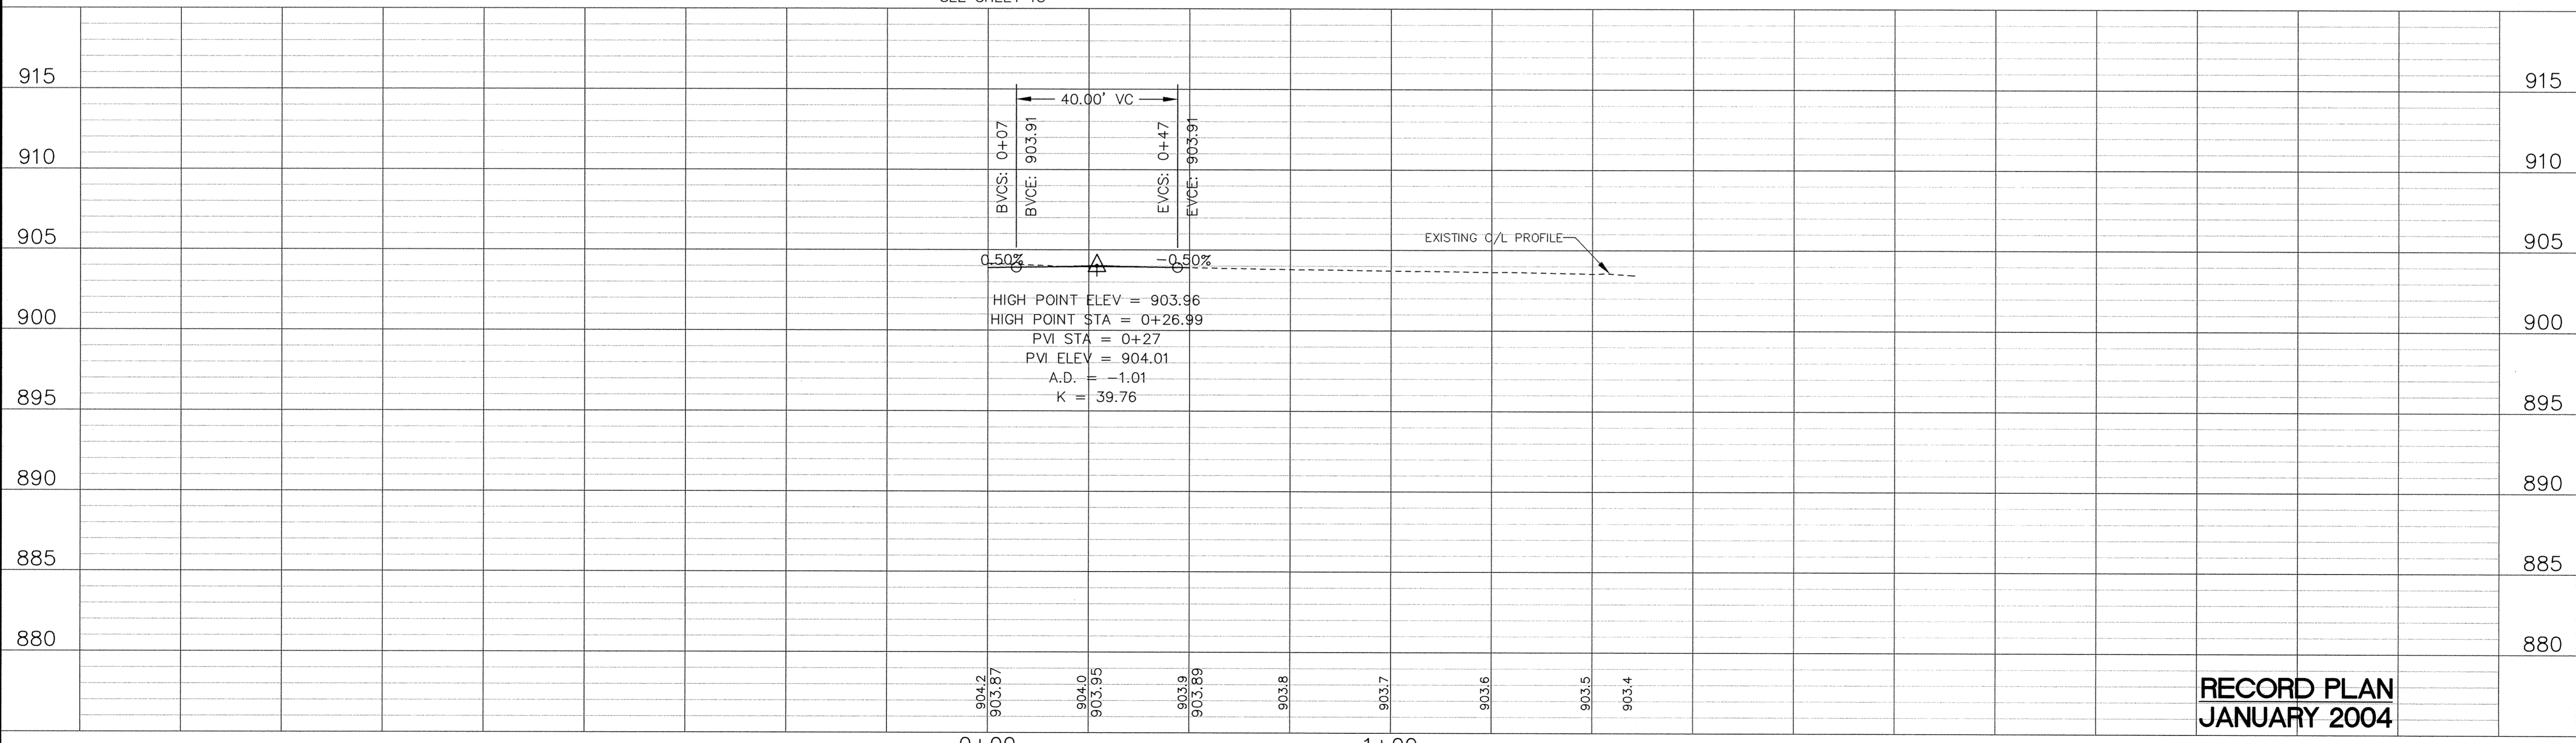

**RECORD PLAN
JANUARY 2004**

DESIGNED BY: DESIGNED BY: DRAWN BY: RKM
 APPROVED BY: APPROVED BY: JOB NUMBER 818980J
 CAD DATE: March_08_2004 11:08:47 a.m.
 CAD FILE: 818980J\As-built\C\CT-D11.DWG (TELGAAR)

I HEREBY CERTIFY THAT THIS PLAN, SPECIFICATION, OR REPORT WAS PREPARED BY ME OR UNDER MY DIRECT SUPERVISION AND THAT I AM A DULY LICENSED PROFESSIONAL ENGINEER UNDER THE LAWS OF THE STATE OF MINNESOTA.
 SIGNATURE: *Kristina J. Thompson* DATE: 4/2/04
 PRINTED NAME: KRISTINA J. THOMPSON LIC. NO. 42350

NO.	DATE	BY	REVISION DESCRIPTION

1326 ENERGY PARK DRIVE
 ST. PAUL, MINNESOTA 55108
 (651) 644-4389
Howard R. Green Company

2003 STREET IMPROVEMENTS
 CITY OF ELK RIVER

PLAN AND PROFILE
 MORTON AVENUE
 0+00 TO 1+60

SHEET NO.
24