FOURTH STREET

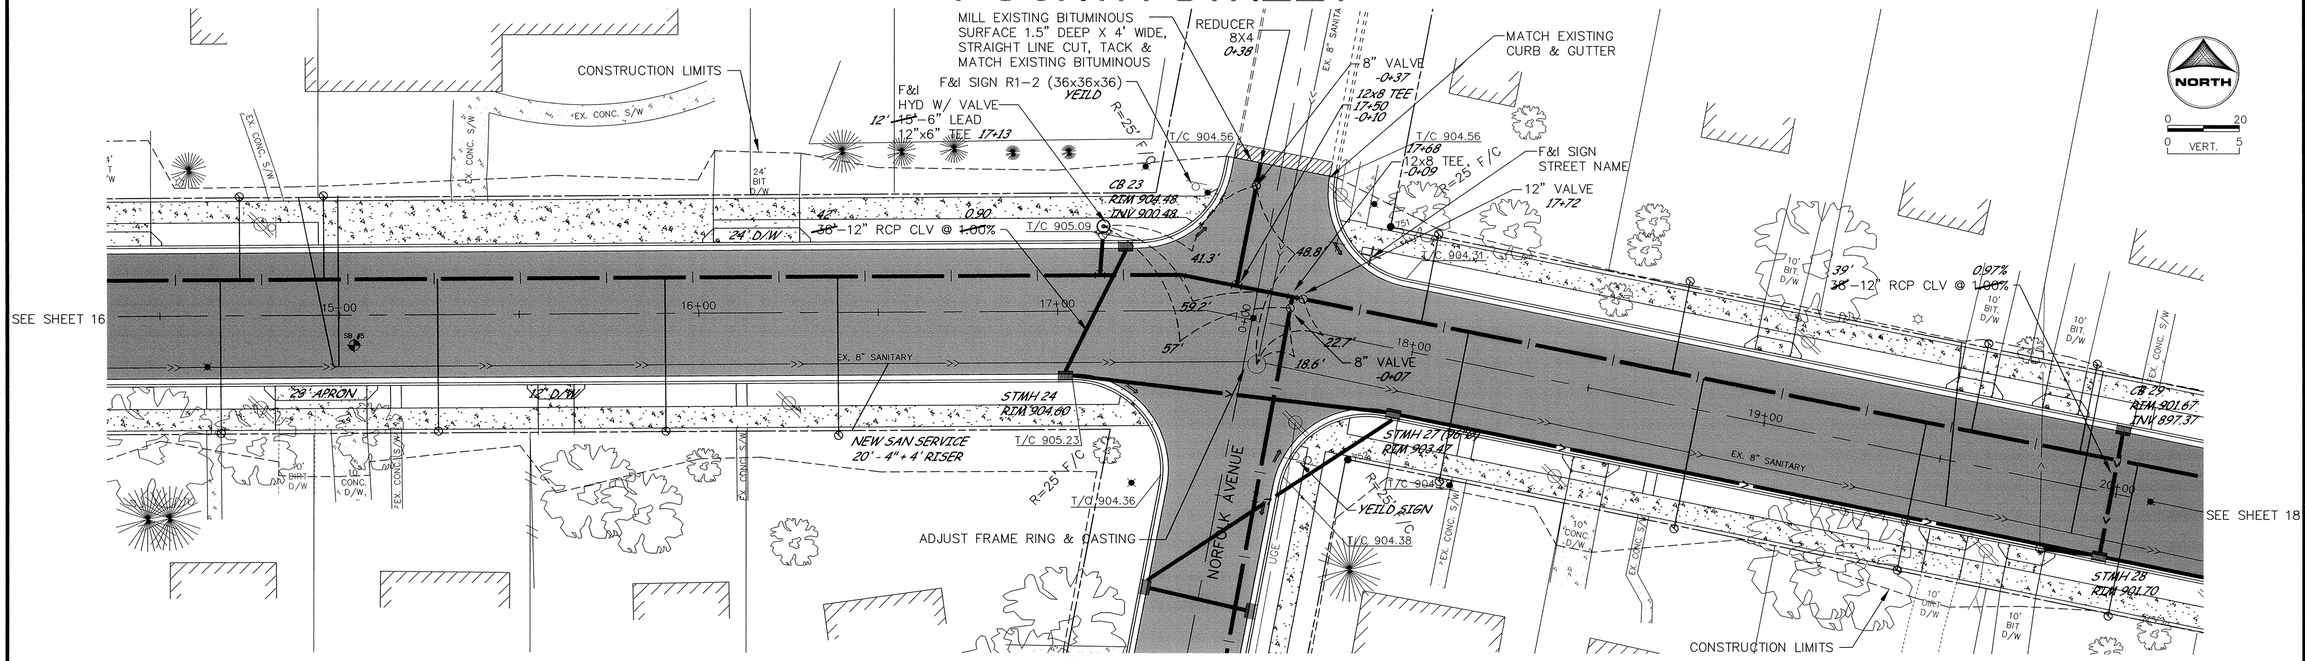

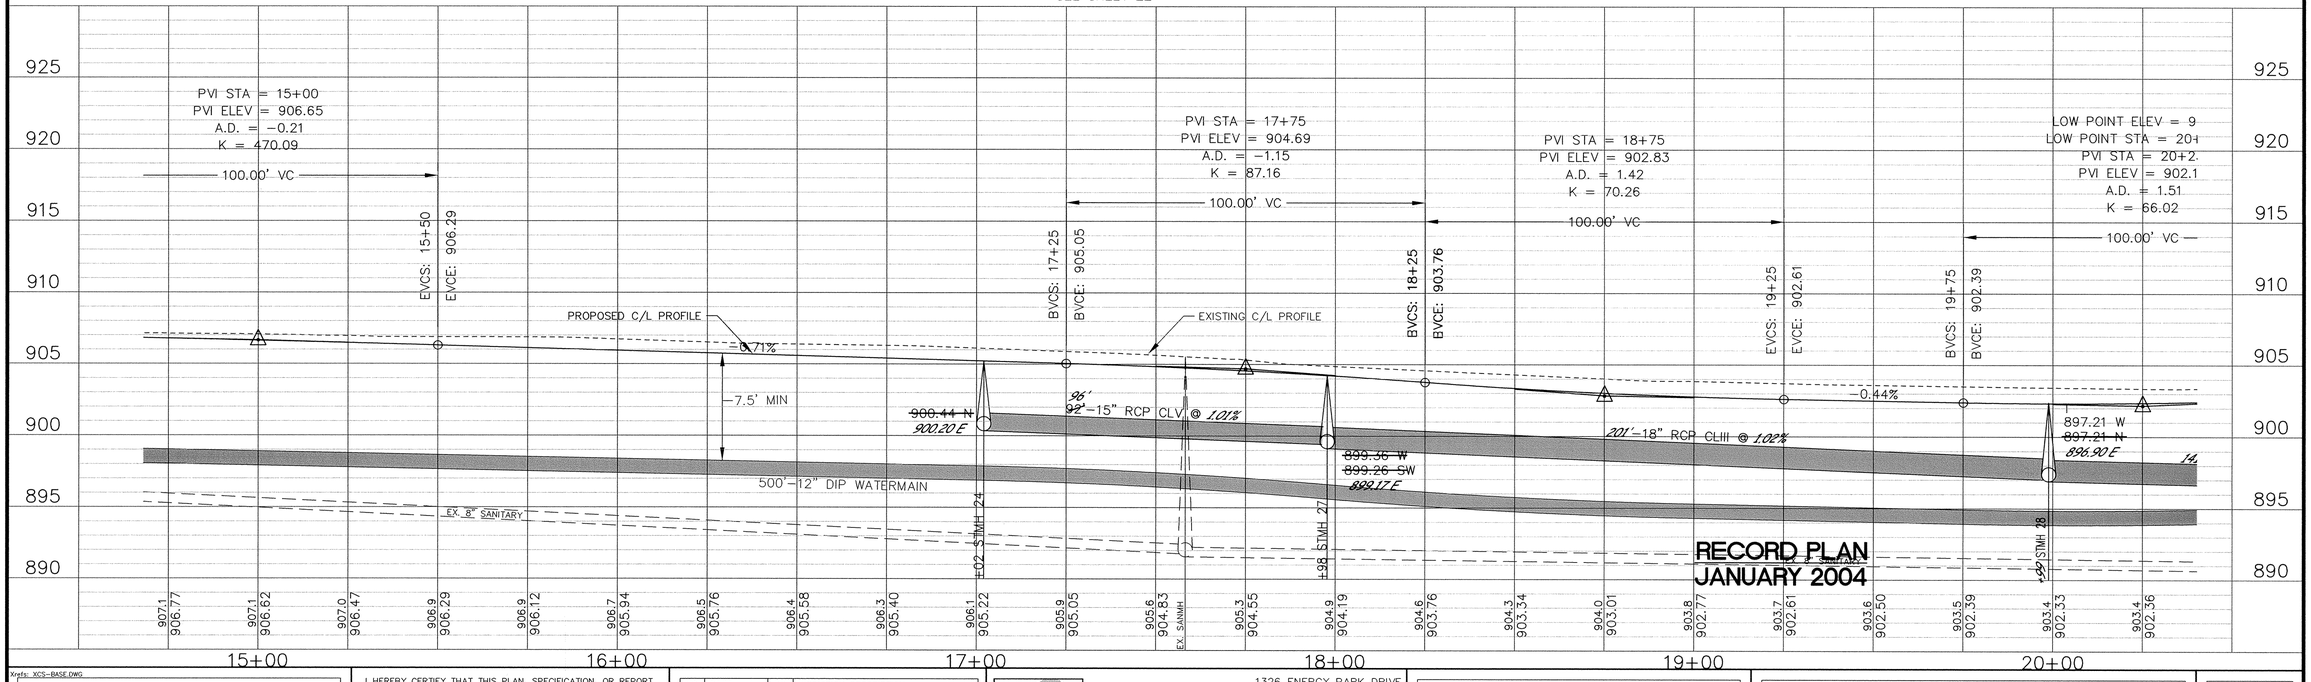

RECORD PLAN
JANUARY 2004

Xrefs: XCS-BASE.DWG

DESIGNED BY: DESIGNED BY DRAWN BY: RKM
APPROVED BY: APPROVED BY JOB NUMBER 818980J
CAD DATE: March 05, 2004 11:06:41 a.m.
CAD FILE: 818980J\As-built\C\CT-D04.DWG (TELGAAR)

I HEREBY CERTIFY THAT THIS PLAN, SPECIFICATION, OR REPORT WAS PREPARED BY ME OR UNDER MY DIRECT SUPERVISION AND THAT I AM A DULY LICENSED PROFESSIONAL ENGINEER UNDER THE LAWS OF THE STATE OF MINNESOTA.
SIGNATURE Kristina Thompson DATE 4/21/04
PRINTED NAME KRISTINA J. THOMPSON LIC.NO. 42350

NO.	DATE	BY	REVISION DESCRIPTION

Howard R. Green Company
1326 ENERGY PARK DRIVE
ST. PAUL, MINNESOTA 55108
(651) 644-4389

2003 STREET IMPROVEMENTS
CITY OF ELK RIVER

PLAN AND PROFILE
FOURTH STREET
15+00 TO 20+00

SHEET NO.
17

DRAWING NUMBER
03IMPR.04
17

SAFCO PRODUCTS • NEW HOPE, MINNESOTA
REORDER BY PART NUMBER 8552
POSITION EDGE OF PRINT ON THIS LINE