FOURTH STREET

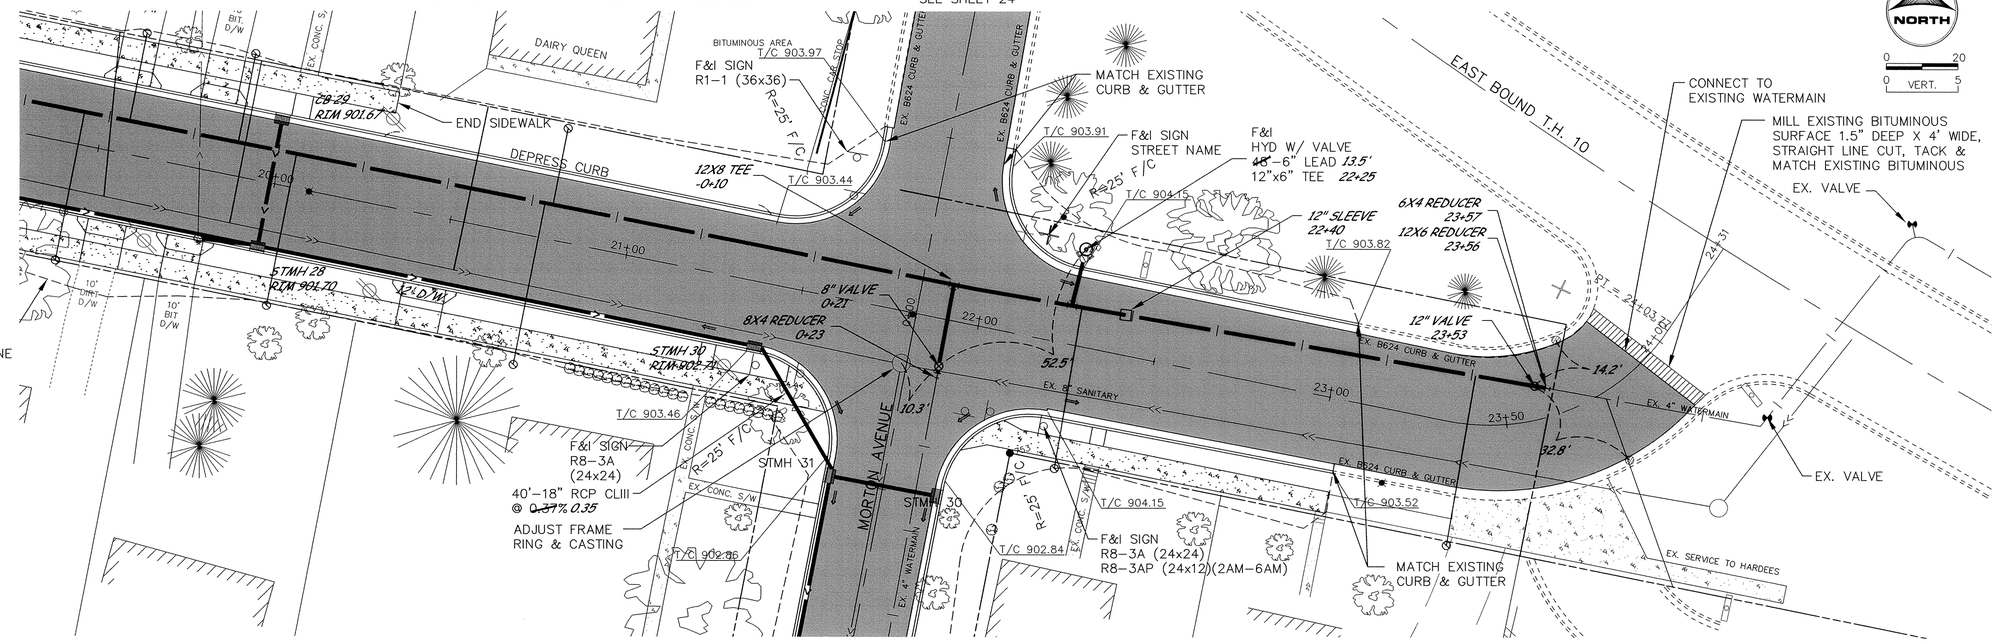

DAIRY QUEEN INFORMATION:

1. CONTACT SCOTT MITCHELL JR. 763-441-1823
2. HOURS OF OPERATION 11AM-10PM DAILY
3. WATER SHUT OFF MUST BE DONE OUTSIDE OF BUSINESS HOURS
4. DELIVERY SCHEDULE
   GARBAGE: MON., WED., FRID.
   BREAD: DAILY EXCEPT WED. & SUN.
   OTHER WED. (2)
   SAT. (1)
5. CONCRETE TO BE HIGH EARLY STRENGTH

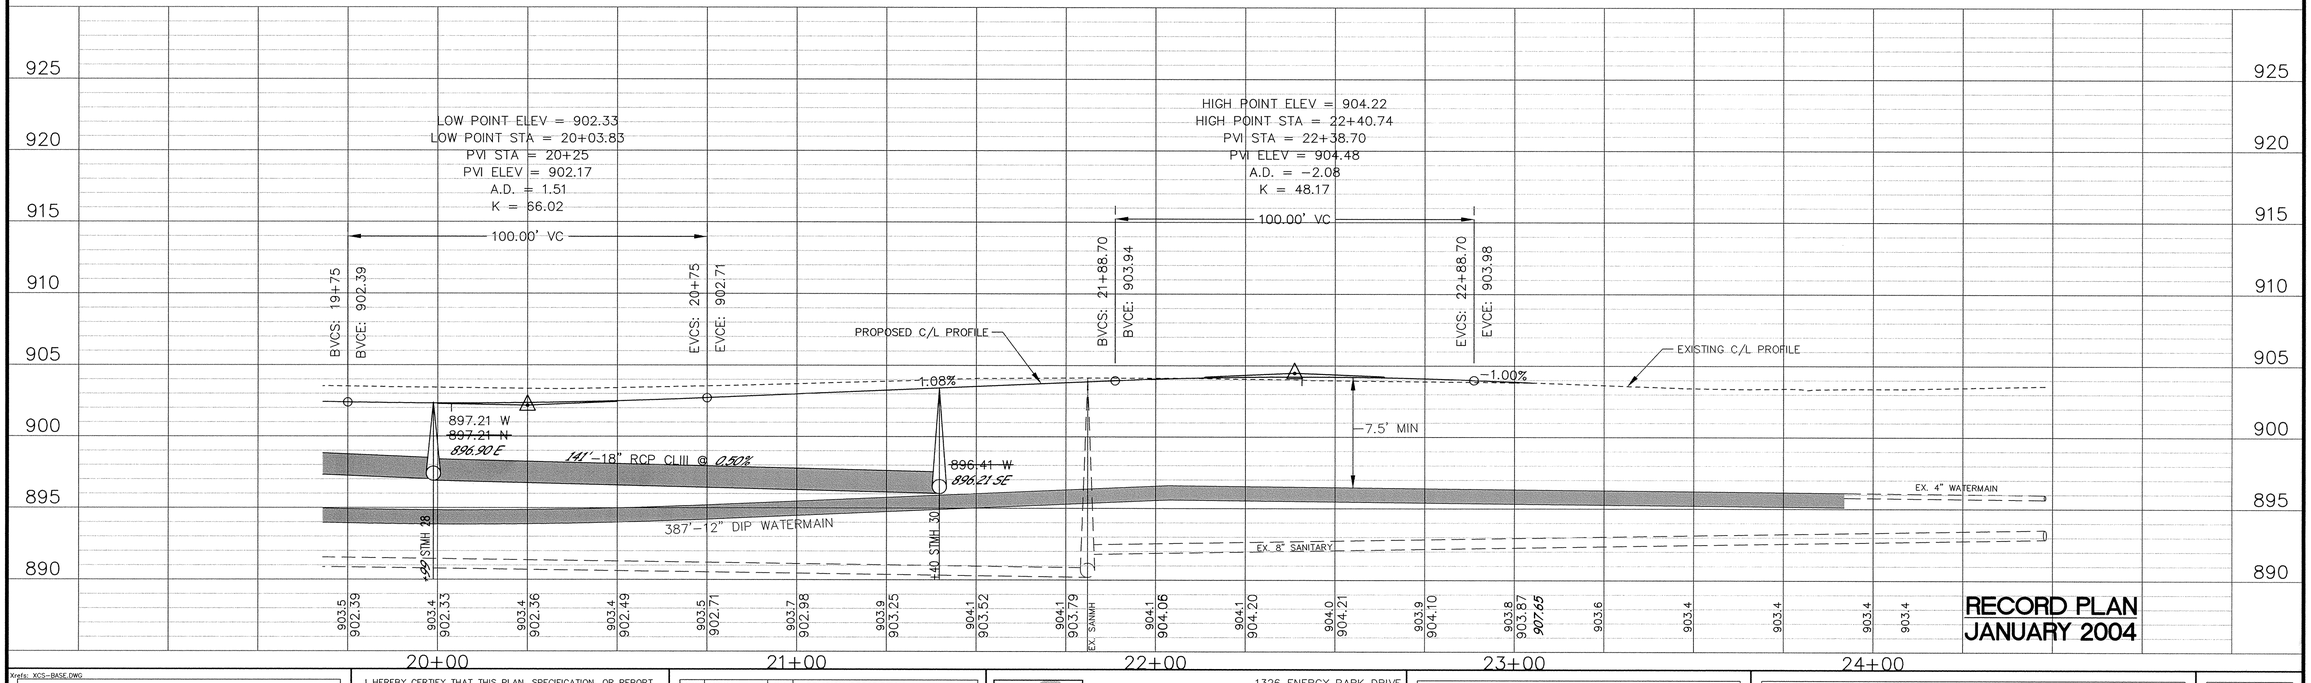

RECORD PLAN
JANUARY 2004

Xrefs: XCS-BASE.DWG

DESIGNED BY: DESIGNED BY DRAWN BY: RKM
APPROVED BY: APPROVED BY JOB NUMBER 818980J
CAD DATE: March 05, 2004 12:56:59 p.m.
CAD FILE: 818980J\As-built\C\CT-D05.DWG (TELGAAR)

I HEREBY CERTIFY THAT THIS PLAN, SPECIFICATION, OR REPORT WAS PREPARED BY ME OR UNDER MY DIRECT SUPERVISION AND THAT I AM A DULY LICENSED PROFESSIONAL ENGINEER UNDER THE LAWS OF THE STATE OF MINNESOTA.

SIGNATURE Kristina Thompson DATE 4/21/04
PRINTED NAME KRISTINA J. THOMPSON LIC.NO. 42350

NO.	DATE	BY	REVISION DESCRIPTION

Howard R. Green Company
1326 ENERGY PARK DRIVE
ST. PAUL, MINNESOTA 55108
(651) 644-4389

2003 STREET IMPROVEMENTS
CITY OF ELK RIVER

PLAN AND PROFILE
FOURTH STREET
20+00 TO 23+92

SHEET NO.
18

DRAWING NUMBER

SAFCO PRODUCTS • NEW HOPE, MINNESOTA
REORDER BY PART NUMBER 6562
POSITION EDGE OF PAINT ON THIS LINE

DRAWING NUMBER
'03IMPR.04
18