QUINN AVENUE

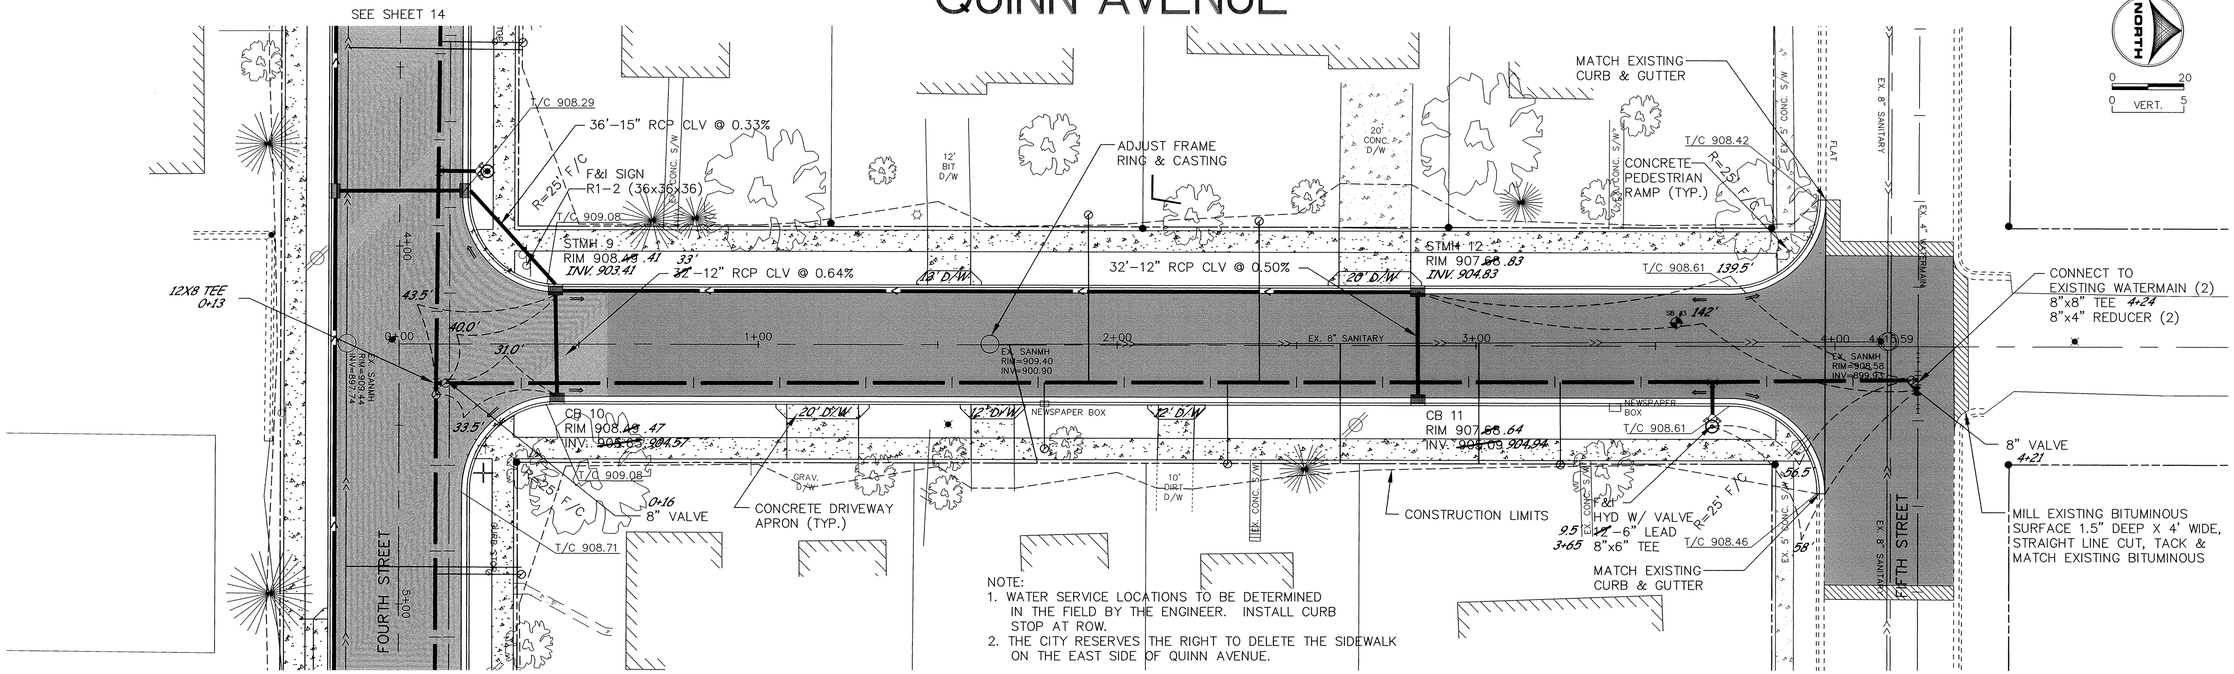

NOTE:
1. WATER SERVICE LOCATIONS TO BE DETERMINED IN THE FIELD BY THE ENGINEER. INSTALL CURB STOP AT ROW.
2. THE CITY RESERVES THE RIGHT TO DELETE THE SIDEWALK ON THE EAST SIDE OF QUINN AVENUE.

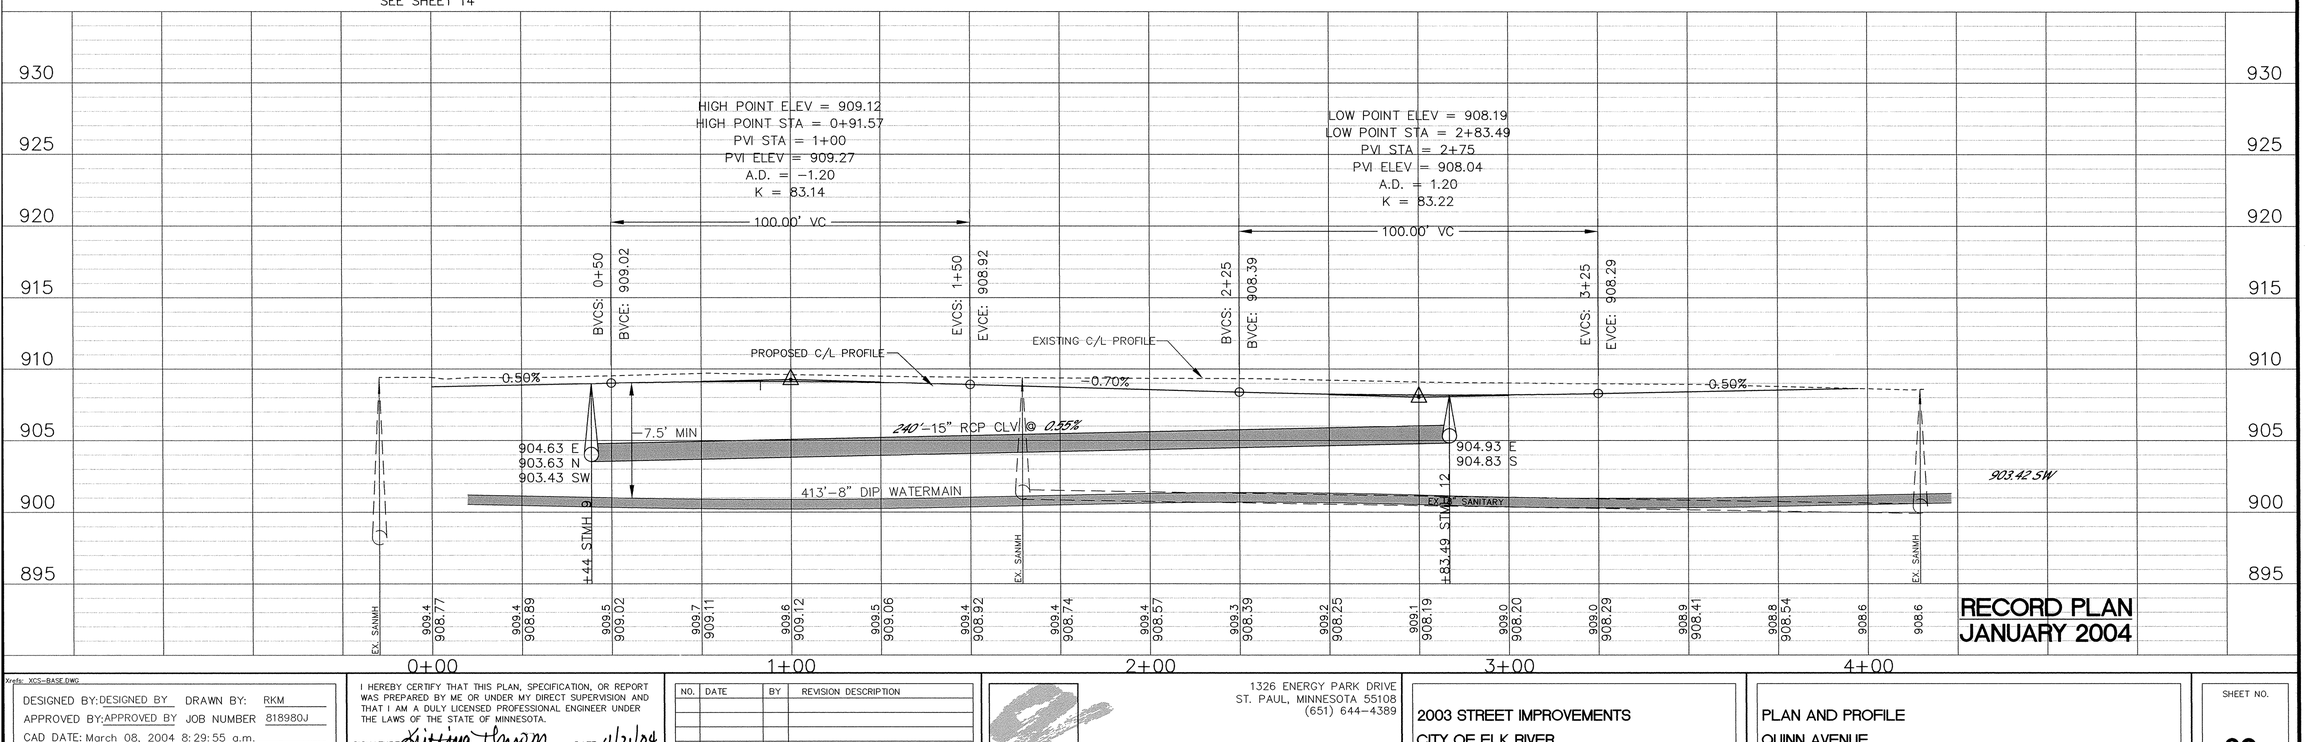

RECORD PLAN
JANUARY 2004

Xrefs: XCS-BASE.DWG

DESIGNED BY: DESIGNED BY DRAWN BY: RKM
APPROVED BY: APPROVED BY JOB NUMBER 818980J
CAD DATE: March 08, 2004 8:29:55 a.m.
CAD FILE: 818980J\As-built\C\CT-D07.DWG (TELGAAR)

I HEREBY CERTIFY THAT THIS PLAN, SPECIFICATION, OR REPORT WAS PREPARED BY ME OR UNDER MY DIRECT SUPERVISION AND THAT I AM A DULY LICENSED PROFESSIONAL ENGINEER UNDER THE LAWS OF THE STATE OF MINNESOTA.

SIGNATURE Kristina Thompson DATE 4/21/04
PRINTED NAME KRISTINA J. THOMPSON LIC.NO. 42350

NO.	DATE	BY	REVISION DESCRIPTION

Howard R. Green Company
1326 ENERGY PARK DRIVE
ST. PAUL, MINNESOTA 55108
(651) 644-4389

2003 STREET IMPROVEMENTS
CITY OF ELK RIVER

PLAN AND PROFILE
QUINN AVENUE
0+00 TO 4+15.59

SHEET NO.
20

DRAWING NUMBER
'03IMPR.04
20

SAFCO PRODUCTS • NEW HOPE, MINNESOTA
REORDER BY PART NUMBER 60502
POSITION EDGE OF PRINT ON THIS LINE