D/W LEFT 2+00




1+50




D/W LEFT 1+19

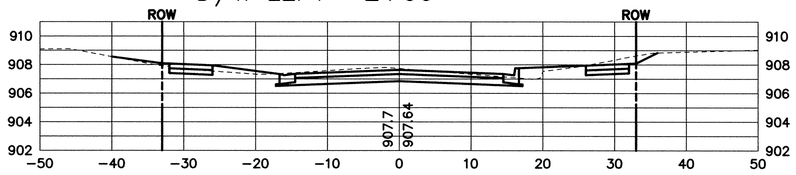


1+00

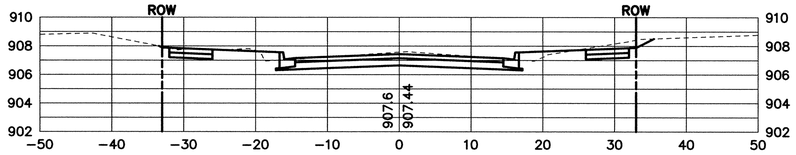


0+50

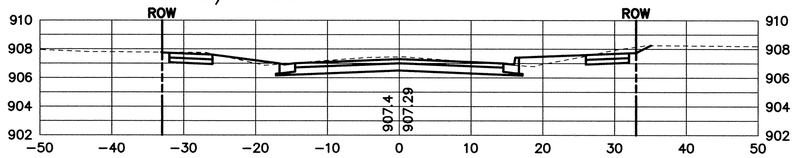


0+14.50

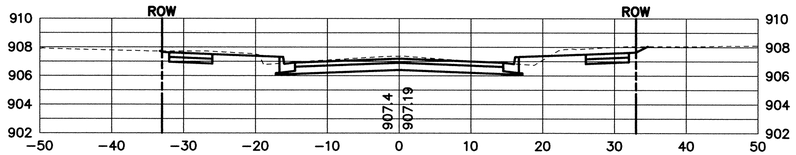


0+00 FOURTH STREET

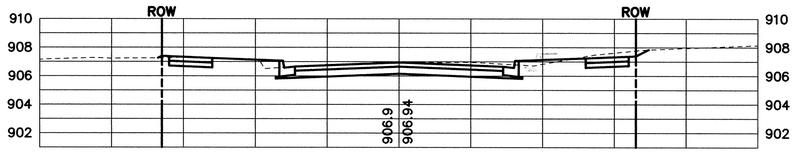


4+00

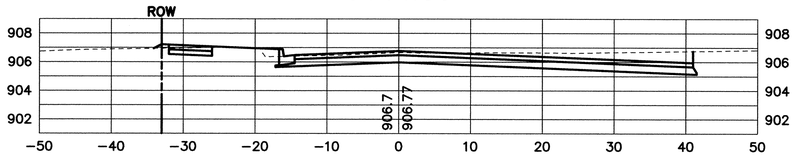


3+98.40

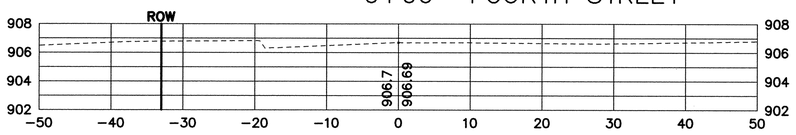


3+50

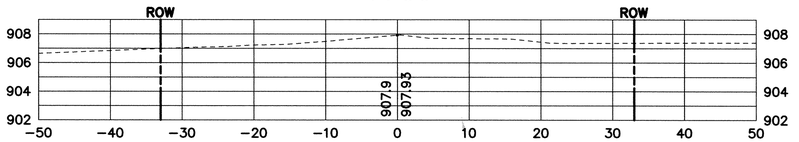


3+00

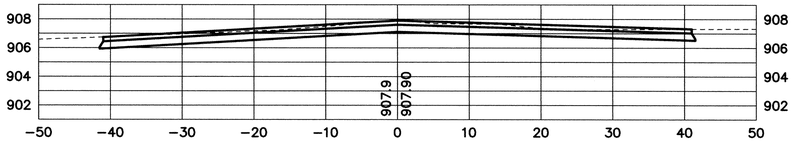


D/W LEFT 2+79

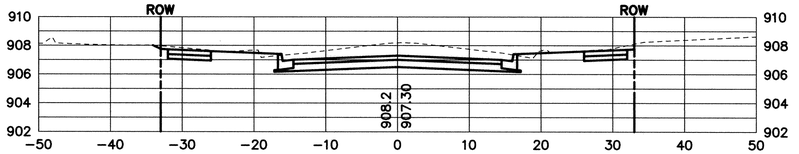


2+50

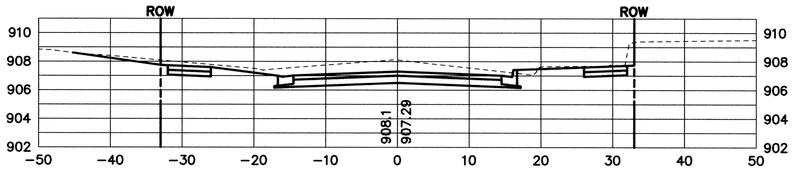


2+15 D/W RIGHT

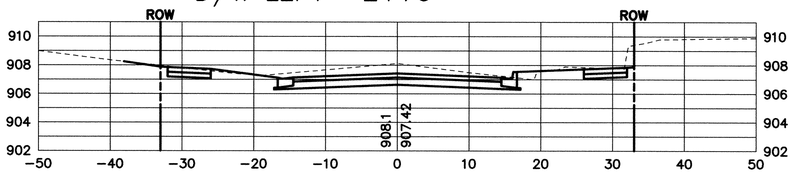


0 10
0 VERT. 5

**RECORD PLAN**
**APRIL 2004**

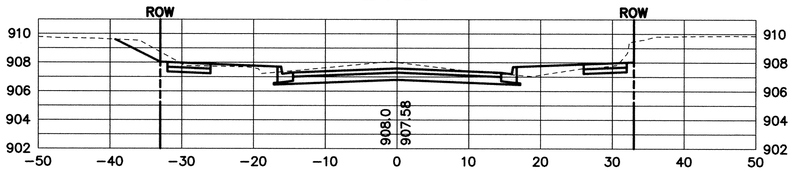Xrefs: XSECT-BASE.DWG

DESIGNED BY: DESIGNED BY DRAWN BY: RKM
APPROVED BY: APPROVED BY JOB NUMBER 818980J
CAD DATE: April 17, 2003 4:49:53 p.m.
CAD FILE: 818980J\Dwg\C\CT-X06.DWG (RMONJEA)

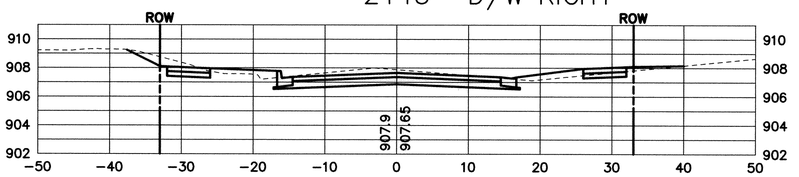I HEREBY CERTIFY THAT THIS PLAN, SPECIFICATION, OR REPORT WAS PREPARED BY ME OR UNDER MY DIRECT SUPERVISION AND THAT I AM A DULY LICENSED PROFESSIONAL ENGINEER UNDER THE LAWS OF THE STATE OF MINNESOTA.

SIGNATURE _____ DATE _____

PRINTED NAME KRISTINA J THOMPSON LIC.NO. 42350

| NO. | DATE | BY | REVISION DESCRIPTION |
|---|---|---|---|
| | | | |


Howard R. Green Company
1326 ENERGY PARK DRIVE
ST. PAUL, MINNESOTA 55108
(651) 644-4389


2003 STREET IMPROVEMENTS
CITY OF ELK RIVER

CROSS SECTIONS
RUSH AVENUE
0+00 TO 4+00

SHEET NO.
**30**

DRAWING NUMBER

SAFCO PRODUCTS • NEW HOPE, MINNESOTA
REORDER BY PART NUMBER 6502
PANTONE 186C OF PRINT ON THIS LINE

DRAWING NUMBER

SAFCO PRODUCTS • NEW HOPE, MINNESOTA
REORDER BY PART NUMBER 6502
PANTONE 186C OF PRINT ON THIS LINE

DRAWING NUMBER

SAFCO PRODUCTS • NEW HOPE, MINNESOTA
REORDER BY PART NUMBER 6502
PANTONE 186C OF PRINT ON THIS LINE

DRAWING NUMBER
'03IMPR.04
30

SAFCO PRODUCTS • NEW HOPE, MINNESOTA
REORDER BY PART NUMBER 6502
PANTONE 186C OF PRINT ON THIS LINE