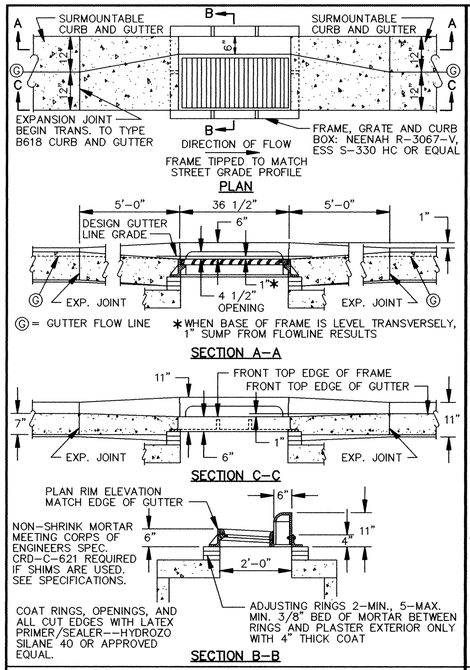

CATCH BASIN FRAME PLACEMENT
SURMOUNTABLE CURB AND GUTTER

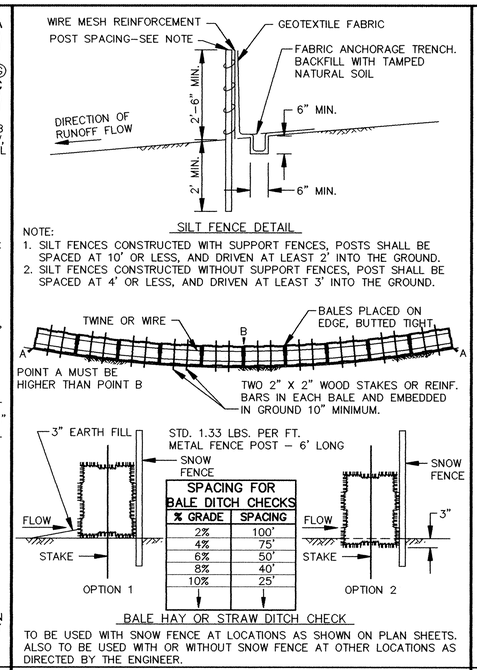

EROSION CONTROL DETAIL

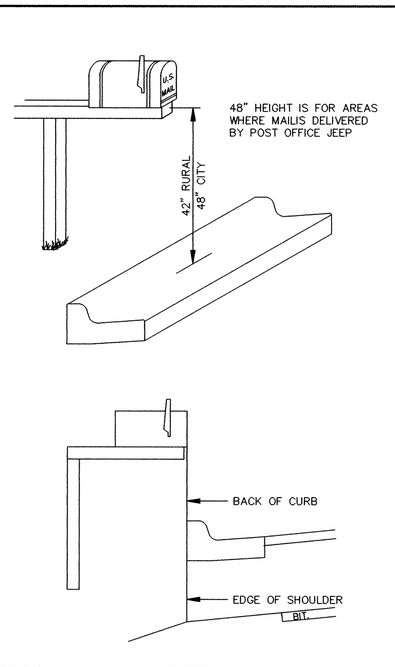

MAIL BOX

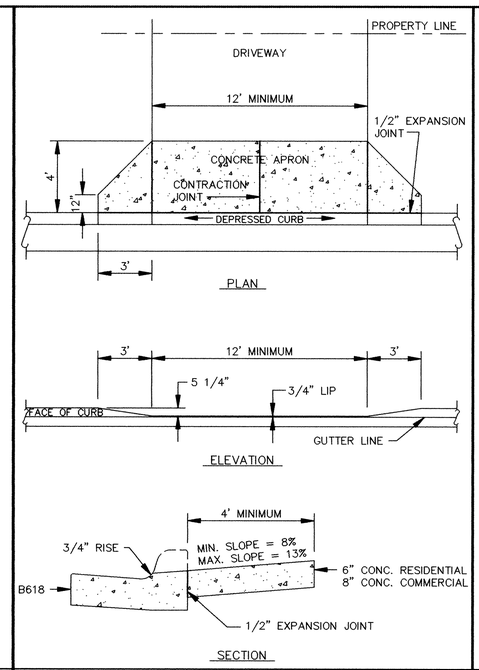

DEPRESSED CURB WITH DRIVEWAY APRON

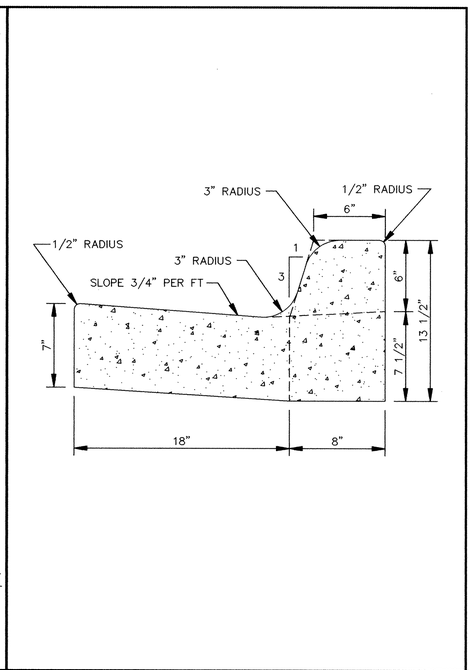

CONCRETE CURB AND GUTTER B618

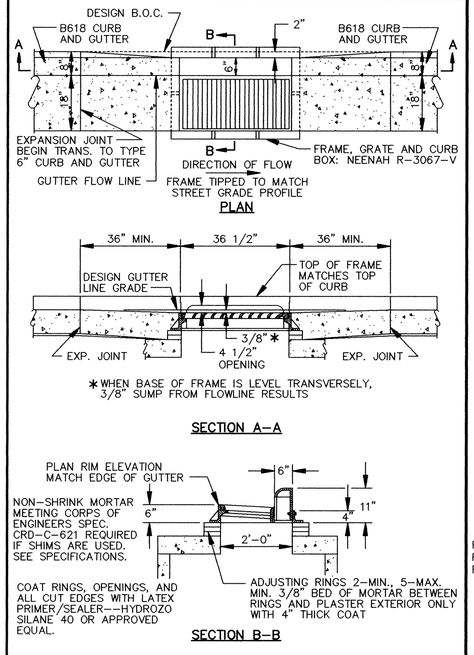

CATCH BASIN FRAME PLACEMENT
B618 CURB AND GUTTER

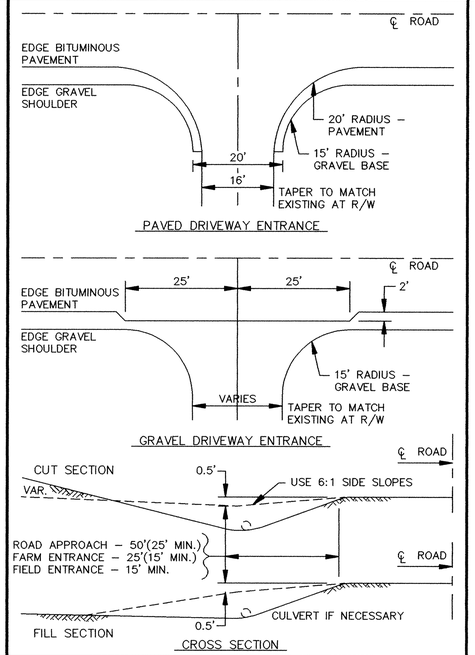

RURAL DRIVEWAY ENTRANCE

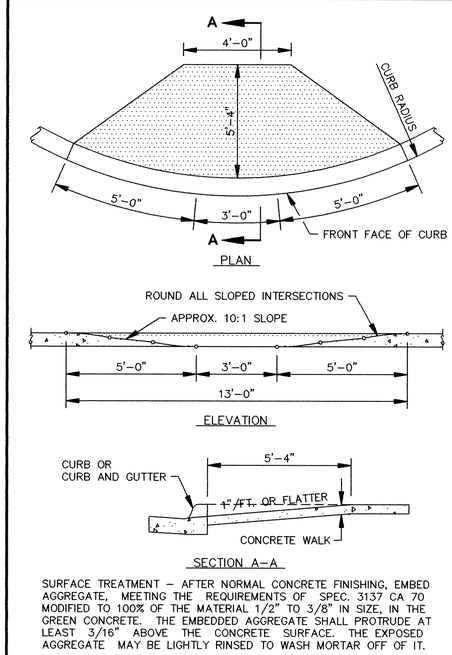

PEDESTRIAN CURB RAMPS

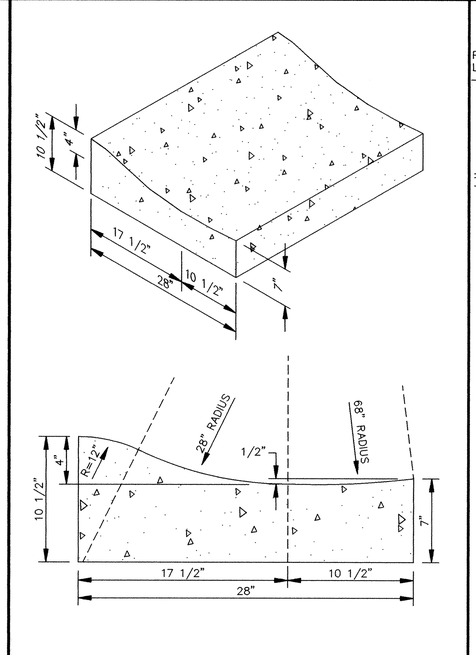

SURMOUNTABLE CONCRETE CURB AND GUTTER

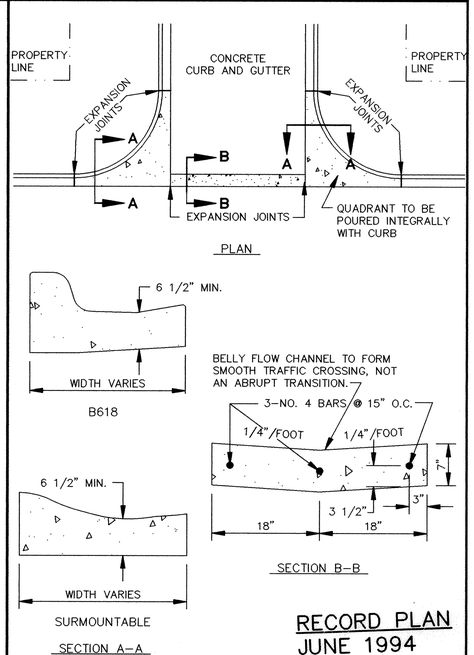

RECORD PLAN
JUNE 1994

CONCRETE "V" GUTTER

I HEREBY CERTIFY THAT THIS PLAN, SPECIFICATION, OR REPORT WAS PREPARED BY ME OR UNDER MY DIRECT SUPERVISION AND THAT I AM A DULY REGISTERED PROFESSIONAL ENGINEER UNDER THE LAWS OF THE STATE OF MINNESOTA.

DATE _____ REG.NO. _____

CONSULTING ENGINEERS
Maier Stewart & Associates Inc.
1959 SLOAN PLACE (612) 774-6021 ST. PAUL, MINNESOTA 55117
9800 SHELARD PARKWAY (612) 546-0432 MINNEAPOLIS, MINNESOTA 55441

REVISIONS	DATE	DESCRIPTION

DESIGNED ____
CHECKED ____
DRAWN ____
GRAPHIC SCALE
0 HORIZ. 2
0 VERT. N/A

CITY OF ELK RIVER
HWY. 10 LIFT STATION
STREET CONSTRUCTION DETAILS

DATE AUG 1993 | SHEET 14 OF 20 SHEETS | PROJECT NO. 230-178

691

DRAWING NUMBER
SAFCO PRODUCTS • NEW HOPE, MINNESOTA
REORDER PART NUMBER 6592

DRAWING NUMBER
SAFCO PRODUCTS • NEW HOPE, MINNESOTA
REORDER PART NUMBER 6592

DRAWING NUMBER
10HWY.93
9
("14 of 20")
SAFCO PRODUCTS • NEW HOPE, MINNESOTA
REORDER PART NUMBER 6592