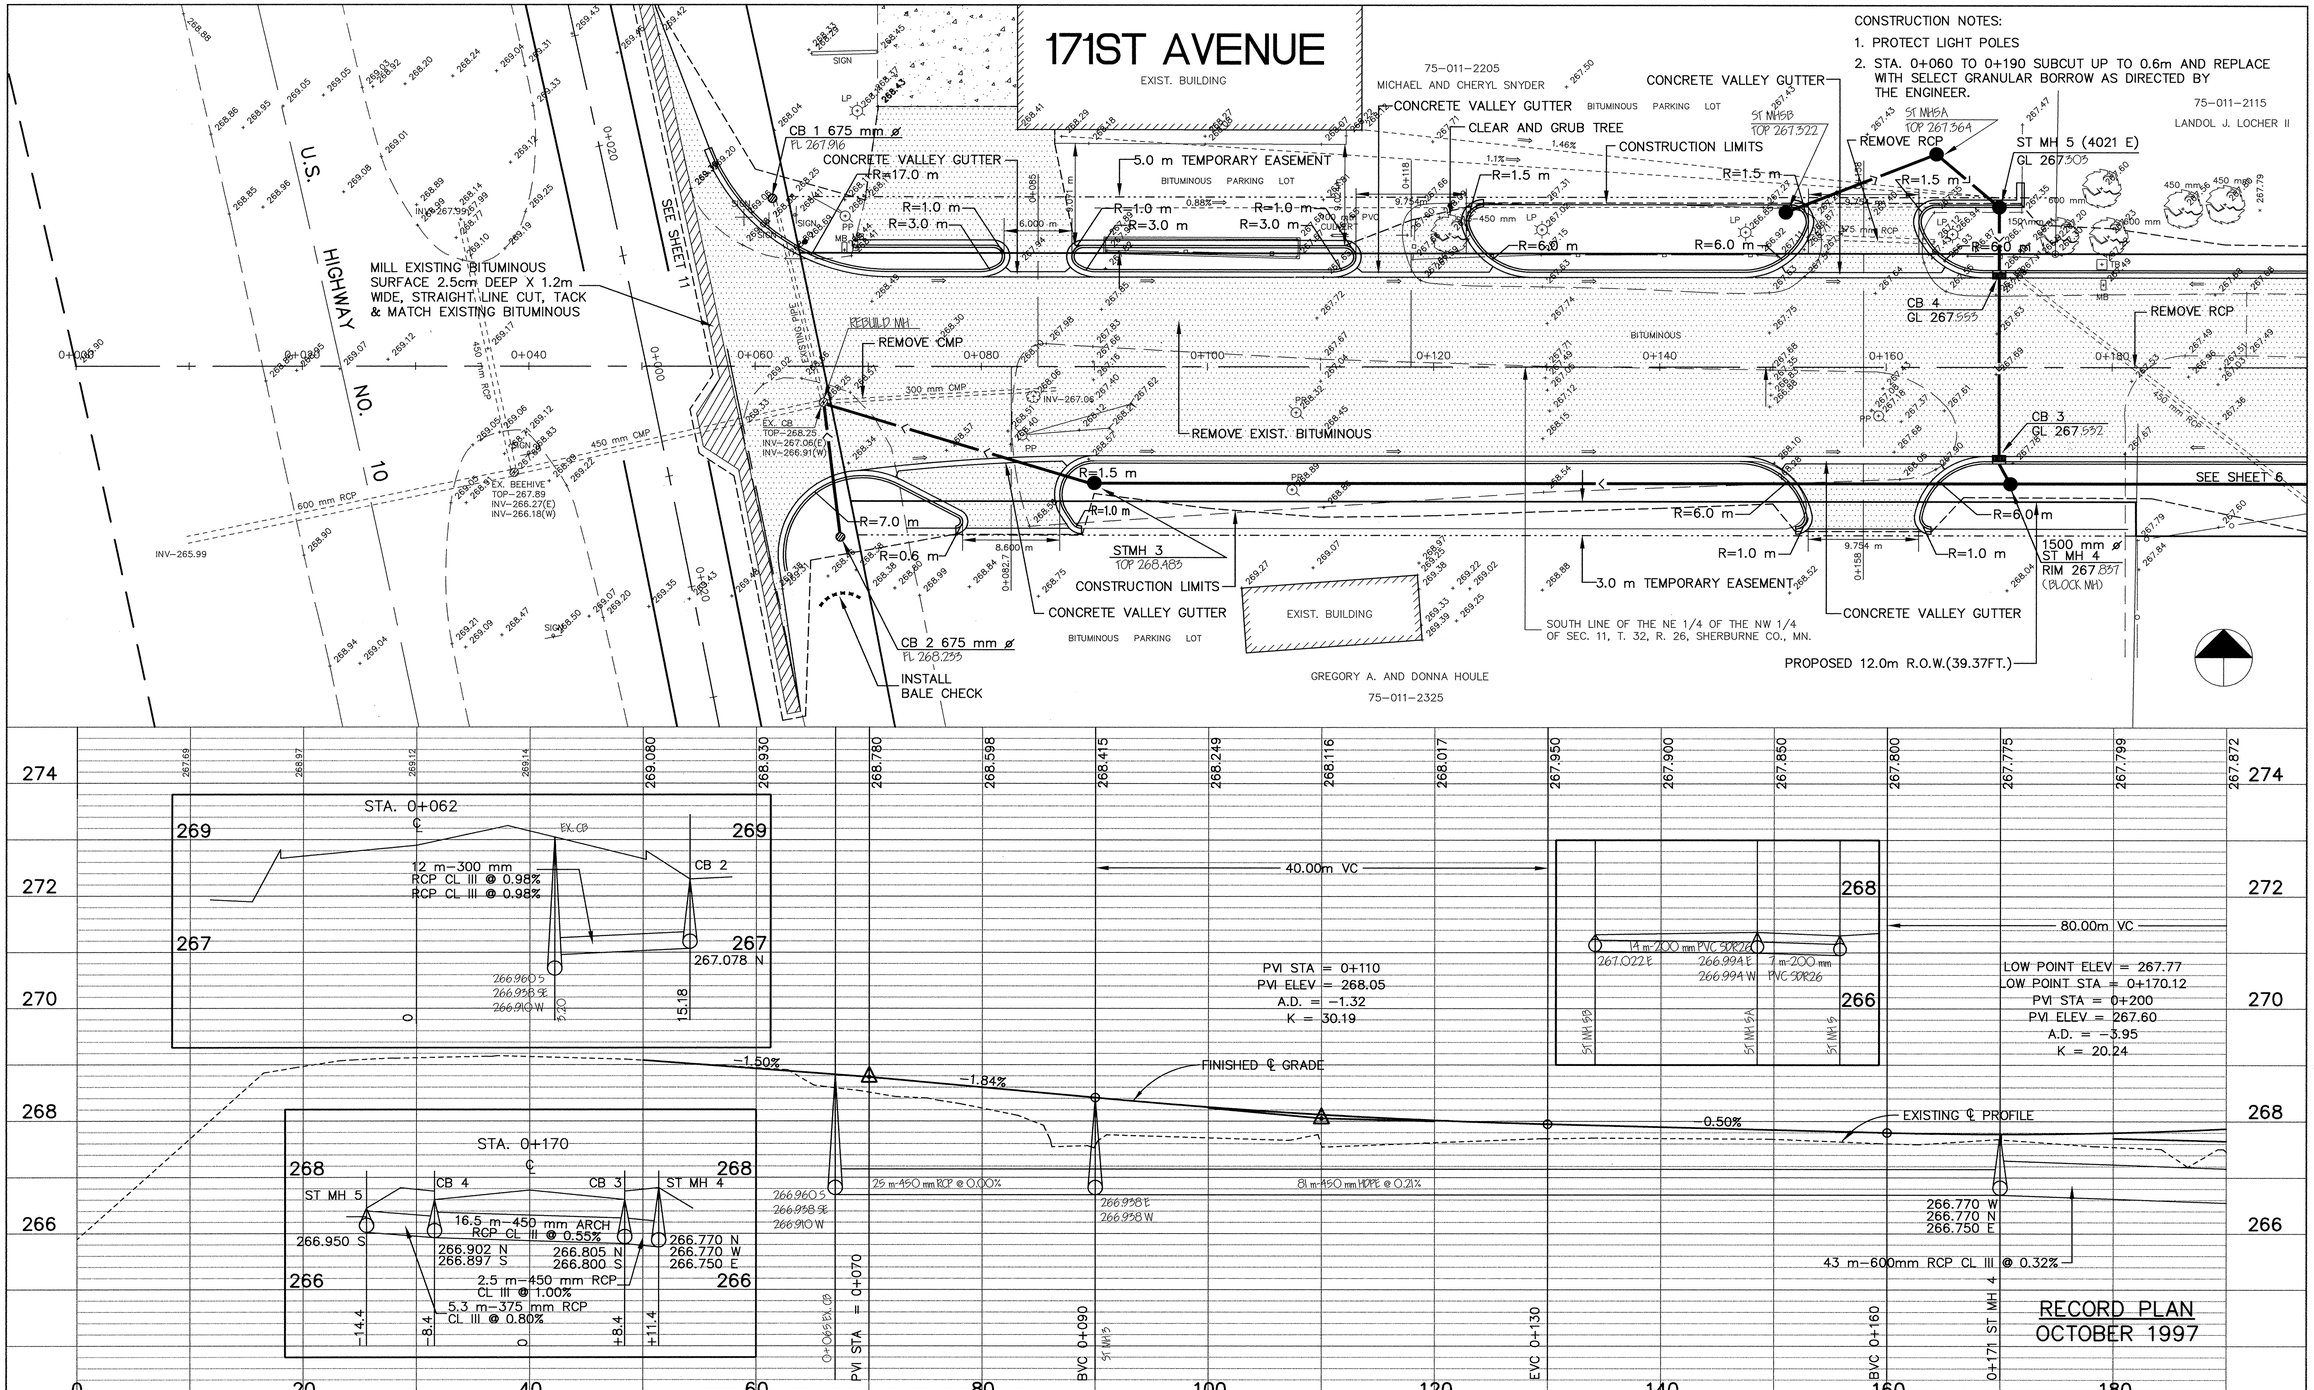

CONSTRUCTION NOTES:

1. PROTECT LIGHT POLES
2. STA. 0+060 TO 0+190 SUBCUT UP TO 0.6m AND REPLACE WITH SELECT GRANULAR BORROW AS DIRECTED BY THE ENGINEER.

I HEREBY CERTIFY THAT THIS PLAN, SPECIFICATION, OR REPORT WAS PREPARED BY ME OR UNDER MY DIRECT SUPERVISION AND THAT I AM A DULY REGISTERED PROFESSIONAL ENGINEER UNDER THE LAWS OF THE STATE OF MINNESOTA.

DATE 7/23/96 REG.NO. 15316

MSA CONSULTING ENGINEERS

1326 ENERGY PARK DRIVE
ST. PAUL, MINNESOTA 55108
(612) 644-4389

REVISIONS | DATE | DESCRIPTION

DESIGN ___ DRAWN ___
CHECKED ___
GRAPHIC SCALES
0 HORIZ (M) 10 — 1:250
0 VERT (M) 2 — 1:50

CITY OF ELK RIVER
171ST AVENUE
STORM SEWER AND STREET CONSTRUCTION
171ST AVENUE

S.A.P. 204-132-01 STA 0+000 TO STA 0+190

DATE JULY 1996 | SHEET 5 OF 25 SHEETS | PROJECT NO. 230-313-20

ER313-A

DRAWING NUMBER
171AV.96
5

1175

D:\CAD\ElkRiver\ER313\Er313-a.dwg Tue Dec 09 16:13:23 1997