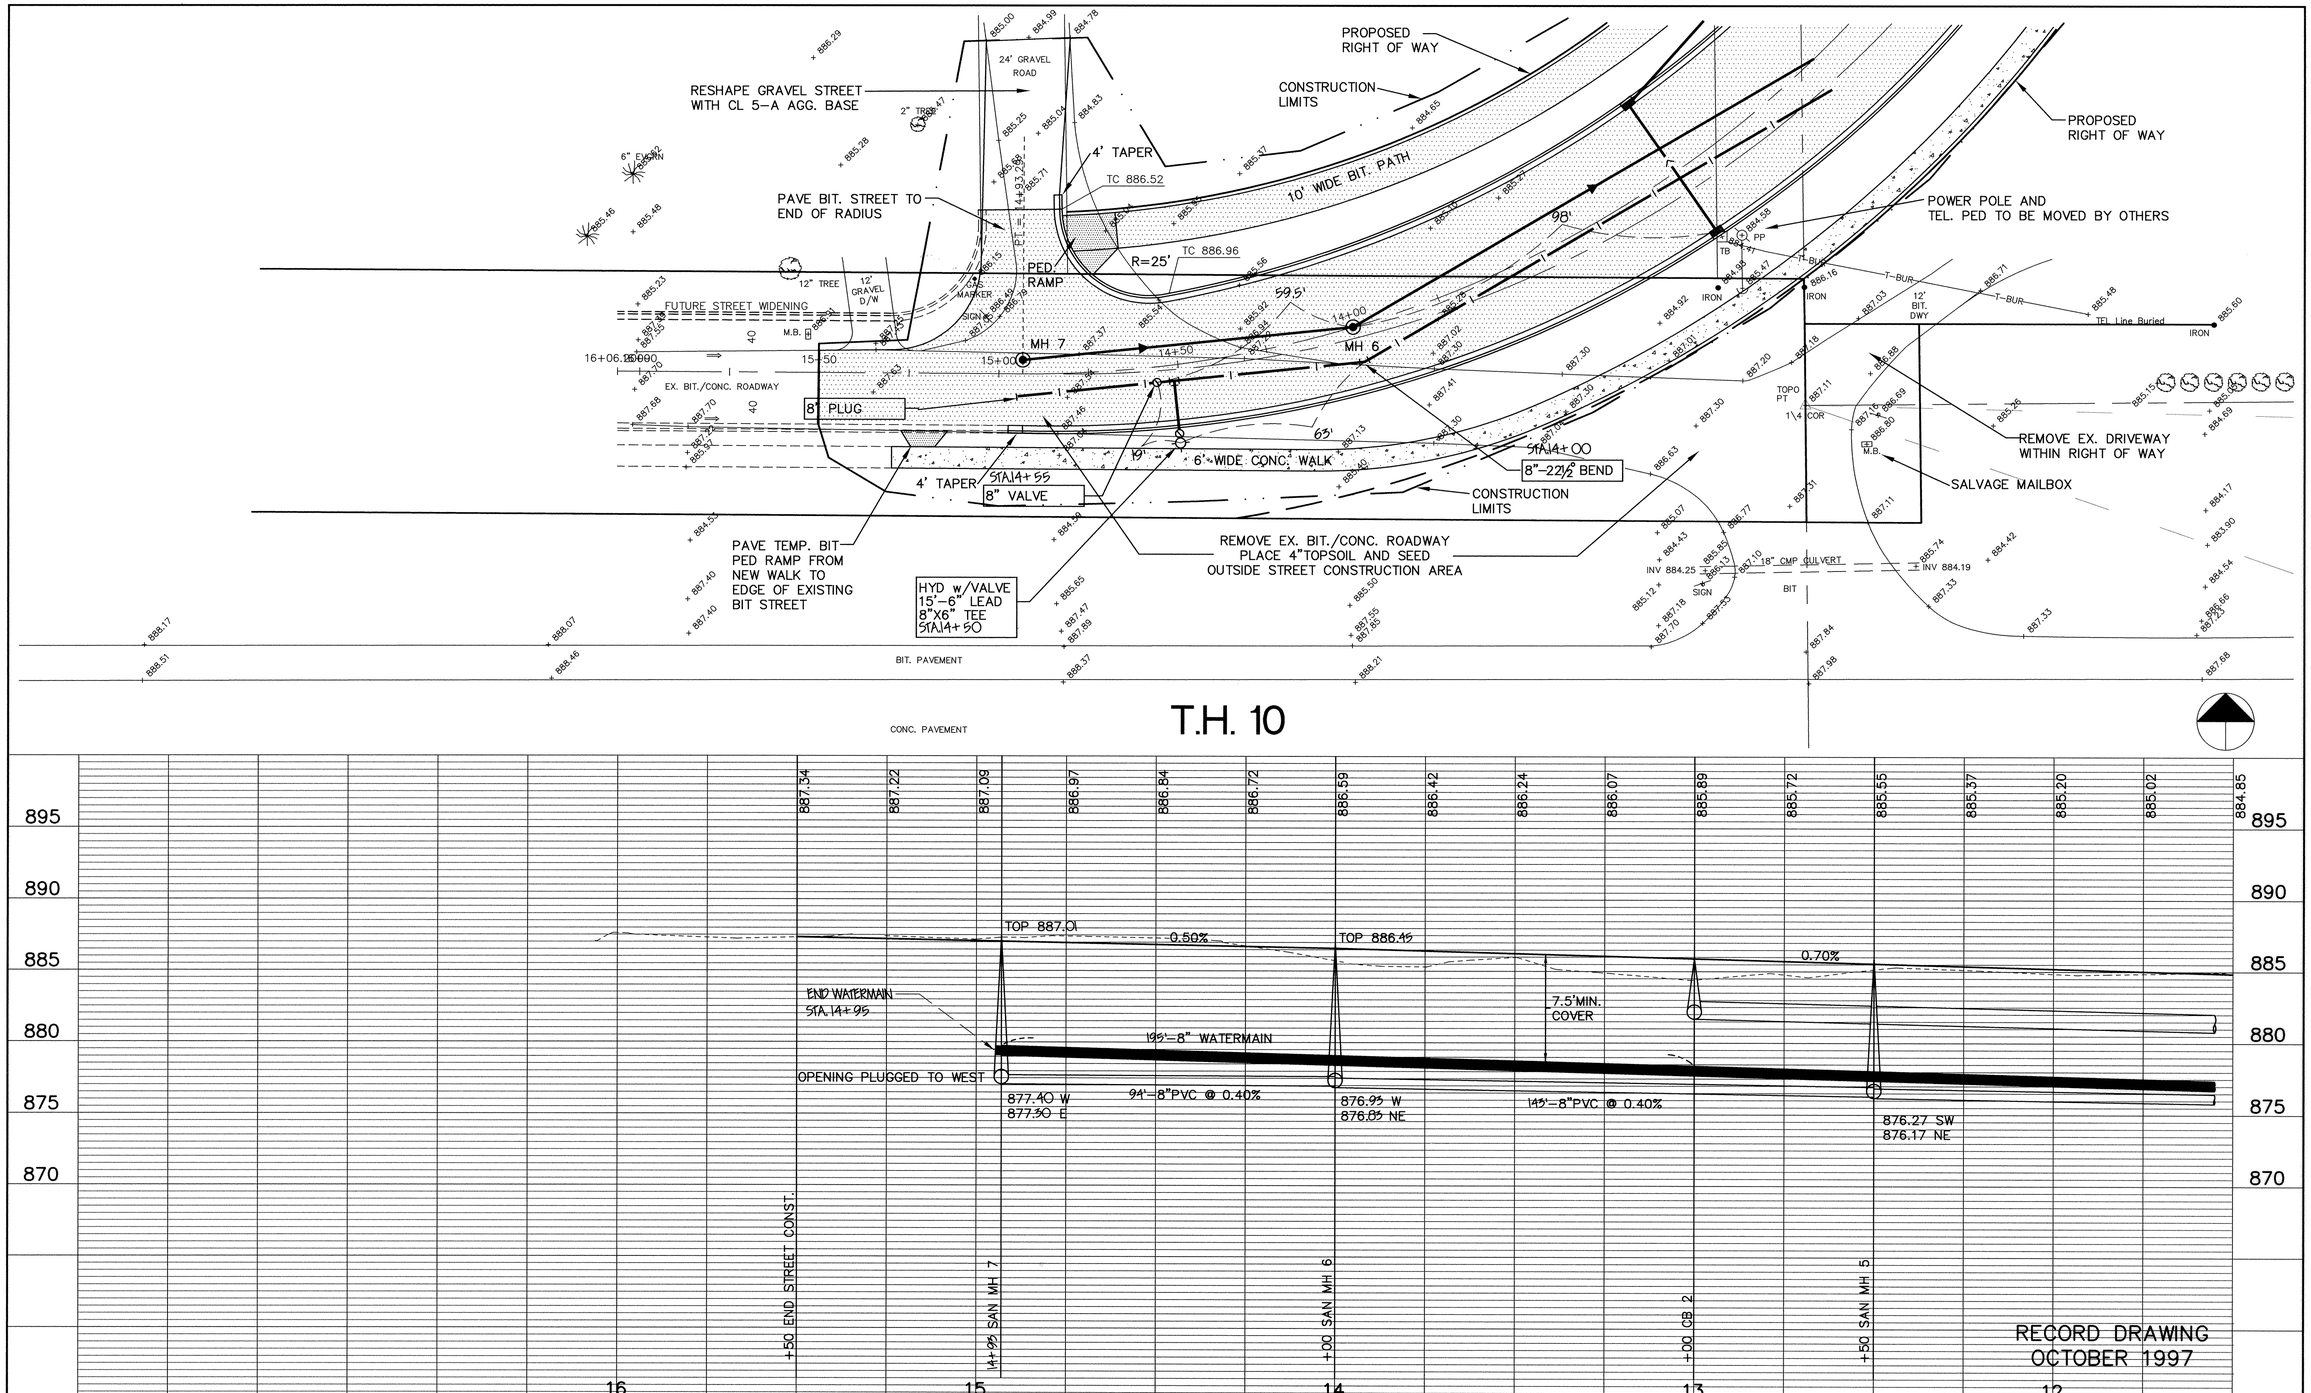

I HEREBY CERTIFY THAT THIS PLAN, SPECIFICATION, OR REPORT WAS PREPARED BY ME OR UNDER MY DIRECT SUPERVISION AND THAT I AM A DULY REGISTERED PROFESSIONAL ENGINEER UNDER THE LAWS OF THE STATE OF MINNESOTA.

DATE 3/29/96 REG.NO. 15316

MSA CONSULTING ENGINEERS

1326 ENERGY PARK DRIVE
ST. PAUL, MINNESOTA 55108
(612) 644-4389

5075 WAYZATA BLVD. SUITE #225
MINNEAPOLIS, MINNESOTA 55416
(612) 546-0432

REVISIONS

DATE	DESCRIPTION
3/22/96	PER MNDOT REVIEW

DESIGNED SF
CHECKED
DRAWN JL
GRAPHIC SCALE 0 20 / 0 VERT. 5

CITY OF ELK RIVER
185TH AVENUE
STREET CONSTRUCTION
T.H. 10 TO NAPLES ST.

S.P. 7102-87(TH 10) 14+00 TO 15+30

DATE JAN 1996 | SHEET 16 OF 41 SHEETS | PROJECT NO. 230-277

ER277-4

1231

DRAWING NUMBER



185AV.96
16

O:\CAD\ElkRiver\ER277\Er277-4.dwg Wed Nov 12 09:23:58 1997