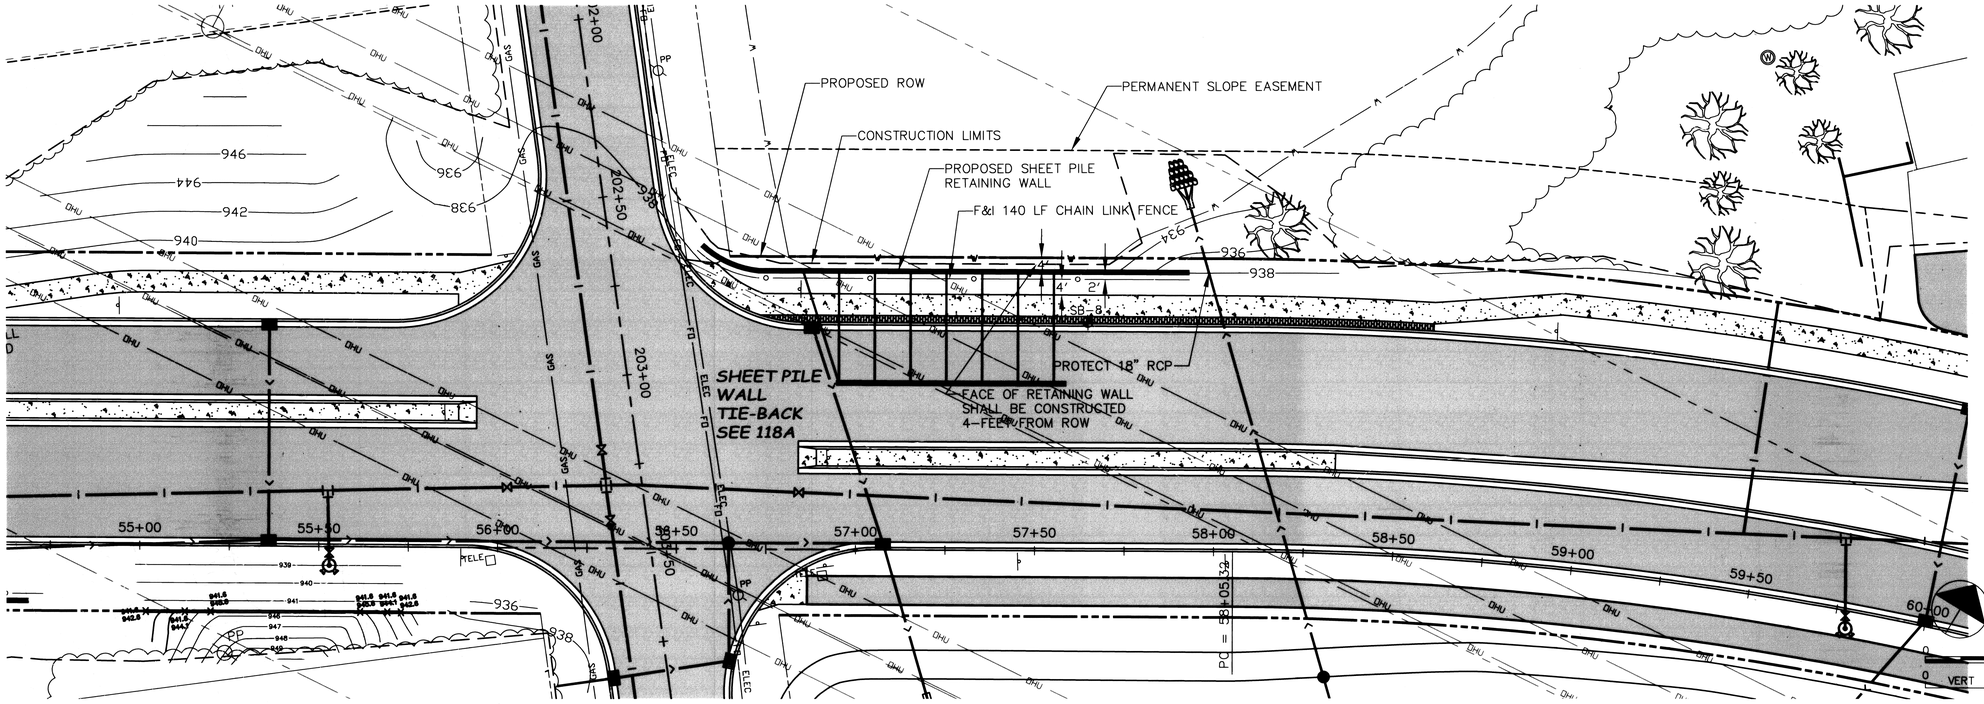

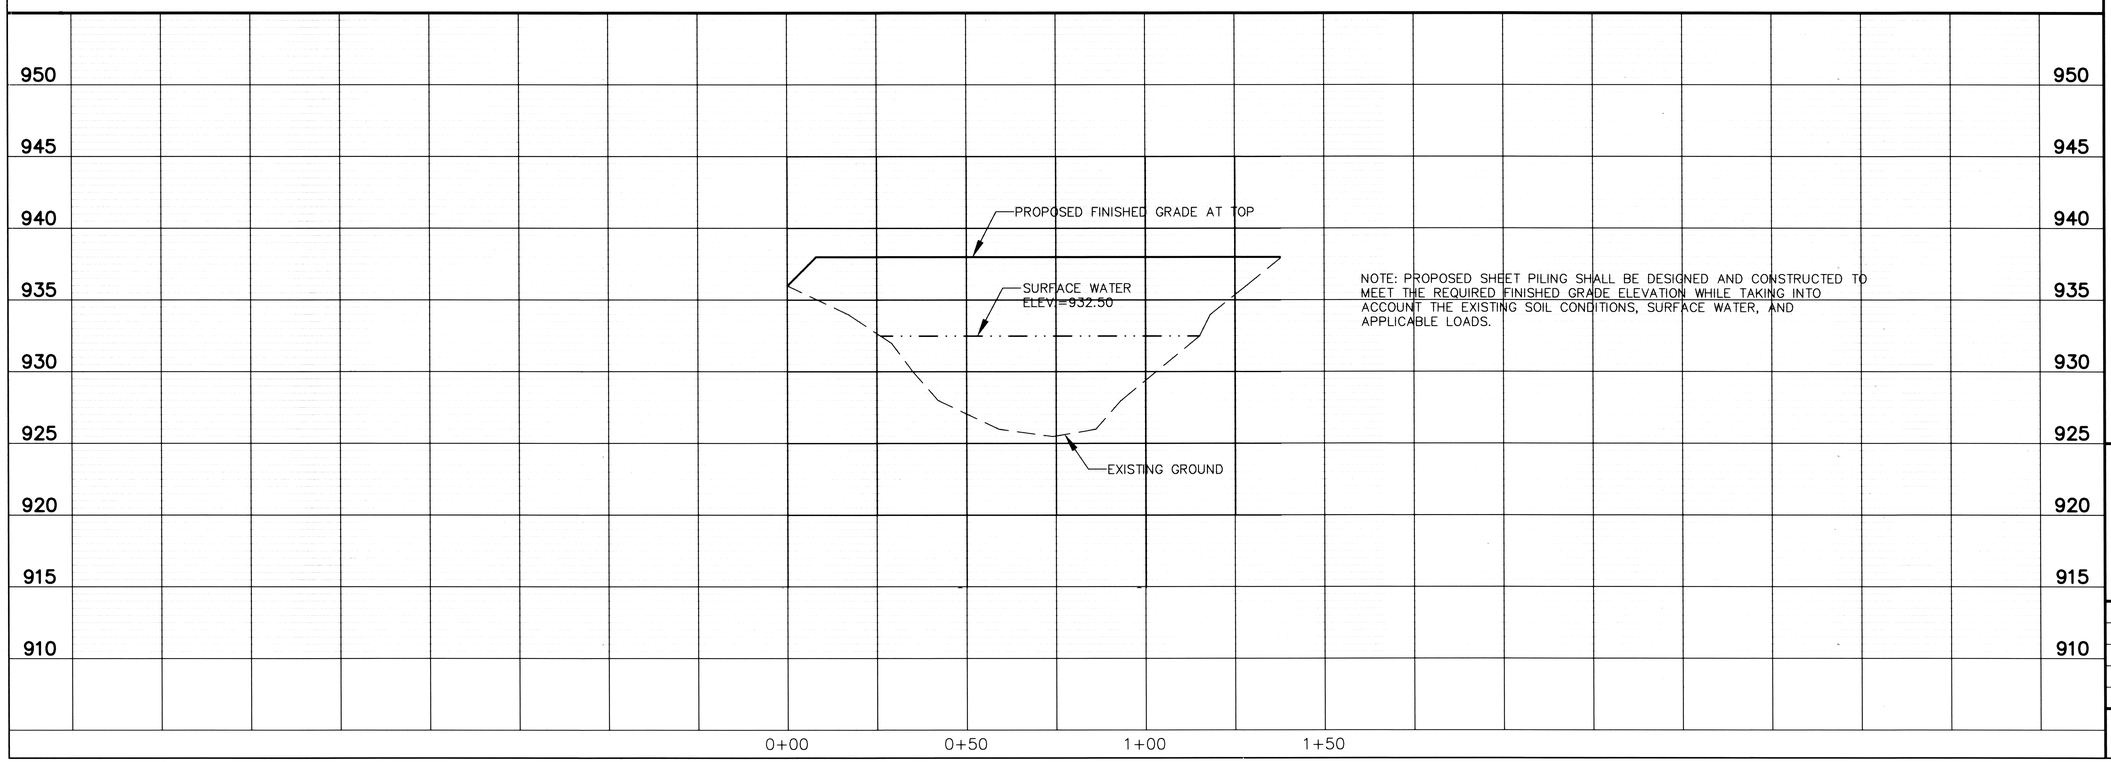

NOTE: PROPOSED SHEET PILING SHALL BE DESIGNED AND CONSTRUCTED TO MEET THE REQUIRED FINISHED GRADE ELEVATION WHILE TAKING INTO ACCOUNT THE EXISTING SOIL CONDITIONS, SURFACE WATER, AND APPLICABLE LOADS.

REVISIONS			
NO.	DATE	BY	DESCRIPTION
1	09/30/08	NAB	ADDENDUM #1
2	11/25/10	JA	RECORD DRAWING

I HEREBY CERTIFY THAT THIS PLAN, SPECIFICATION, OR REPORT WAS PREPARED BY ME OR UNDER MY DIRECT SUPERVISION AND THAT I AM A DULY LICENSED PROFESSIONAL ENGINEER UNDER THE LAWS OF THE STATE OF MINNESOTA.

Print Name: JOHN M. ANDERSON

Signature: _____

Date: 09-30-08 License # 25889

SP 204-104-07

CITY OF ELK RIVER
193RD AVENUE STREET CONSTRUCTION
RETAINING WALL PLANS
193RD AVENUE

56+57 TO 58+32

BDM
CONSULTING ENGINEERS, PLC
Engineers and Surveyors
11040 183rd Circle NW
Elk River, MN 55330
Phone: (763) 441-0877
Fax: (763) 441-7724
bdmce.com

DRAWN BY: NAB
CHECKED BY: KJE
DESIGNED BY: KJE
JOB NO. 226069D

SHEET 118 | SHEETS 146