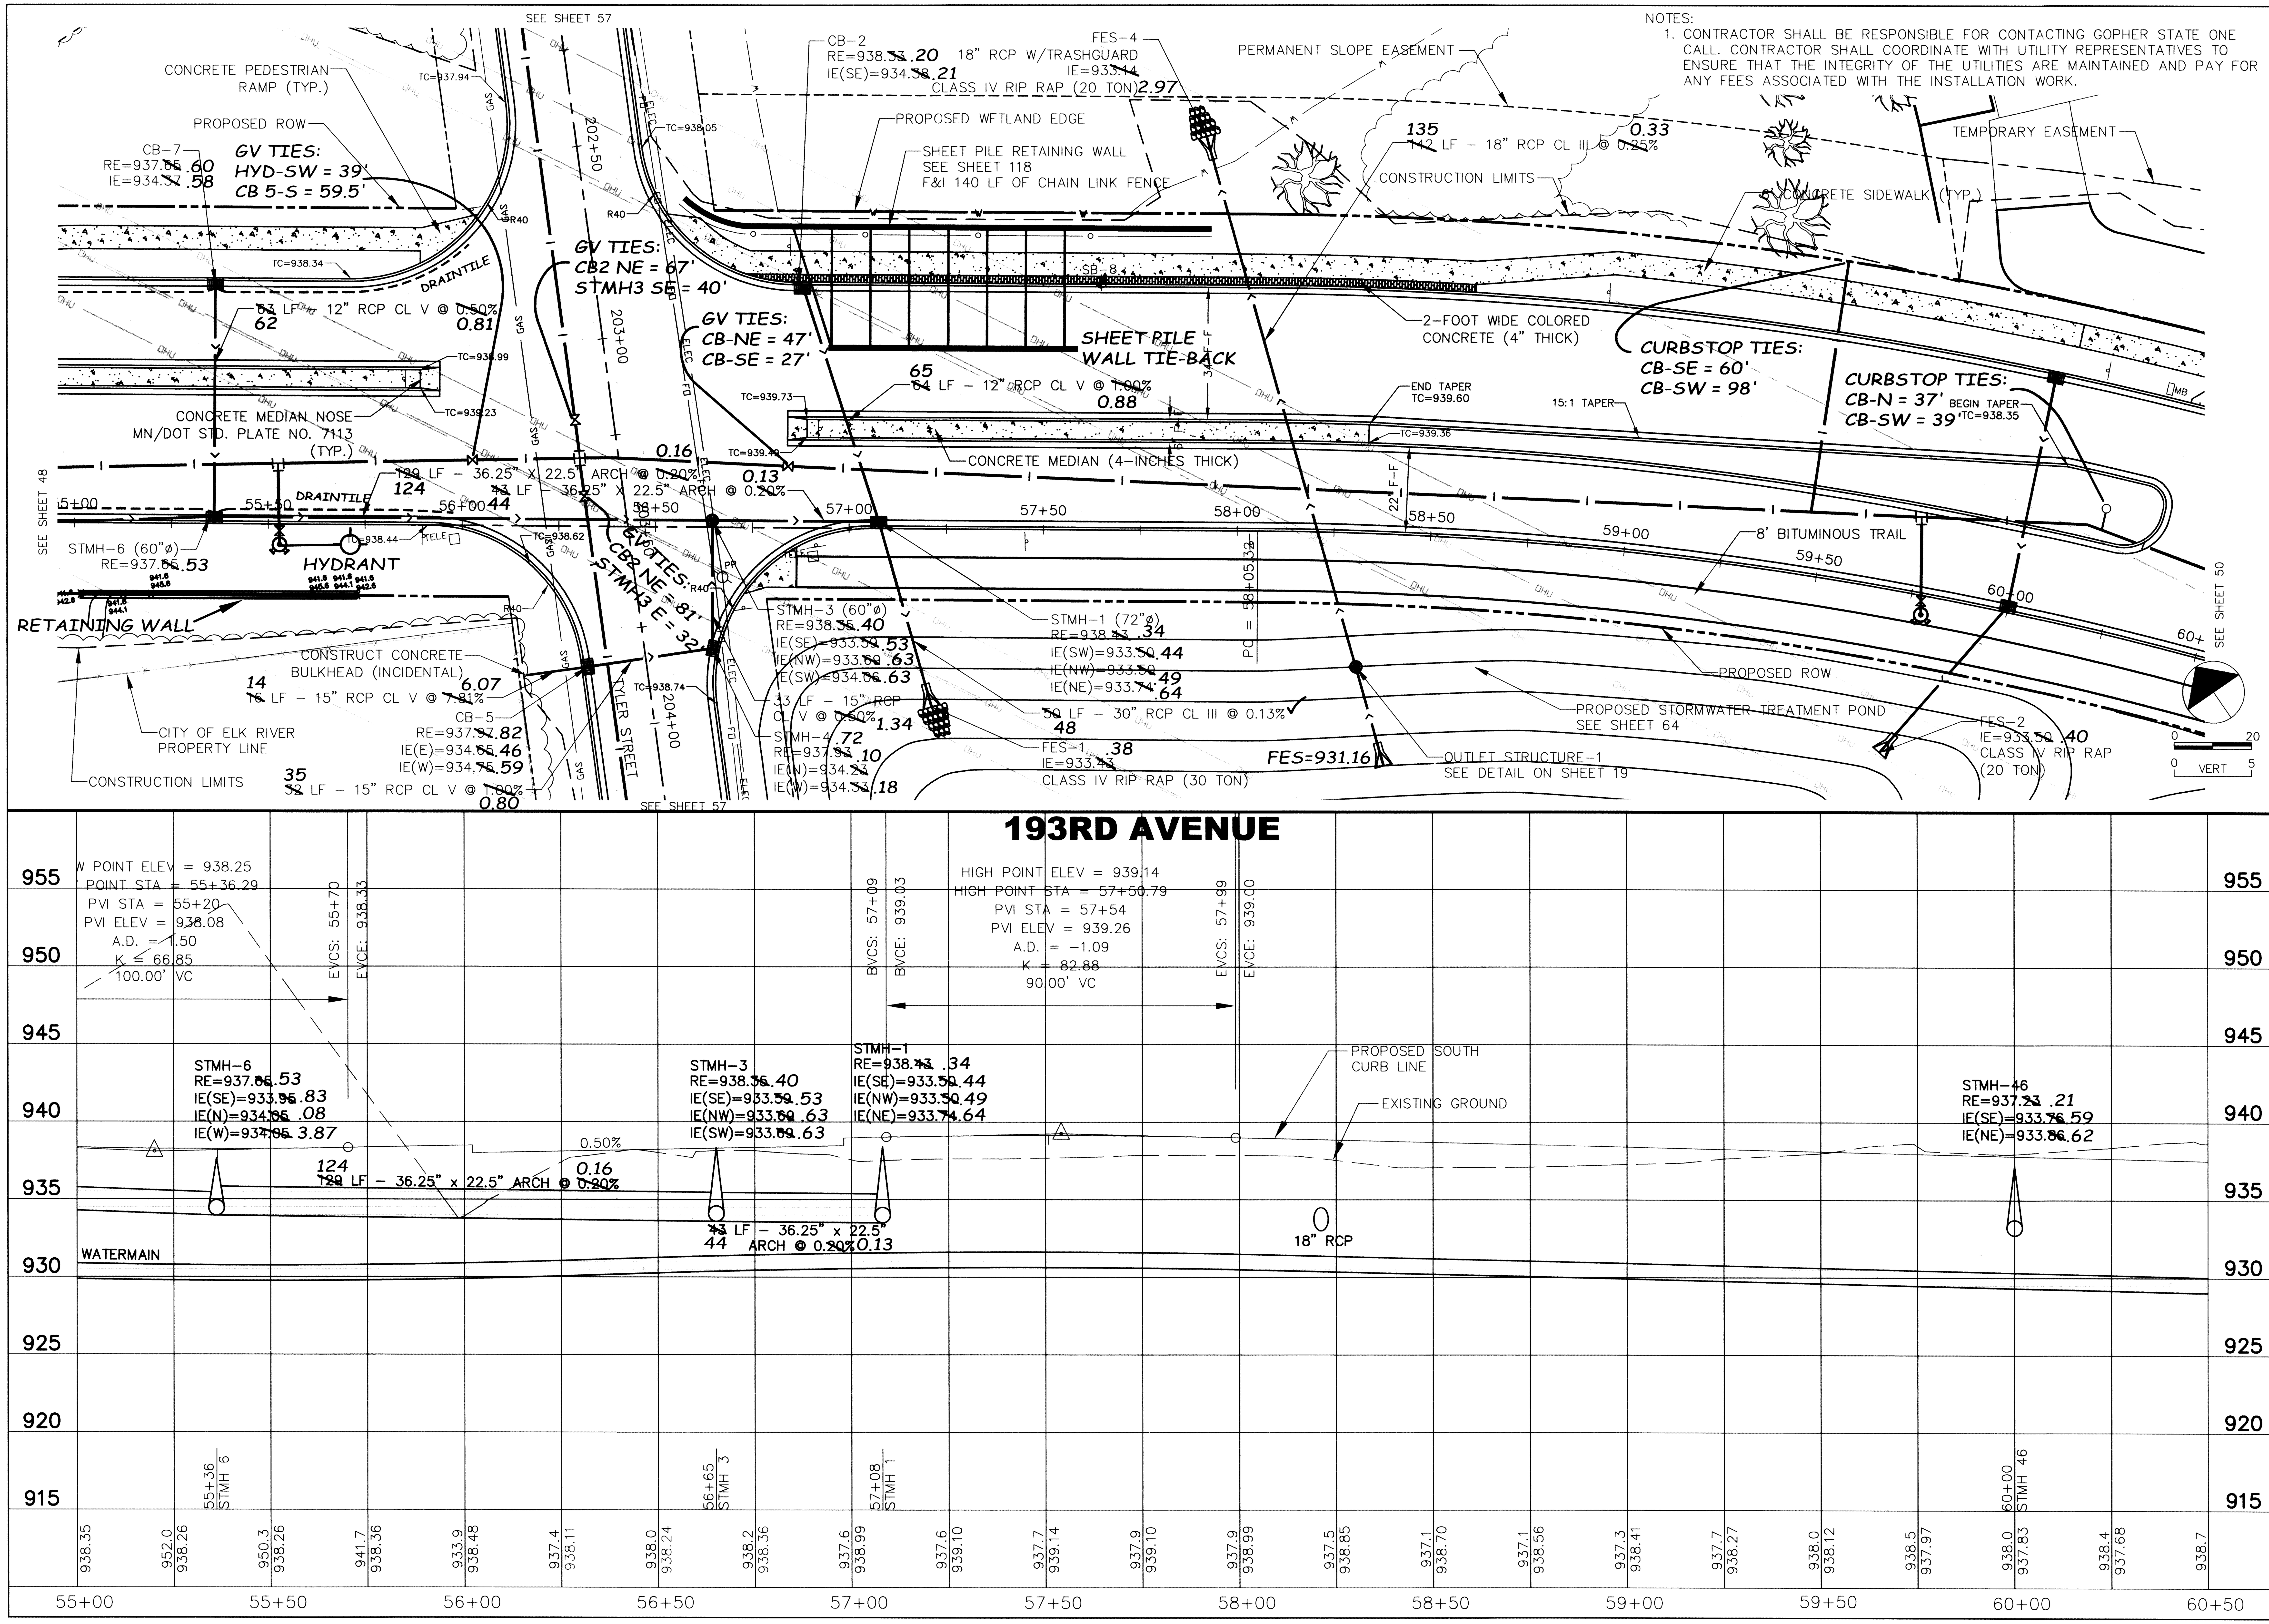

NOTES:
1. CONTRACTOR SHALL BE RESPONSIBLE FOR CONTACTING GOPHER STATE ONE CALL. CONTRACTOR SHALL COORDINATE WITH UTILITY REPRESENTATIVES TO ENSURE THAT THE INTEGRITY OF THE UTILITIES ARE MAINTAINED AND PAY FOR ANY FEES ASSOCIATED WITH THE INSTALLATION WORK.

REVISIONS

NO.	DATE	BY	DESCRIPTION
1	09/30/08	NAB	ADDENDUM #1
2	**1/25/10**	**JA**	**RECORD DRAWING**

I HEREBY CERTIFY THAT THIS PLAN, SPECIFICATION, OR REPORT WAS PREPARED BY ME OR UNDER MY DIRECT SUPERVISION AND THAT I AM A DULY LICENSED PROFESSIONAL ENGINEER UNDER THE LAWS OF THE STATE OF MINNESOTA.

Print Name:: JOHN M. ANDERSON

Signature: ____

Date: 09-30-08 License # 25889

SP 204-104-07

CITY OF ELK RIVER
193RD AVENUE STREET CONSTRUCTION
STREET AND STORM SEWER 193RD AVENUE
RECORD PLAN

55+50 TO 60+00

BDM
CONSULTING ENGINEERS, PLC
Engineers and Surveyors
11040 183rd Circle NW
Elk River, MN 55330
Phone: (763) 441-0877
Fax: (763) 441-7724
bdmce.com

DRAWN BY: NAB
CHECKED BY: KJE
DESIGNED BY: KJE
JOB NO. 226069D