NOTES:
1. CONTRACTOR SHALL BE RESPONSIBLE FOR CONTACTING GOPHER STATE ONE CALL. CONTRACTOR SHALL COORDINATE WITH UTILITY REPRESENTATIVES TO ENSURE THAT THE INTEGRITY OF THE UTILITIES ARE MAINTAINED AND PAY FOR ANY FEES ASSOCIATED WITH THE INSTALLATION WORK.
2. ANY BITUMINOUS DAMAGED BEYOND REMOVAL LIMITS ON TYLER STREET SHALL BE REPLACED BY THE CONTRACTOR TO THE SATISFACTION OF THE ENGINEER IN THE FIELD AT NO ADDITIONAL COST TO THE OWNER.

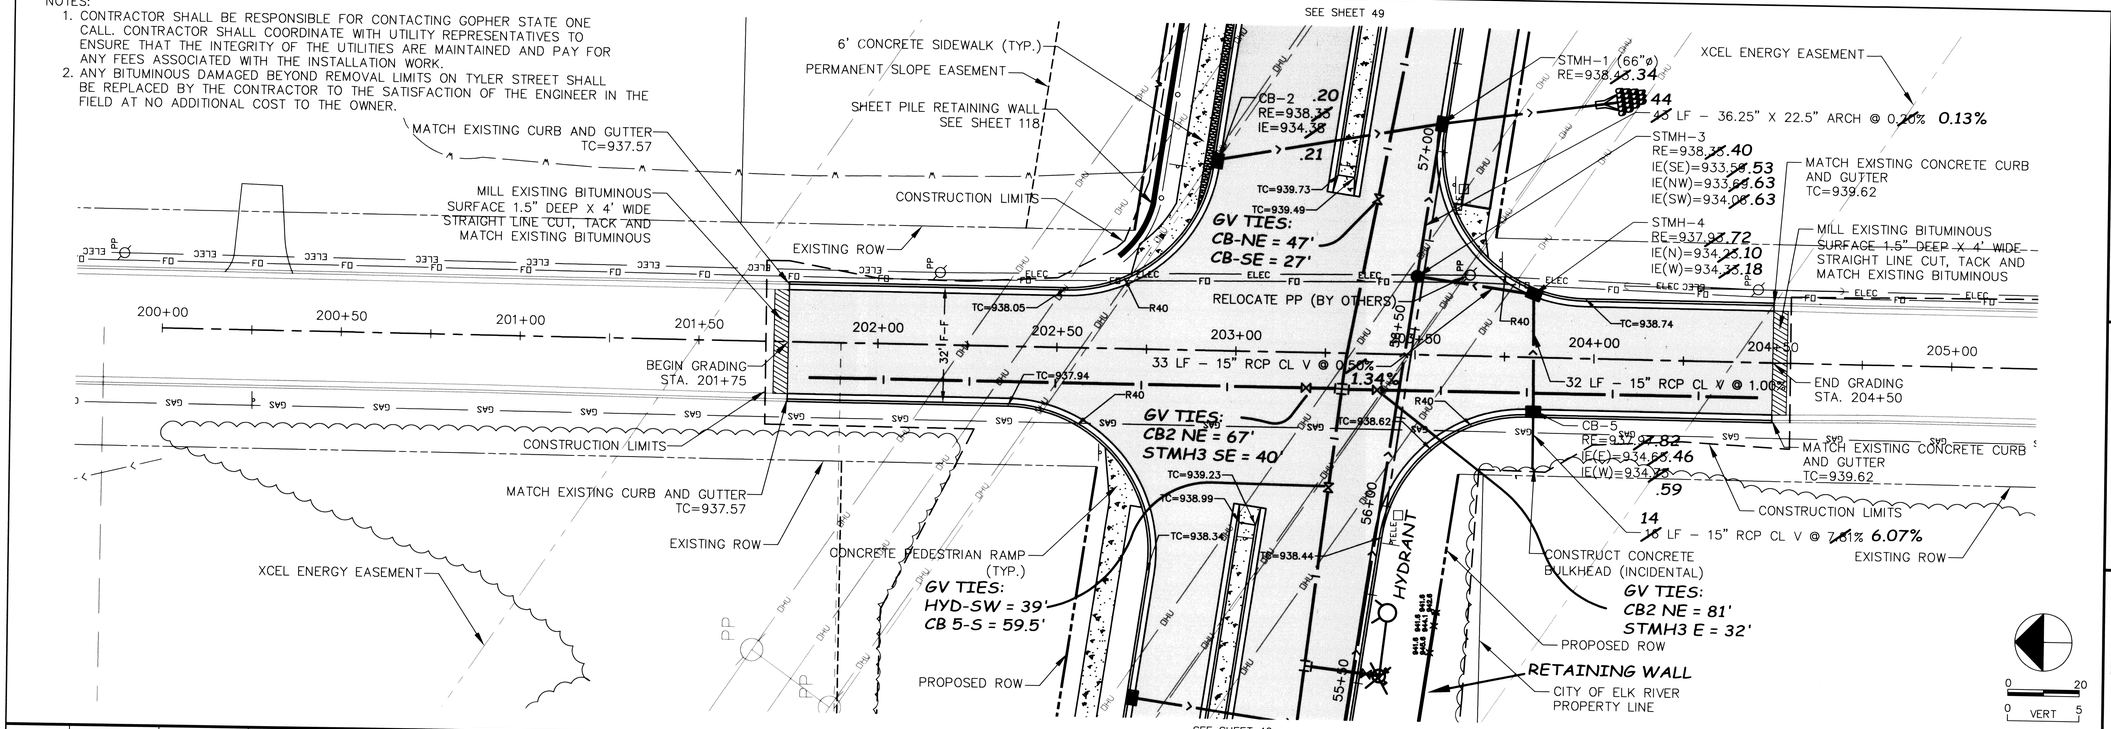

TYLER STREET

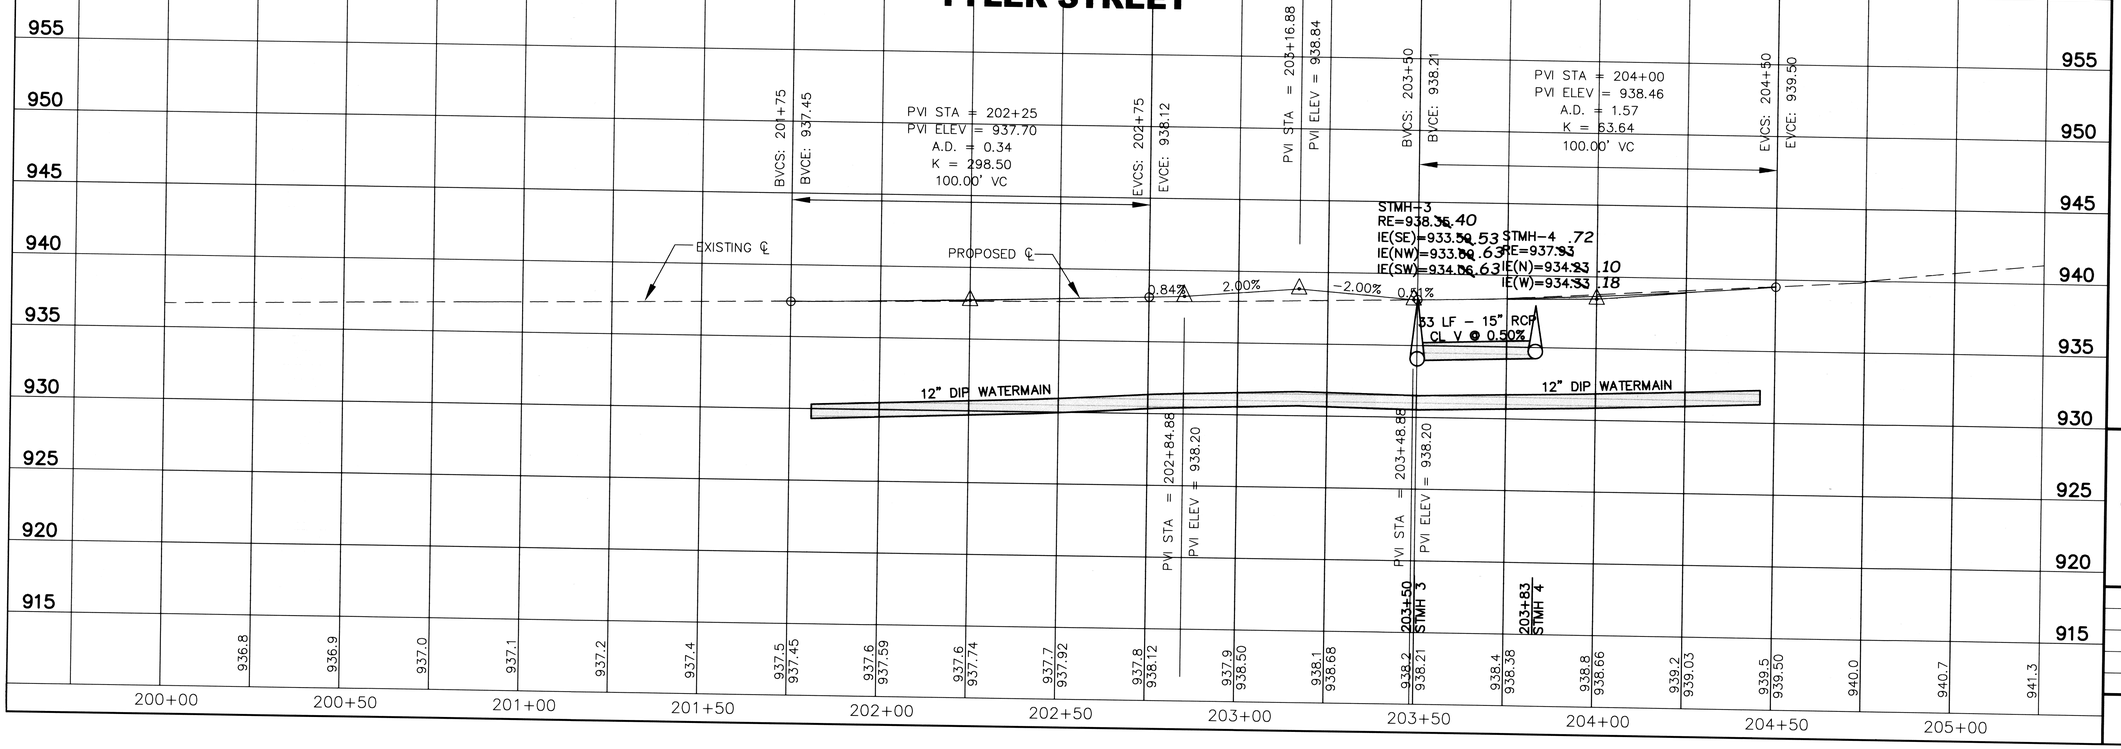

REVISIONS			
NO.	DATE	BY	DESCRIPTION
1	09/30/08	NAB	ADDENDUM #1
2	11/25/10	JA	RECORD DRAWING

I HEREBY CERTIFY THAT THIS PLAN, SPECIFICATION, OR REPORT WAS PREPARED BY ME OR UNDER MY DIRECT SUPERVISION AND THAT I AM A DULY LICENSED PROFESSIONAL ENGINEER UNDER THE LAWS OF THE STATE OF MINNESOTA.

Print Name: JOHN M. ANDERSON

Signature: _____

Date: 09-30-08 License # 25889

SP 204-104-07

CITY OF ELK RIVER
193RD AVENUE STREET CONSTRUCTION
STREET AND STORM SEWER
TYLER STREET
RECORD PLAN

200+00 TO 205+00

BDM
CONSULTING ENGINEERS, PLC
Engineers and Surveyors
11040 183rd Circle NW
Elk River, MN 55330
Phone: (763) 441-0877
Fax: (763) 441-7724
bdmce.com

DRAWN BY:	NAB
CHECKED BY:	KJE
DESIGNED BY:	KJE
JOB NO.	226069D

SHEET	SHEETS
57	146