SEE SHEET 68

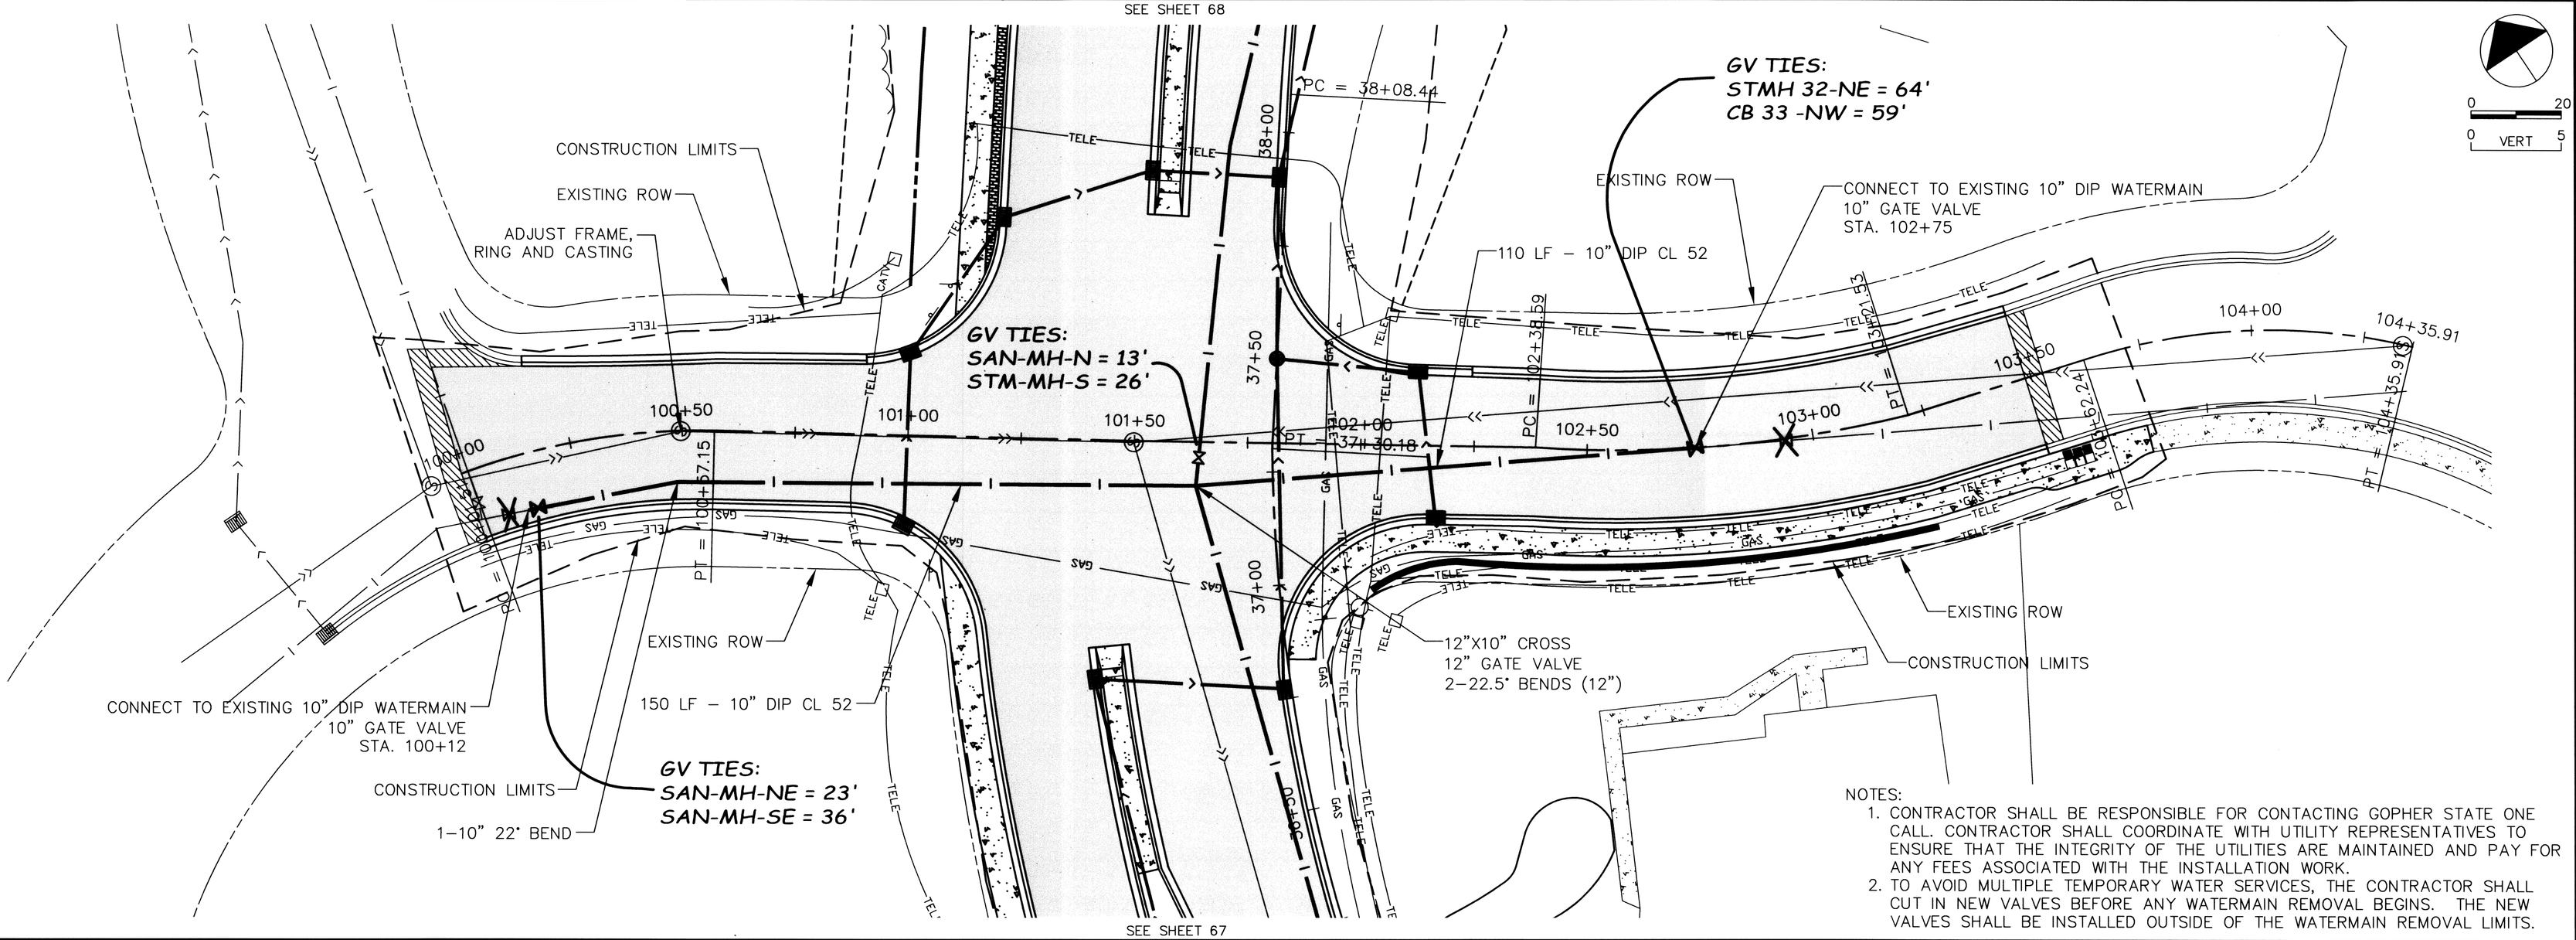

NOTES:
1. CONTRACTOR SHALL BE RESPONSIBLE FOR CONTACTING GOPHER STATE ONE CALL. CONTRACTOR SHALL COORDINATE WITH UTILITY REPRESENTATIVES TO ENSURE THAT THE INTEGRITY OF THE UTILITIES ARE MAINTAINED AND PAY FOR ANY FEES ASSOCIATED WITH THE INSTALLATION WORK.
2. TO AVOID MULTIPLE TEMPORARY WATER SERVICES, THE CONTRACTOR SHALL CUT IN NEW VALVES BEFORE ANY WATERMAIN REMOVAL BEGINS. THE NEW VALVES SHALL BE INSTALLED OUTSIDE OF THE WATERMAIN REMOVAL LIMITS.

SEE SHEET 67

XAVIER STREET

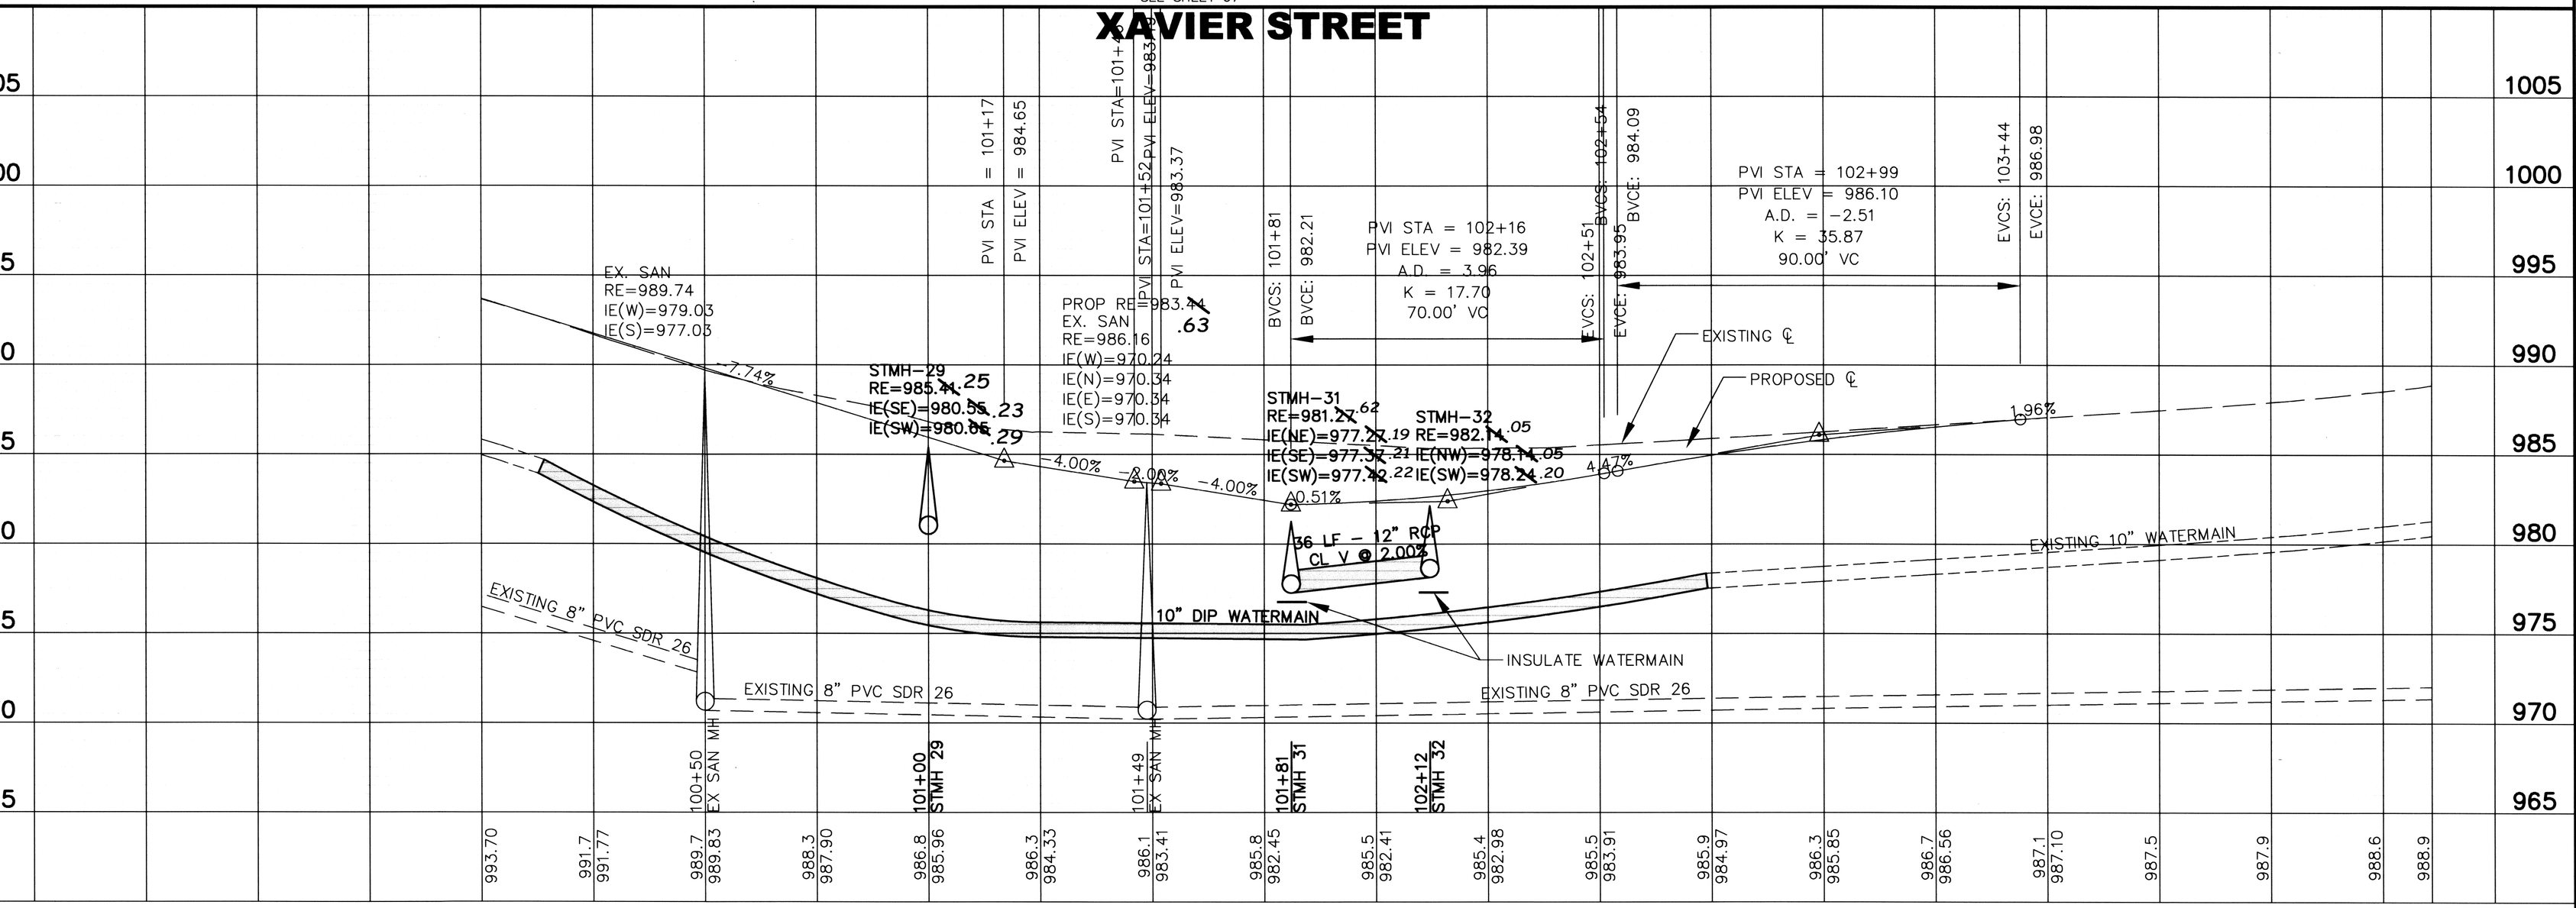

REVISIONS			
NO.	DATE	BY	DESCRIPTION
1	1/25/10	JA	RECORD DRAWING

I HEREBY CERTIFY THAT THIS PLAN, SPECIFICATION, OR REPORT WAS PREPARED BY ME OR UNDER MY DIRECT SUPERVISION AND THAT I AM A DULY LICENSED PROFESSIONAL ENGINEER UNDER THE LAWS OF THE STATE OF MINNESOTA.
Print Name: JOHN M. ANDERSON

SP 204-104-07

CITY OF ELK RIVER
193RD AVENUE STREET CONSTRUCTION

BD
CONSULTING E
Engineers a
11040 183r
Elk River,
Phone: (763
Fax: (763)
bdmc

DRAWN BY:
CHECKED B
DESIGNED B
JOB NO. 2

SHEET
77